

GROUND FLOOR

*ALL DIMENSIONS ARE APPROXIMATE AND SHOULD BE VERIFIED IN FIELD


RETAIL #2

115 E 23rd NEW YORK, NY



AS BUILT

- SCALE: 3/16" = 1'-0"
- JOB NO.: 45119.00
- DRAWN BY: JS
- DATE: 10/06/2025

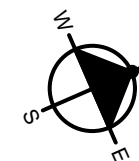


**TULLER
McNEALUS
FELD**

ARCHITECTURE
INTERIOR DESIGN
54 WEST 39 STREET
NEW YORK, NY 10018
TEL: (212) 768-7788

THIS DRAWING IS FOR LEASE AREA CALCULATION PURPOSE ONLY AND NOT TO BE USED FOR ANY CONSTRUCTION DOCUMENTS WITHOUT SITE SURVEY

DO NOT SCALE PRINTS

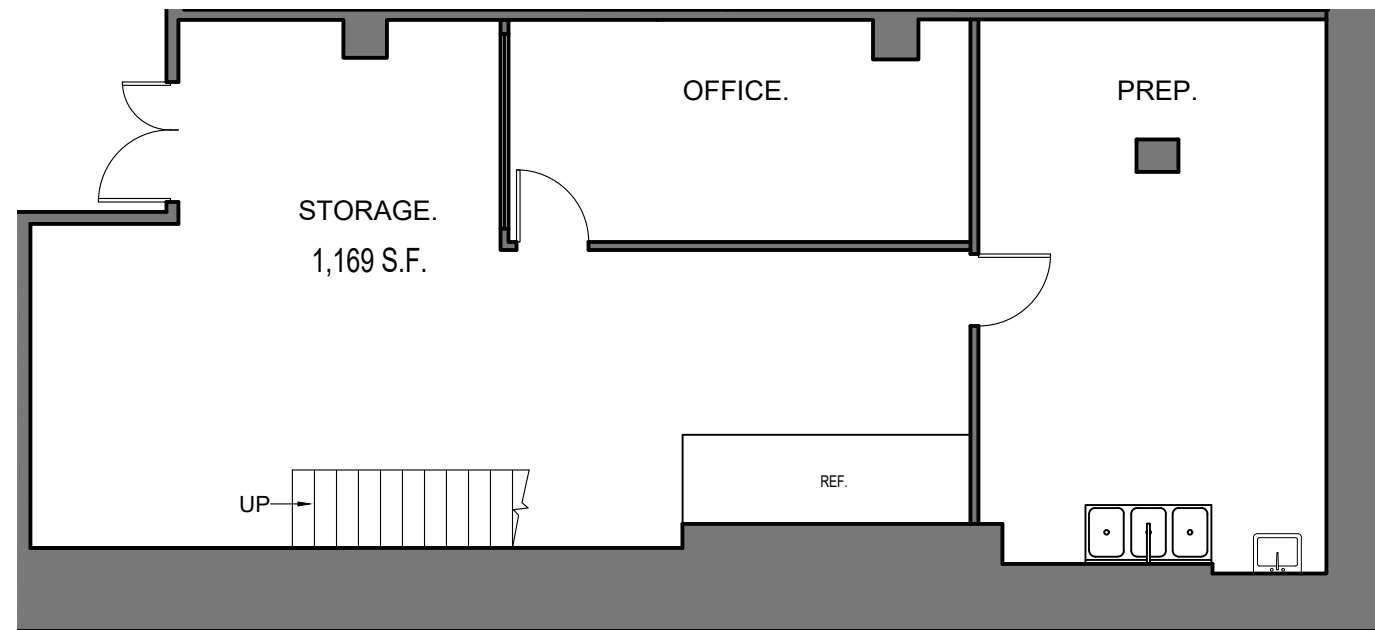

CELLAR

*ALL DIMENSIONS ARE APPROXIMATE AND SHOULD BE VERIFIED IN FIELD


RETAIL #2

115 E 23rd NEW YORK, NY



AS BUILT

- SCALE: 3/16" = 1'-0"
- JOB NO.: 45119.00
- DRAWN BY: JS
- DATE: 10/06/2025

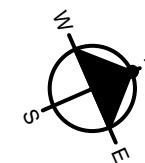

**TULLER
McNEALUS
FELD**
ARCHITECTURE
INTERIOR DESIGN
54 WEST 39 STREET
NEW YORK, NY 10018
TEL: (212) 768-7788

THIS DRAWING IS FOR LEASE AREA CALCULATION PURPOSE ONLY AND NOT TO BE USED FOR ANY CONSTRUCTION DOCUMENTS WITHOUT SITE SURVEY

DO NOT SCALE PRINTS