


## SUITE 5220: 14,708 SF

Includes 2,839 SF Office Space

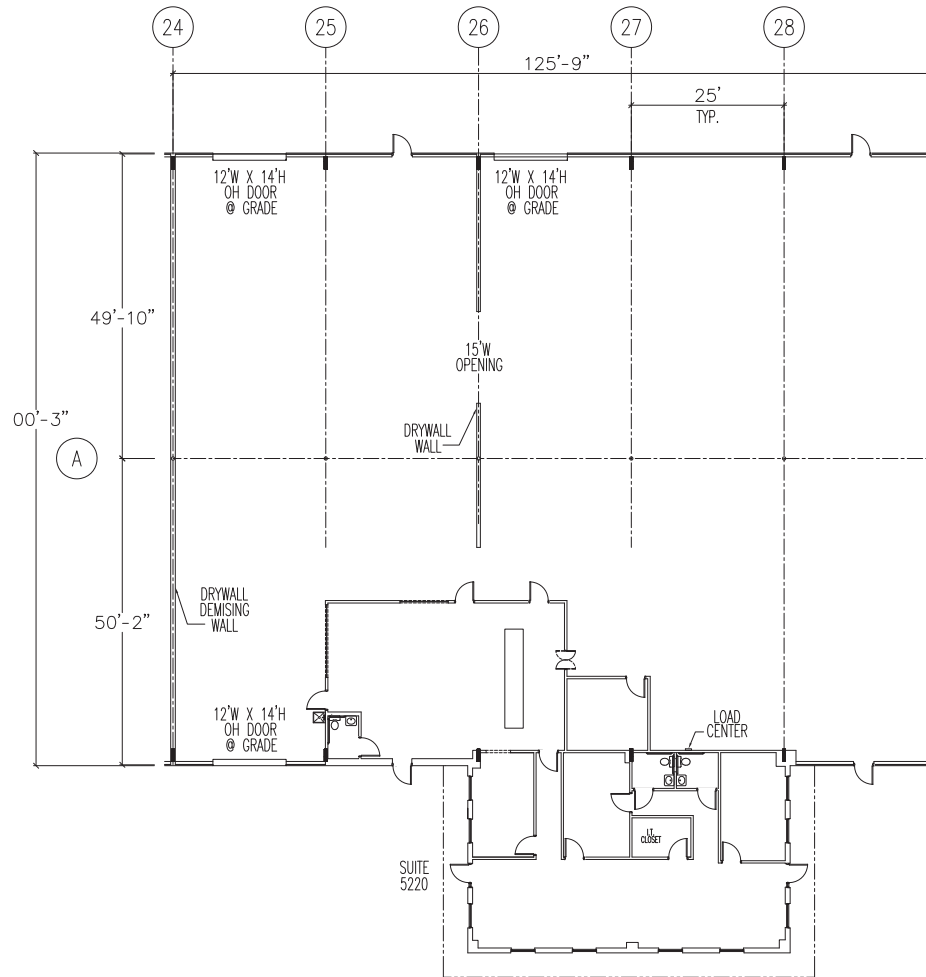

**SUNSHINE INDUSTRIAL PARK**  
5220 126<sup>th</sup> Ave N  
Clearwater, FL 337600

No warranty or representation, expressed or implied, is made to the accuracy of information contained herein, and same is submitted subject to errors, change of price, rental or other conditions, withdrawal without notice, and to any special listing conditions imposed by our principals. PLANS NOT TO SCALE

**BRAD HUTTON**  
813.793.8492  
Brad.Hutton@FranklinSt.com

**PATRICK KELLY**  
813.682.6210  
Pat.Kelly@FranklinSt.com

**REID DOMINGUEZ**  
813.291.2658  
Reid.Dominguez@FranklinSt.com

**FranklinStreet**  
Licensed Real Estate Broker | FranklinSt.com