
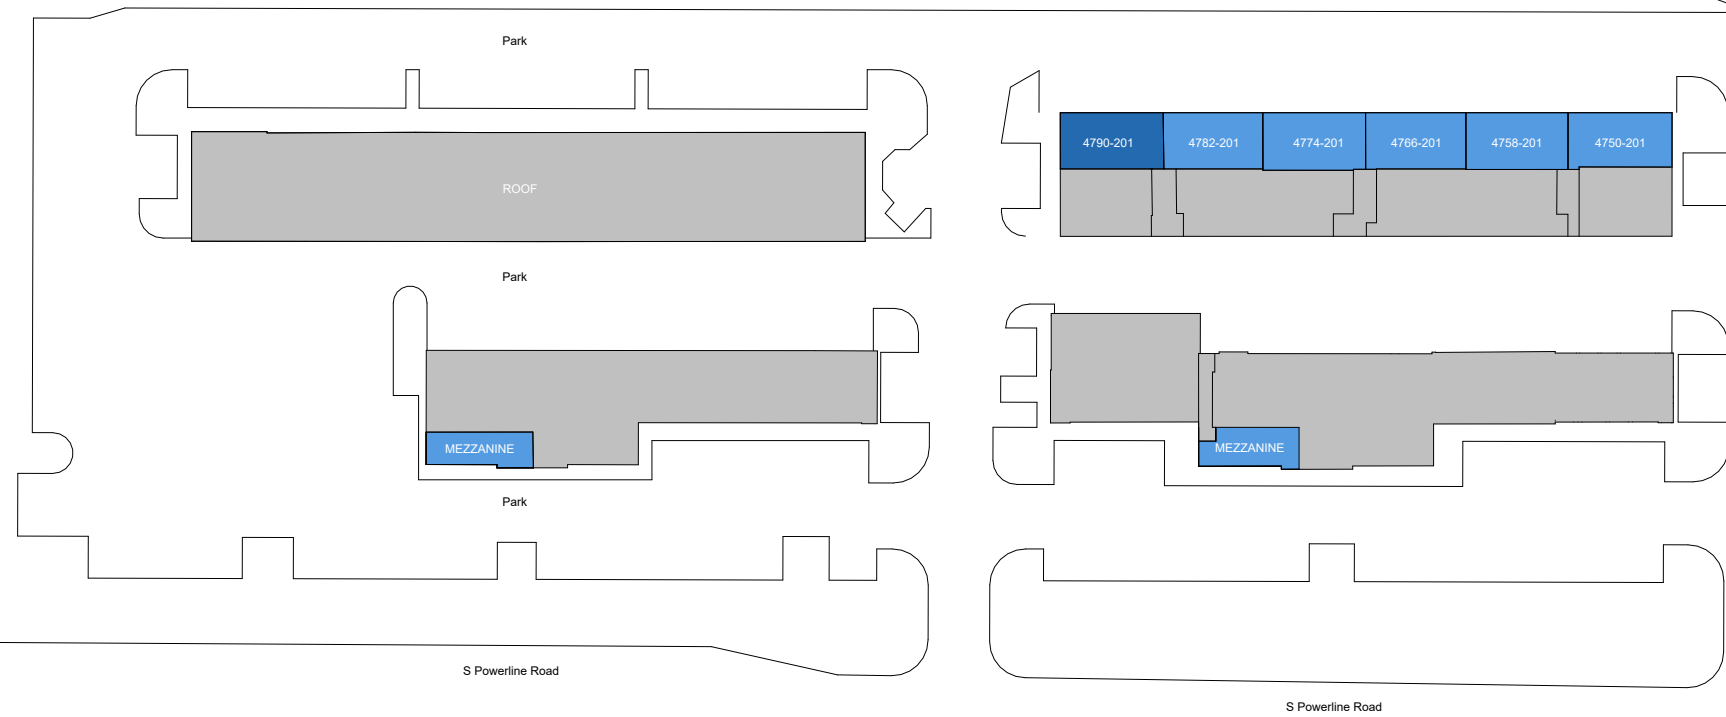


Property Key

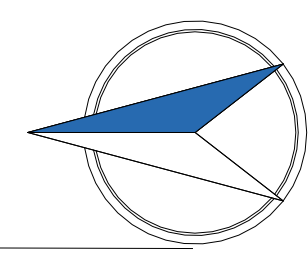


Deerfield

4750 N Powerline Rd, Pompano Beach, 33073 FL

Building: 4750

Suite: 4790-201

Sheet **E1**

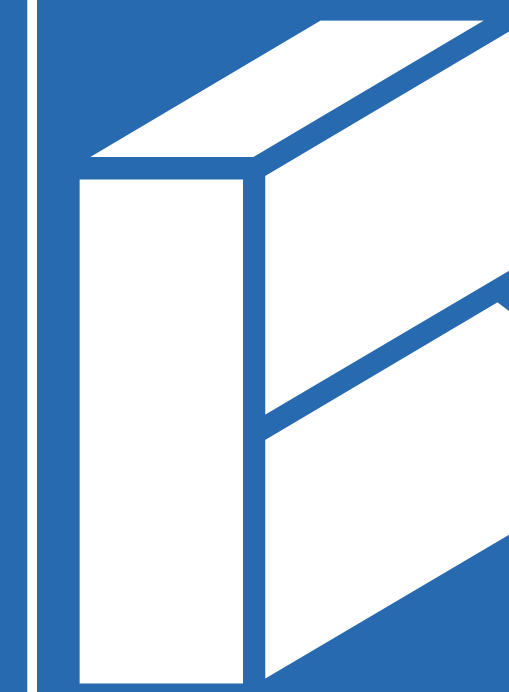

BAY SPACE


Scale: Not to Scale
Sheet Size: 42" x 30"
Not For Construction

Usable Square Foot Analysis

	SQFT	BUILDING PERCENTAGE
Office Area	1,000	100 %
Warehouse Area	0	0 %
Total Area	1,000	

Building Information

Deck Height:	11' - 5 1/2"	
Clear Height:	8' - 5"	
Ceiling Height:	8' - 5"	
Sprinklered:	<input type="checkbox"/> Yes	<input checked="" type="checkbox"/> No
Mechanical Area:	0 SQFT	

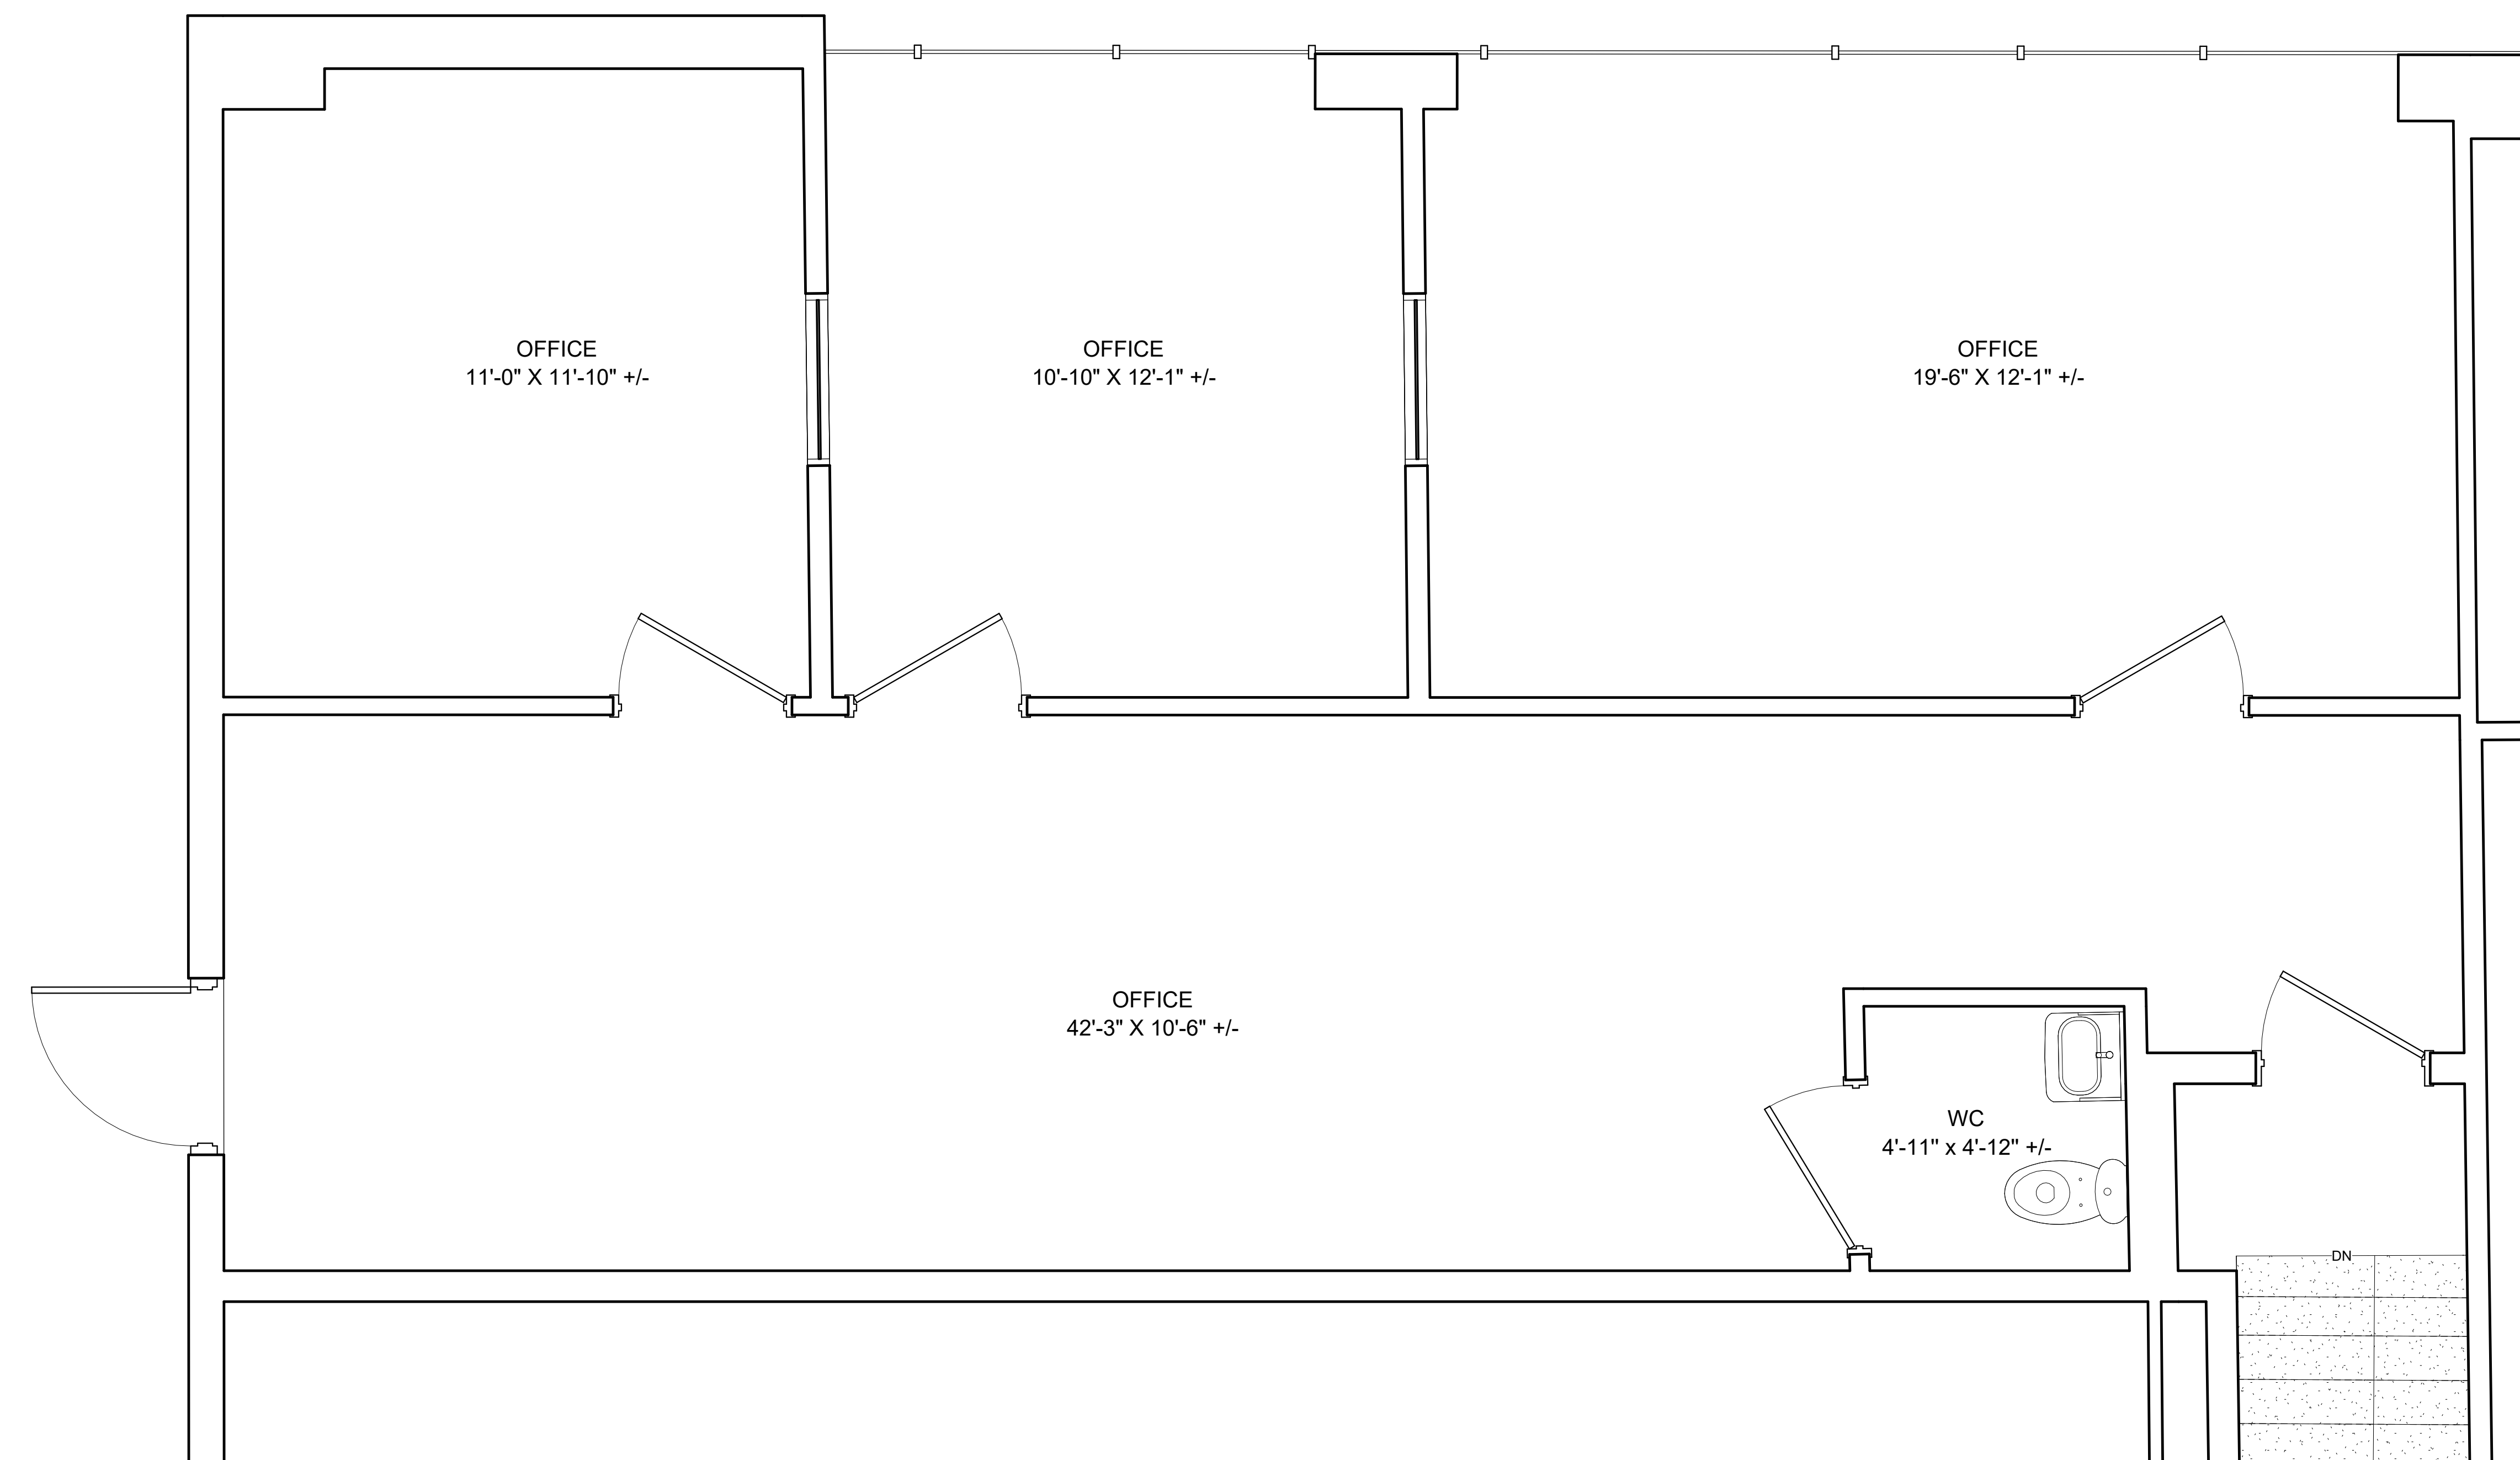

⑥ 4790-201
1/2" = 1'-0"

As Built Floor Plan for Marketing

