


REV	DESCRIPTION	DATE

PLAN NOTES:

- AS-BUILT SURVEY PERFORMED BY NSBRANCH ARCHITECTS ON FRIDAY OCTOBER 18, 2024
- ALL DIMENSIONS ARE SHOWN FROM FACE OF FINISH TO FACE OF FINISH
- CONTRACTOR TO FIELD VERIFY EXISTING DIMENSIONS AND CONDITIONS PRIOR TO CONSTRUCTION

KEYED NOTES:

- SPANDREL PANEL AT EXISTING STOREFRONT
- EXISTING DOOR WITH PANIC HARDWARE
- BUILT-IN RAISED PLATFORM - WOOD CONSTRUCTION
- EXISTING 50 GALLON WATER HEATER - ELECTRIC
- EXISTING SOLID SURFACE COUNTERTOP ON BASE CABINET

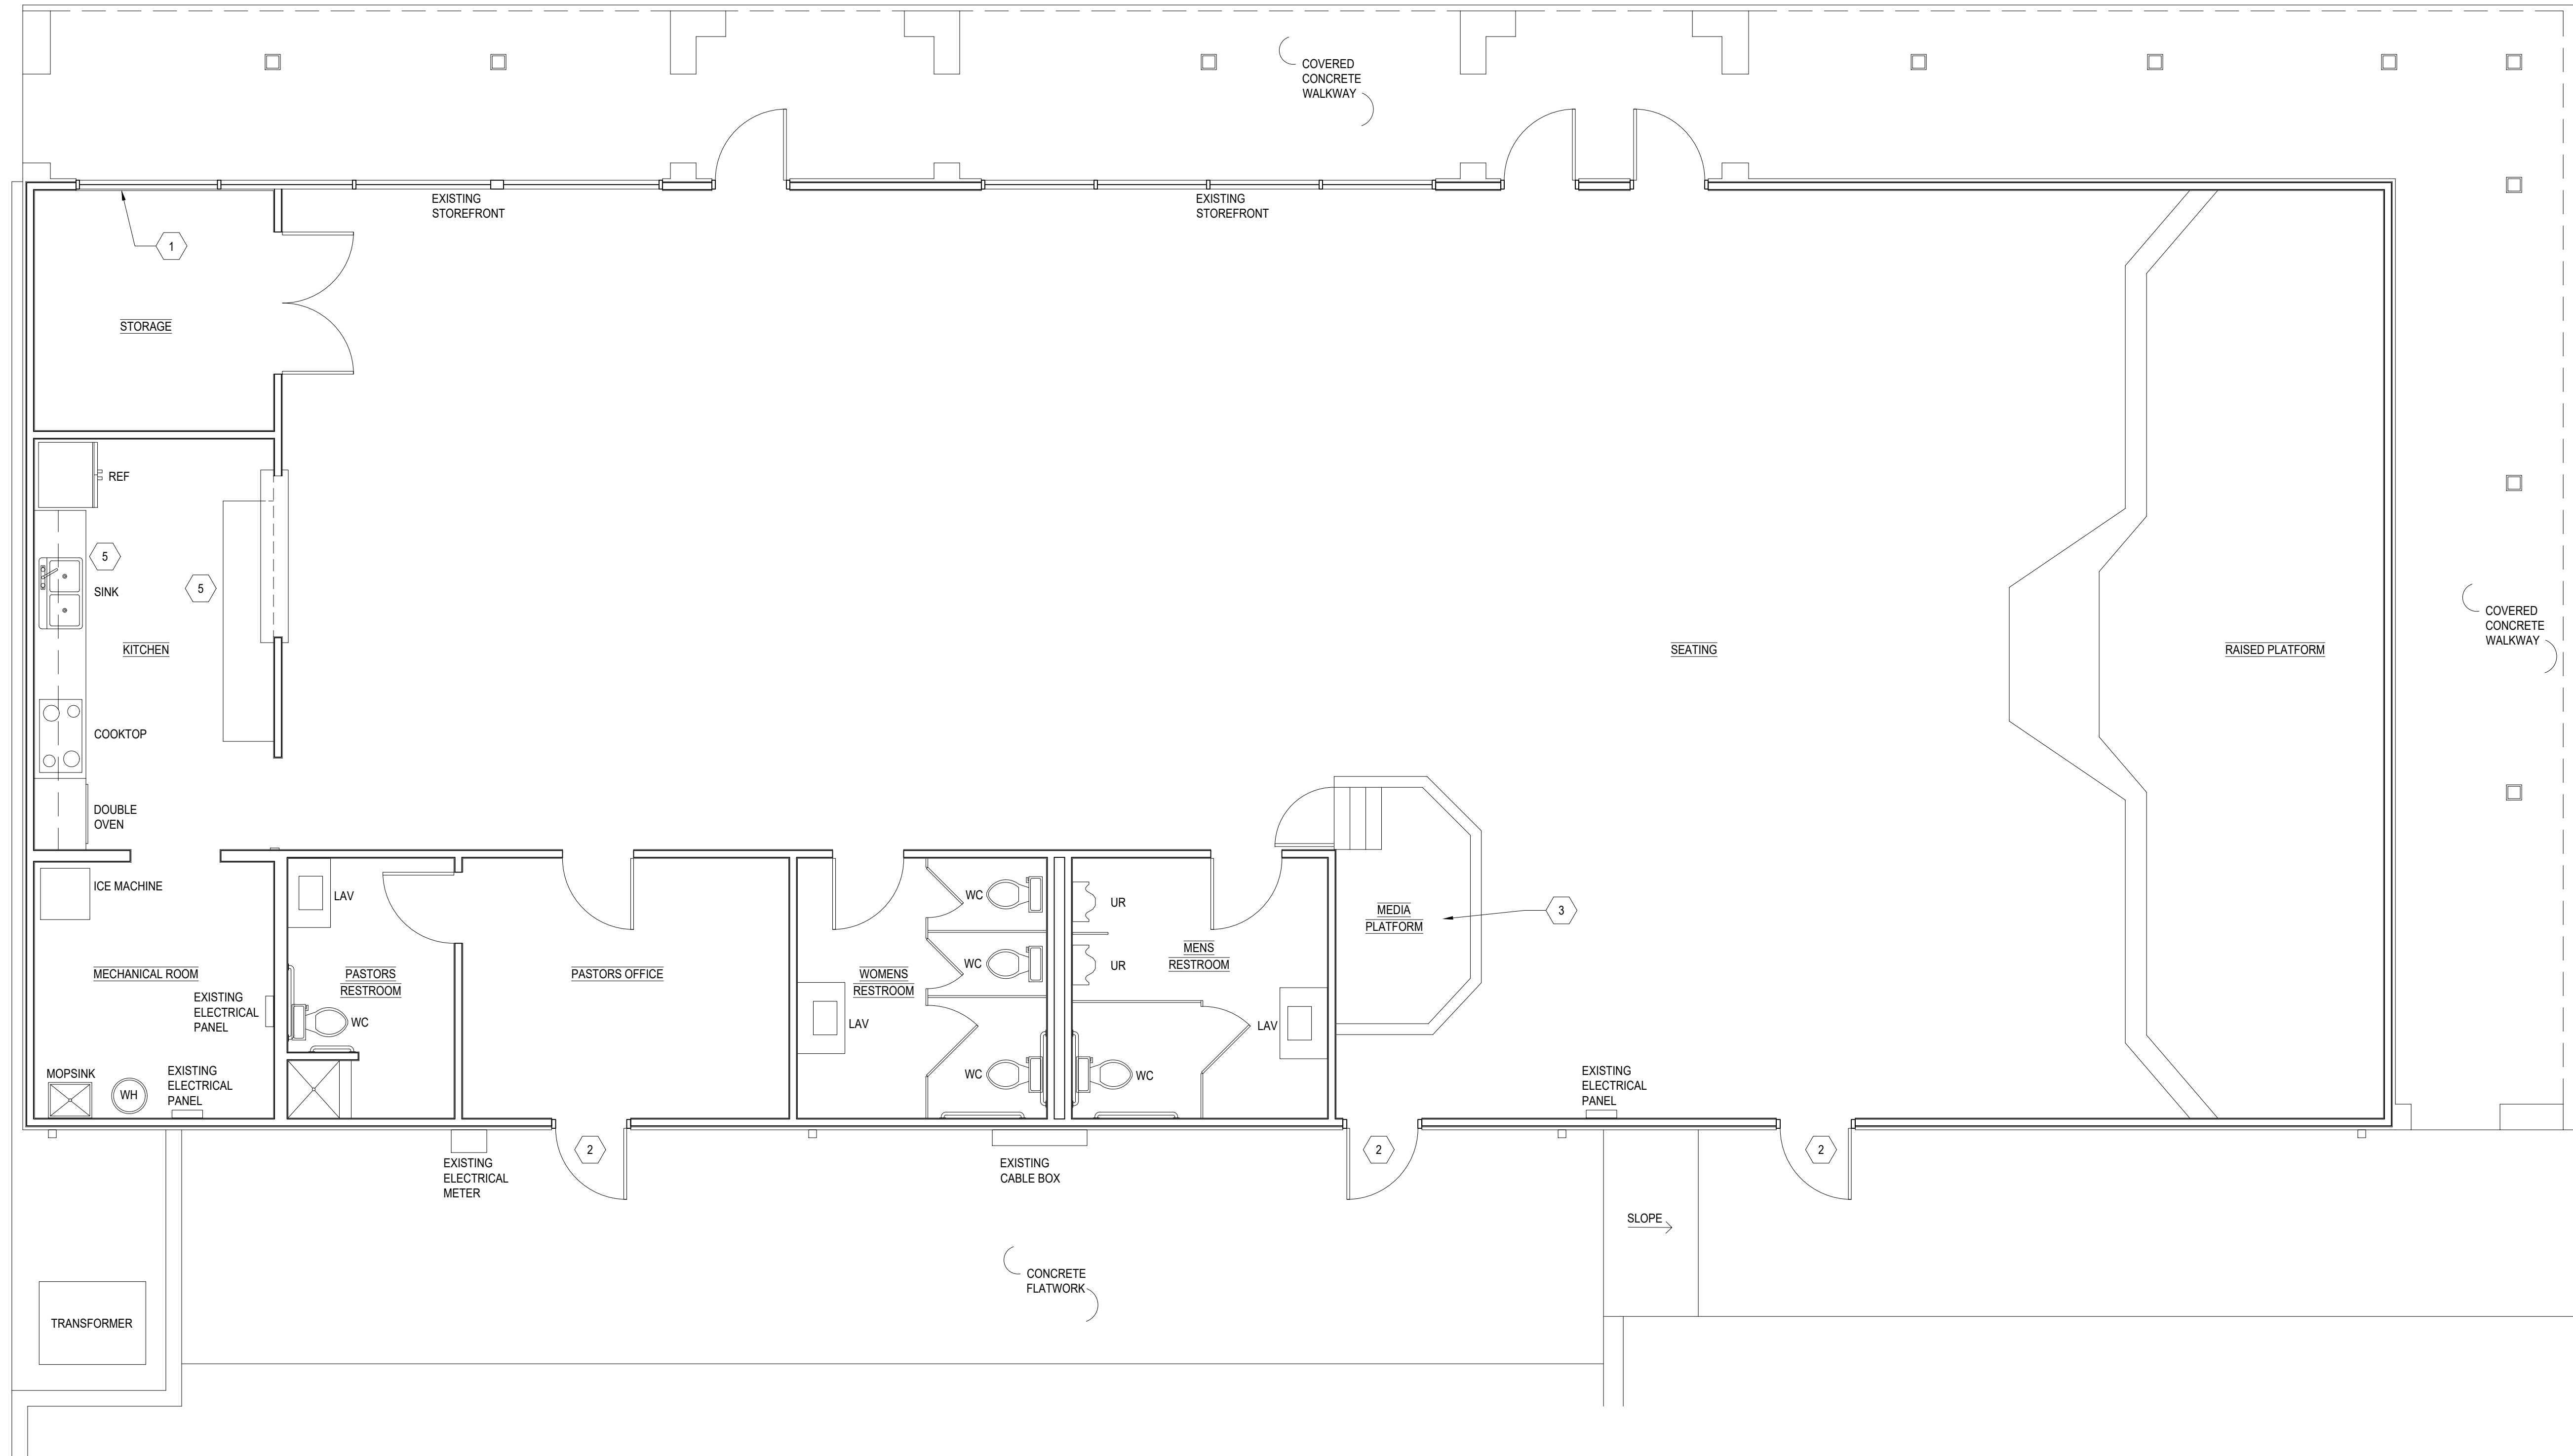

1 FLOOR PLAN - EXISTING

SCALE : 1/4" = 1'-0"

