


Property Key

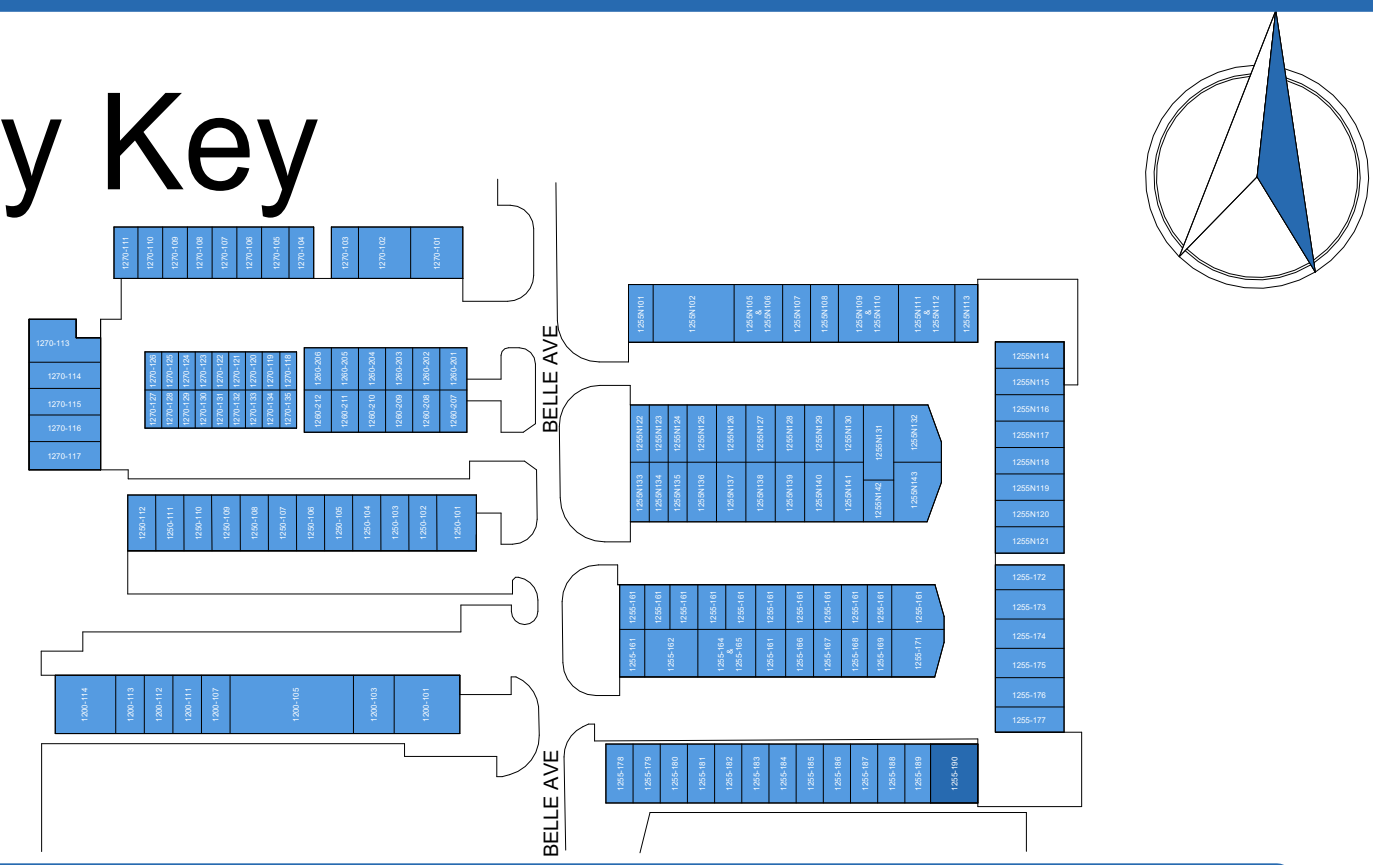

Belle, Winter Springs As Built Marketing Package

1255 Belle Ave, Winter Springs, FL 32708, US

Building: 1255C

Suite: 190

Sheet **E1**

Scale: Not to Scale
Sheet Size: 42" x 30"
Not For Construction




BAY SPACE

Usable Square Foot Analysis

Office Area	2,530	100 %
Warehouse Area	0	0%
Total Area	2,530	

Building Information

Deck Height:	15' - 4 1/2"
Clear Height:	13' - 2 1/2"
Ceiling Height:	7' - 11 1/2"
Sprinklered:	<input type="checkbox"/> Yes <input checked="" type="checkbox"/> No
Mechanical Area:	0 SQFT

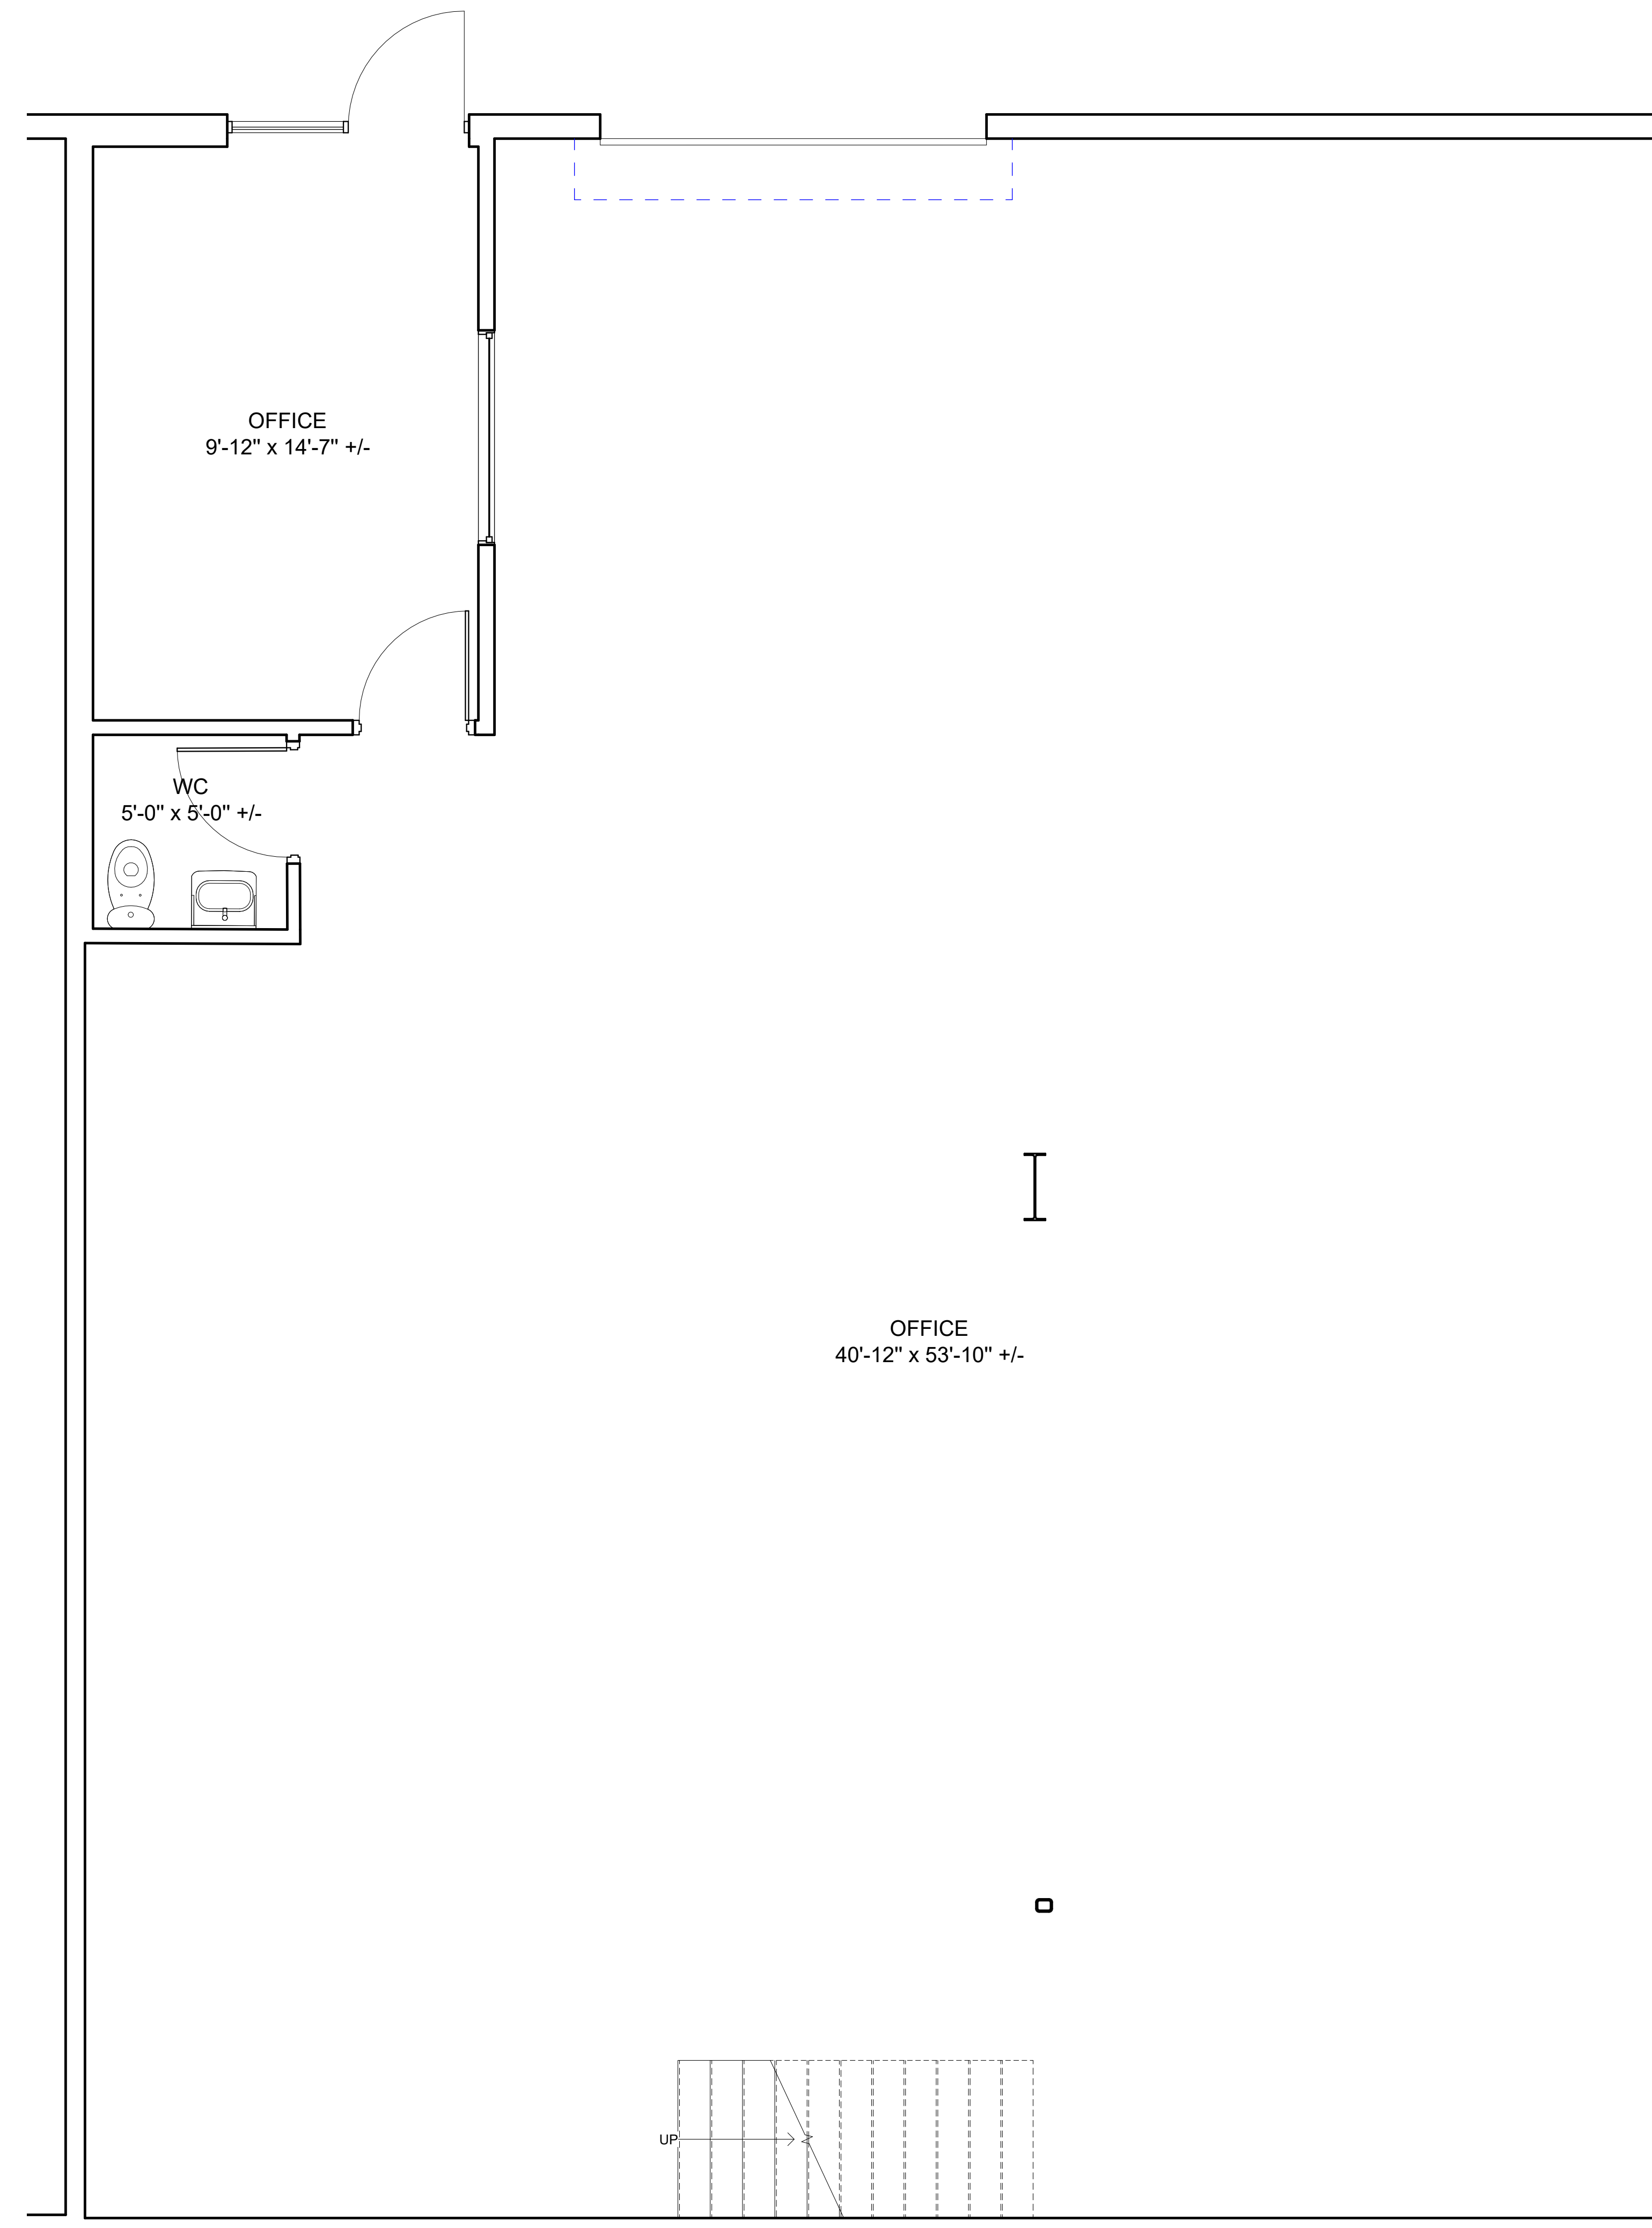

As Built Floor Plan for Marketing

