
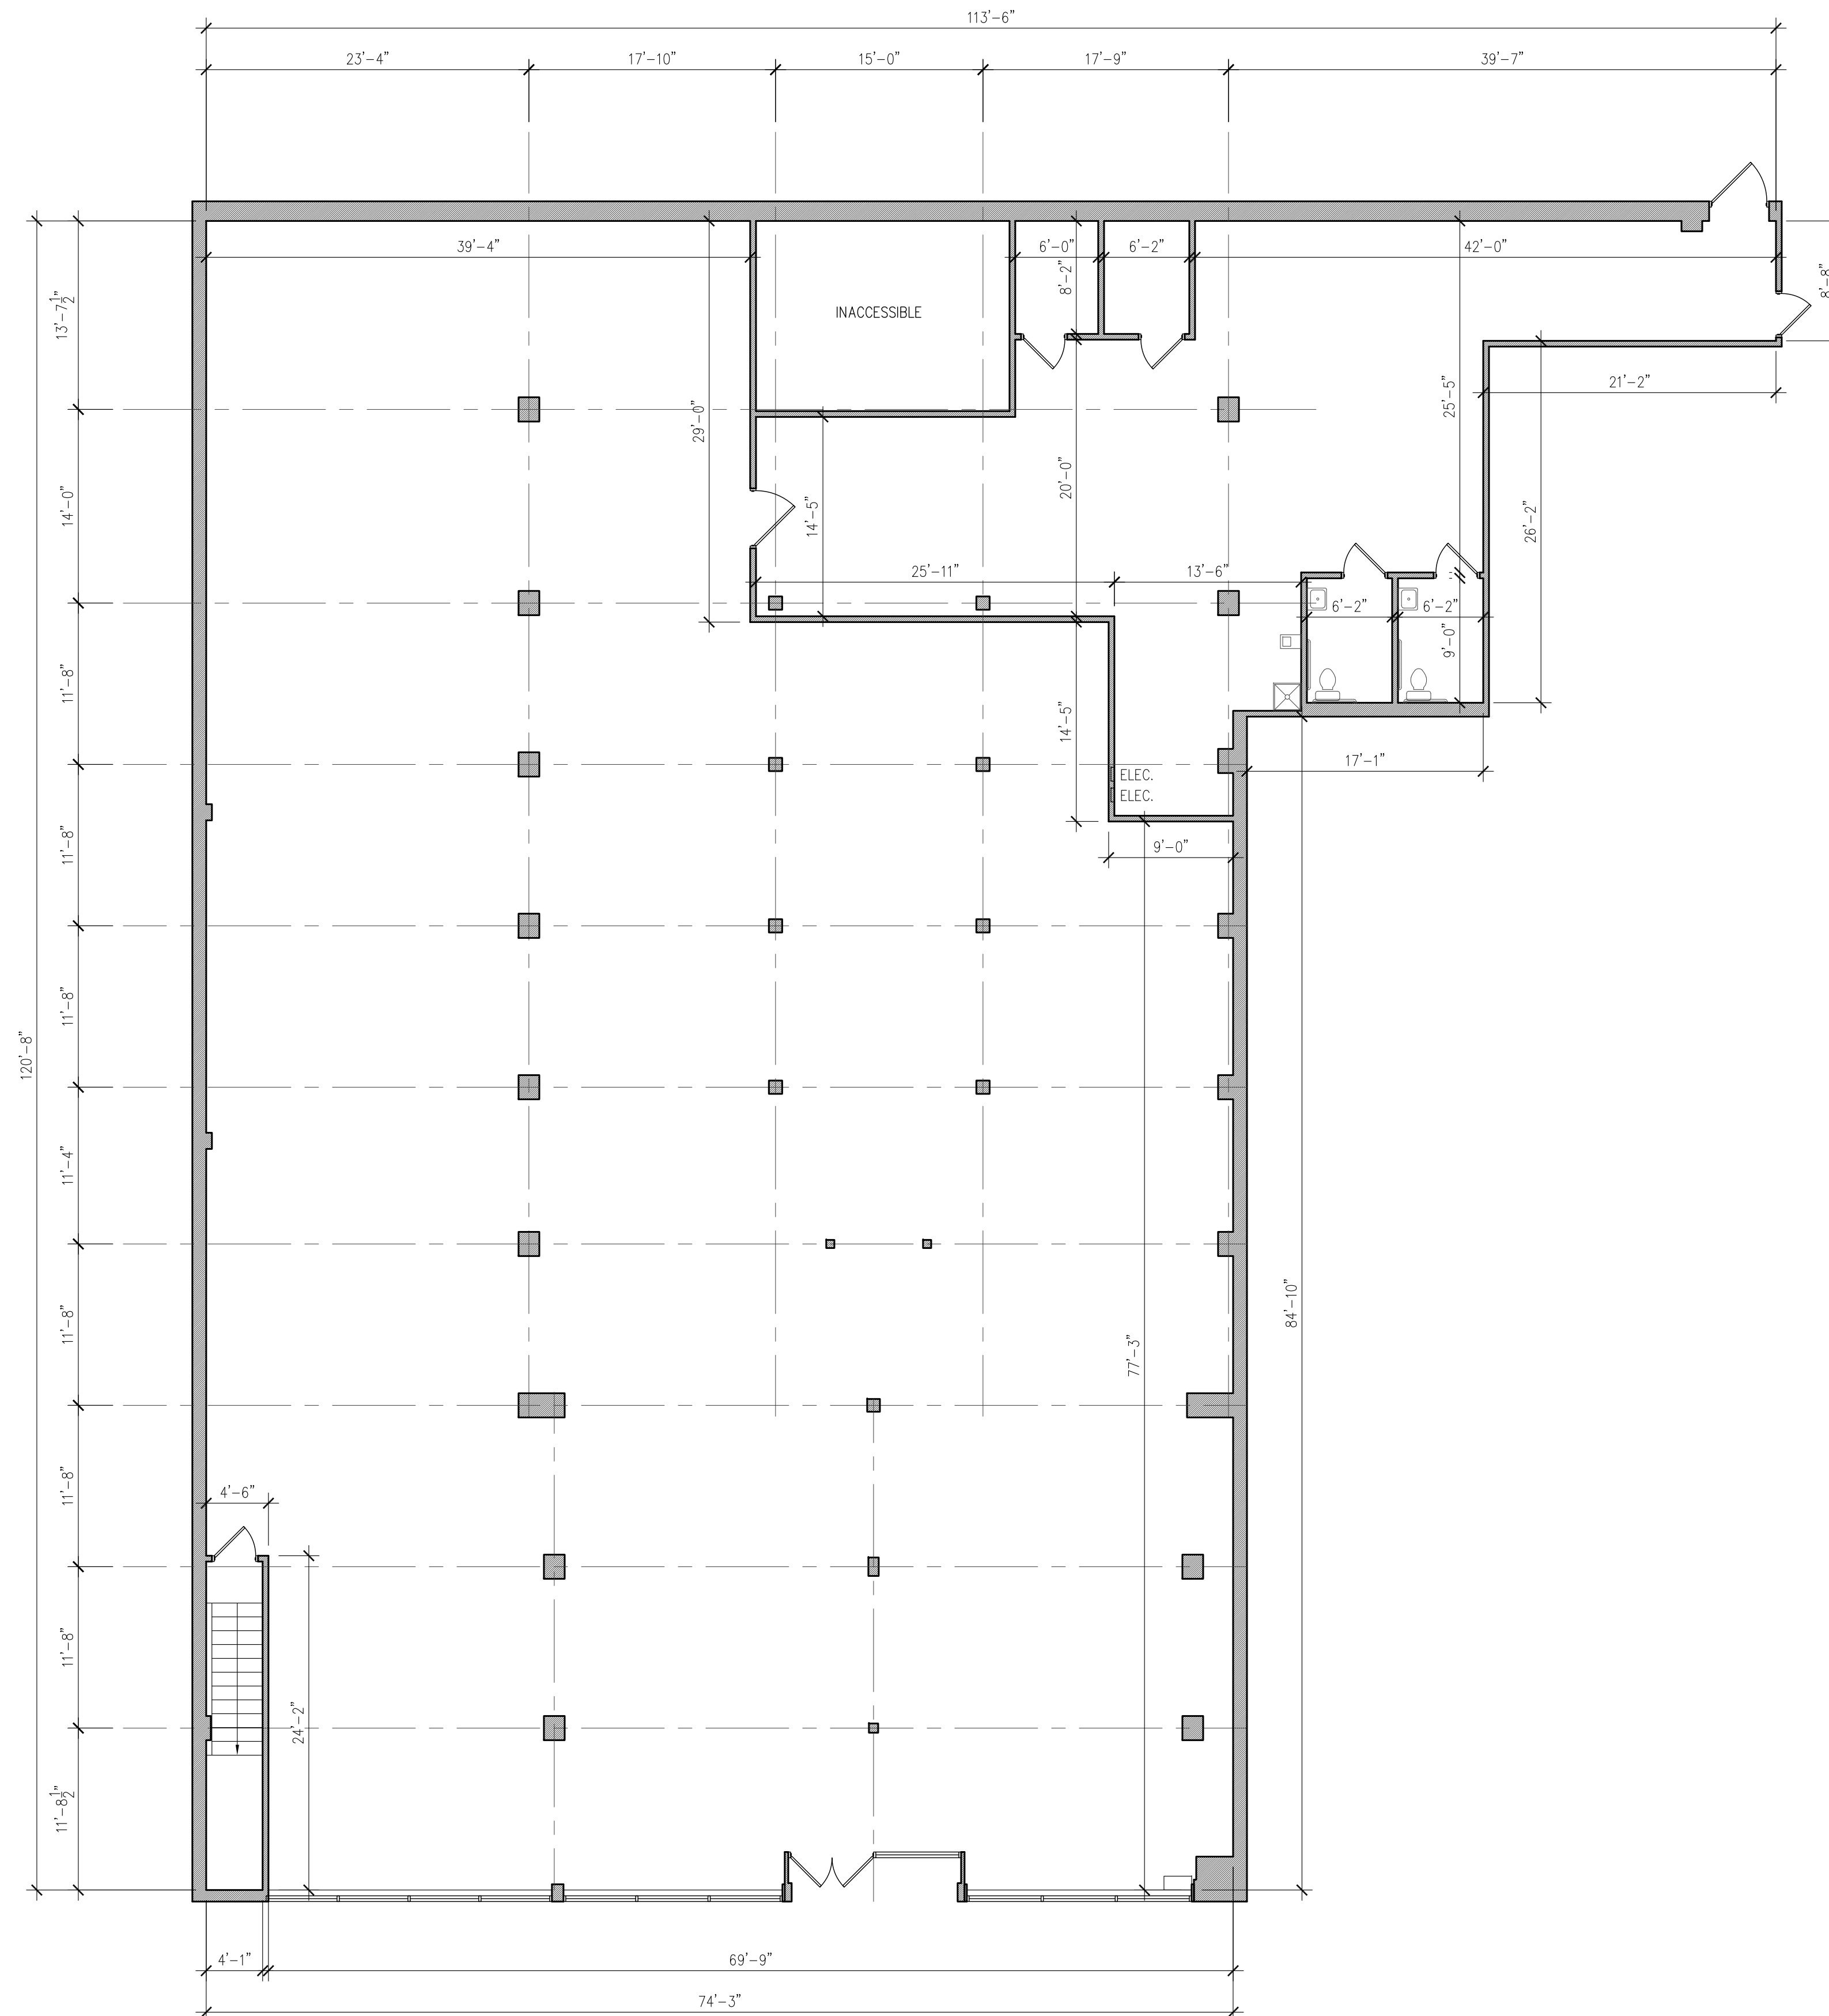


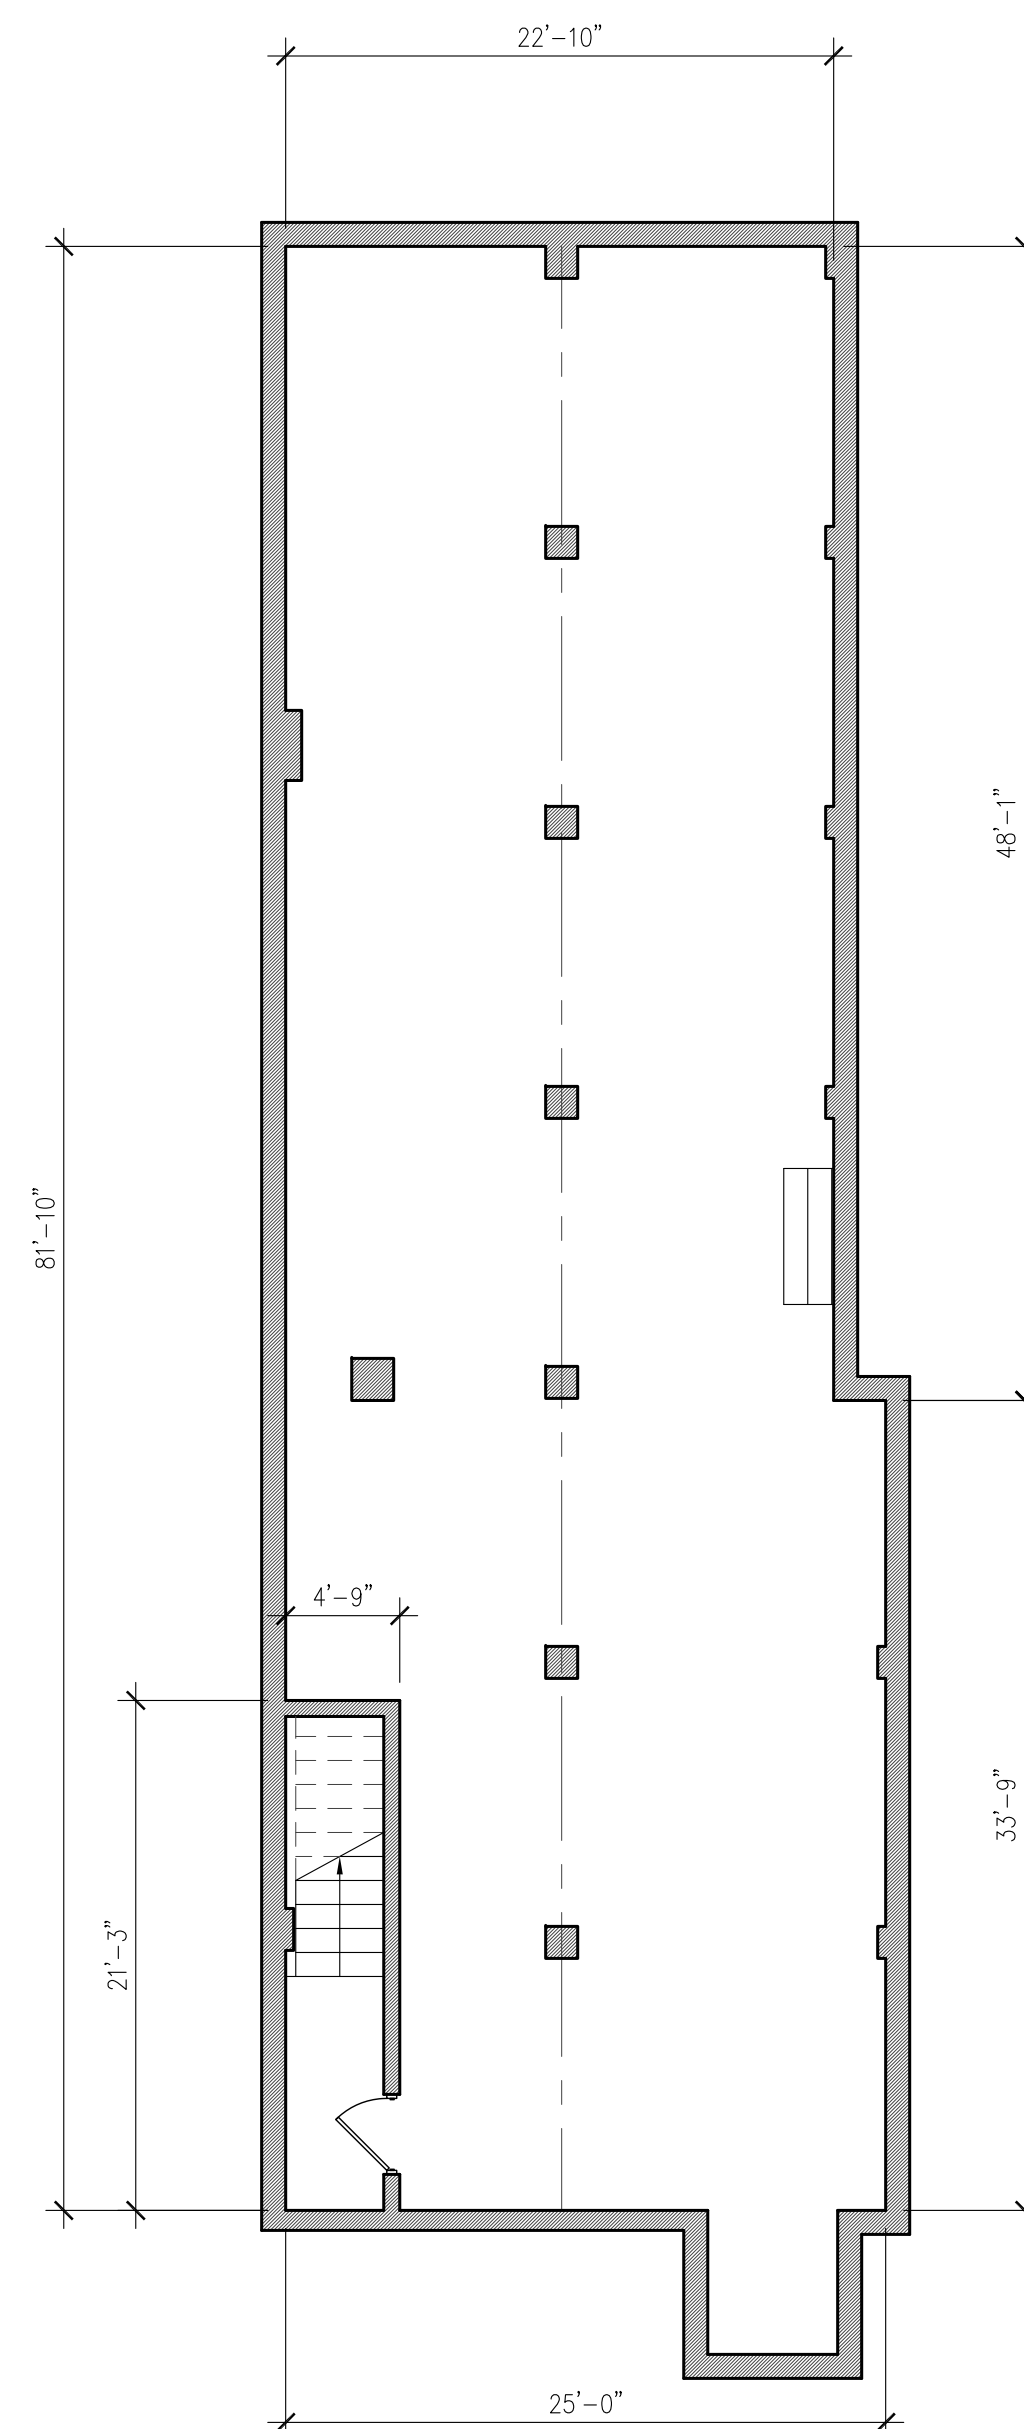

EXISTING
TWO-STORY
BUILDING

136 SMITH STREET
PERTH AMBOY, NEW JERSEY

AS-BUILTS

EXISTING FLOOR PLANS

REVISIONS	DATE
DRAWN:	VS
CHECKED:	
SCALE:	AS SHOWN
DATE:	07-09-25
SHEET NUMBER:	

A-1.1

PROJECT NUMBER: 250709