


## SUITE 2000

4,424-11,060 RSF

### AS-BUILT

18 PERIMETER OFFICES 3  
CONFERENCE ROOMS  
8 INNER WORK STATIONS  
RECEPTION  
KITCHEN

ELEVATOR IDENTITY  
EXCELLENT VIEWS  
CONNECTED STAIRWELL

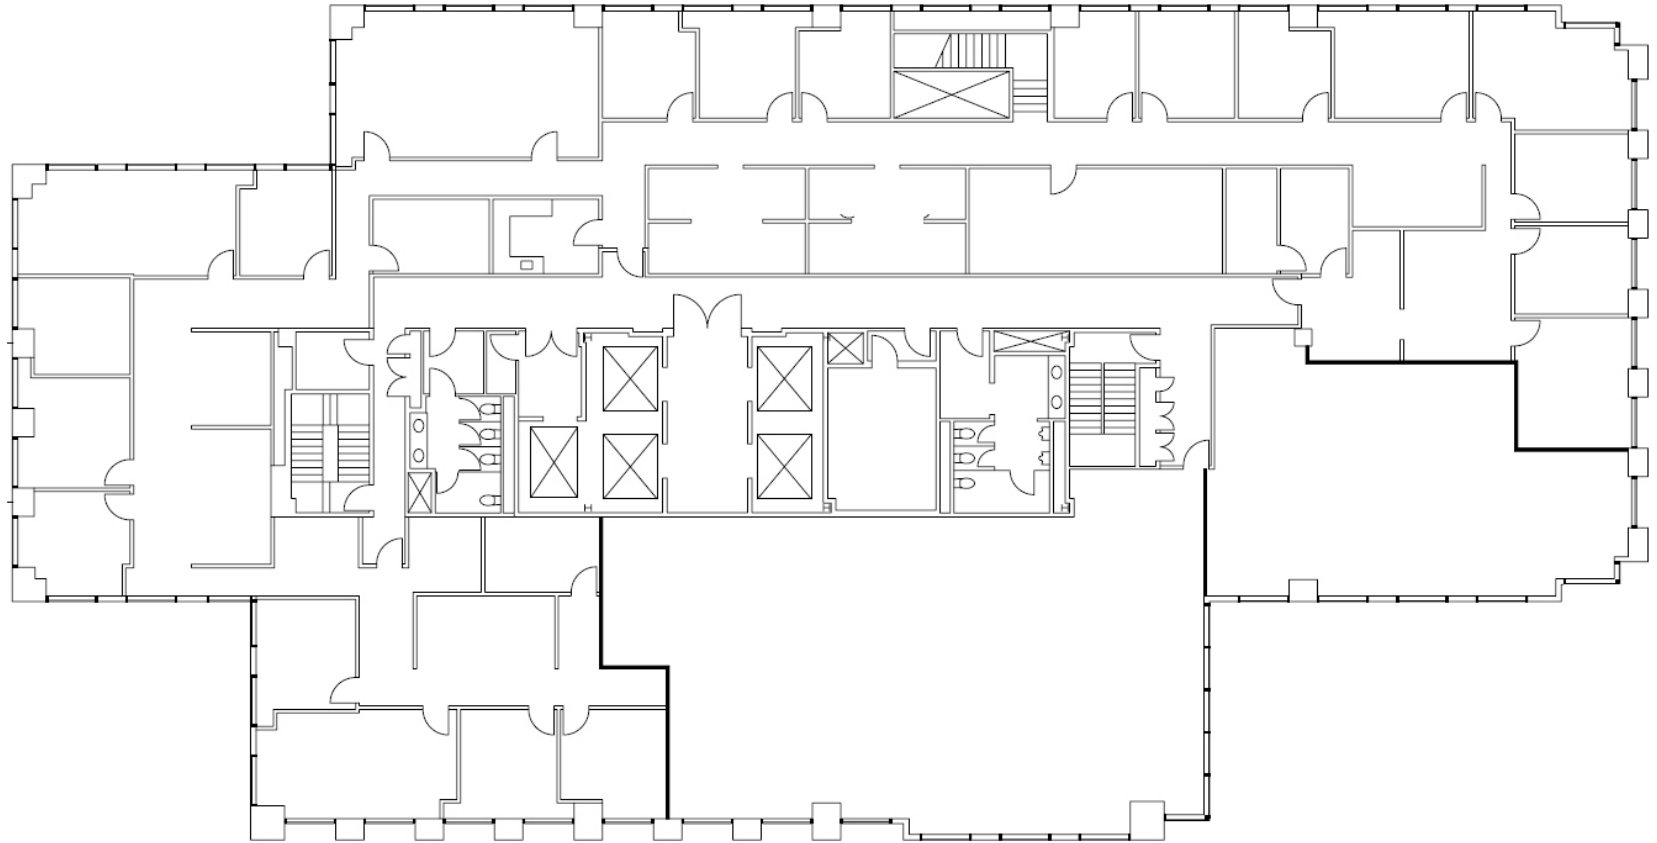

FOR MORE INFORMATION PLEASE CONTACT:

[www.centerwest.com](http://www.centerwest.com)

SEP MELAMED  
President  
Lic. 01219182  
+ 1 310 722 1750  
[sep@primepropertiesre.com](mailto:sep@primepropertiesre.com)

