



**arcDimension**

Tel: 214-38-9640  
Email: info@arcDimension.com  
www.arcDimension.com

Project Address  
**9616 Archibal Ave**  
**Unit 1**  
**Rancho**  
**Cucamonga, CA**  
**91730**

ArcDimension ID  
**188666**

Survey Date  
**1/31/2024**

Surveyed by  
**BJ**

Project Architect  
**BK**


Date  
**2/9/2024**

Sheet Number  
**A101**

Notes  
**No further notes applicable.**

While deemed reliable, no information on these as-built drawings should be relied upon without independent verification. These drawings are the property of ArcDimension. Use by a third-party without written authorization is prohibited.

TOTAL SQUARE FOOTAGE: 6,479 SQ. FT.  
CALCULATED FROM OUTSIDE FACE OF EXTERIOR WALLS  
AND CENTER OF DEMISING WALLS.  
(LOBBY AND STAIRCASES EXCLUDED FROM SQ. FT.)

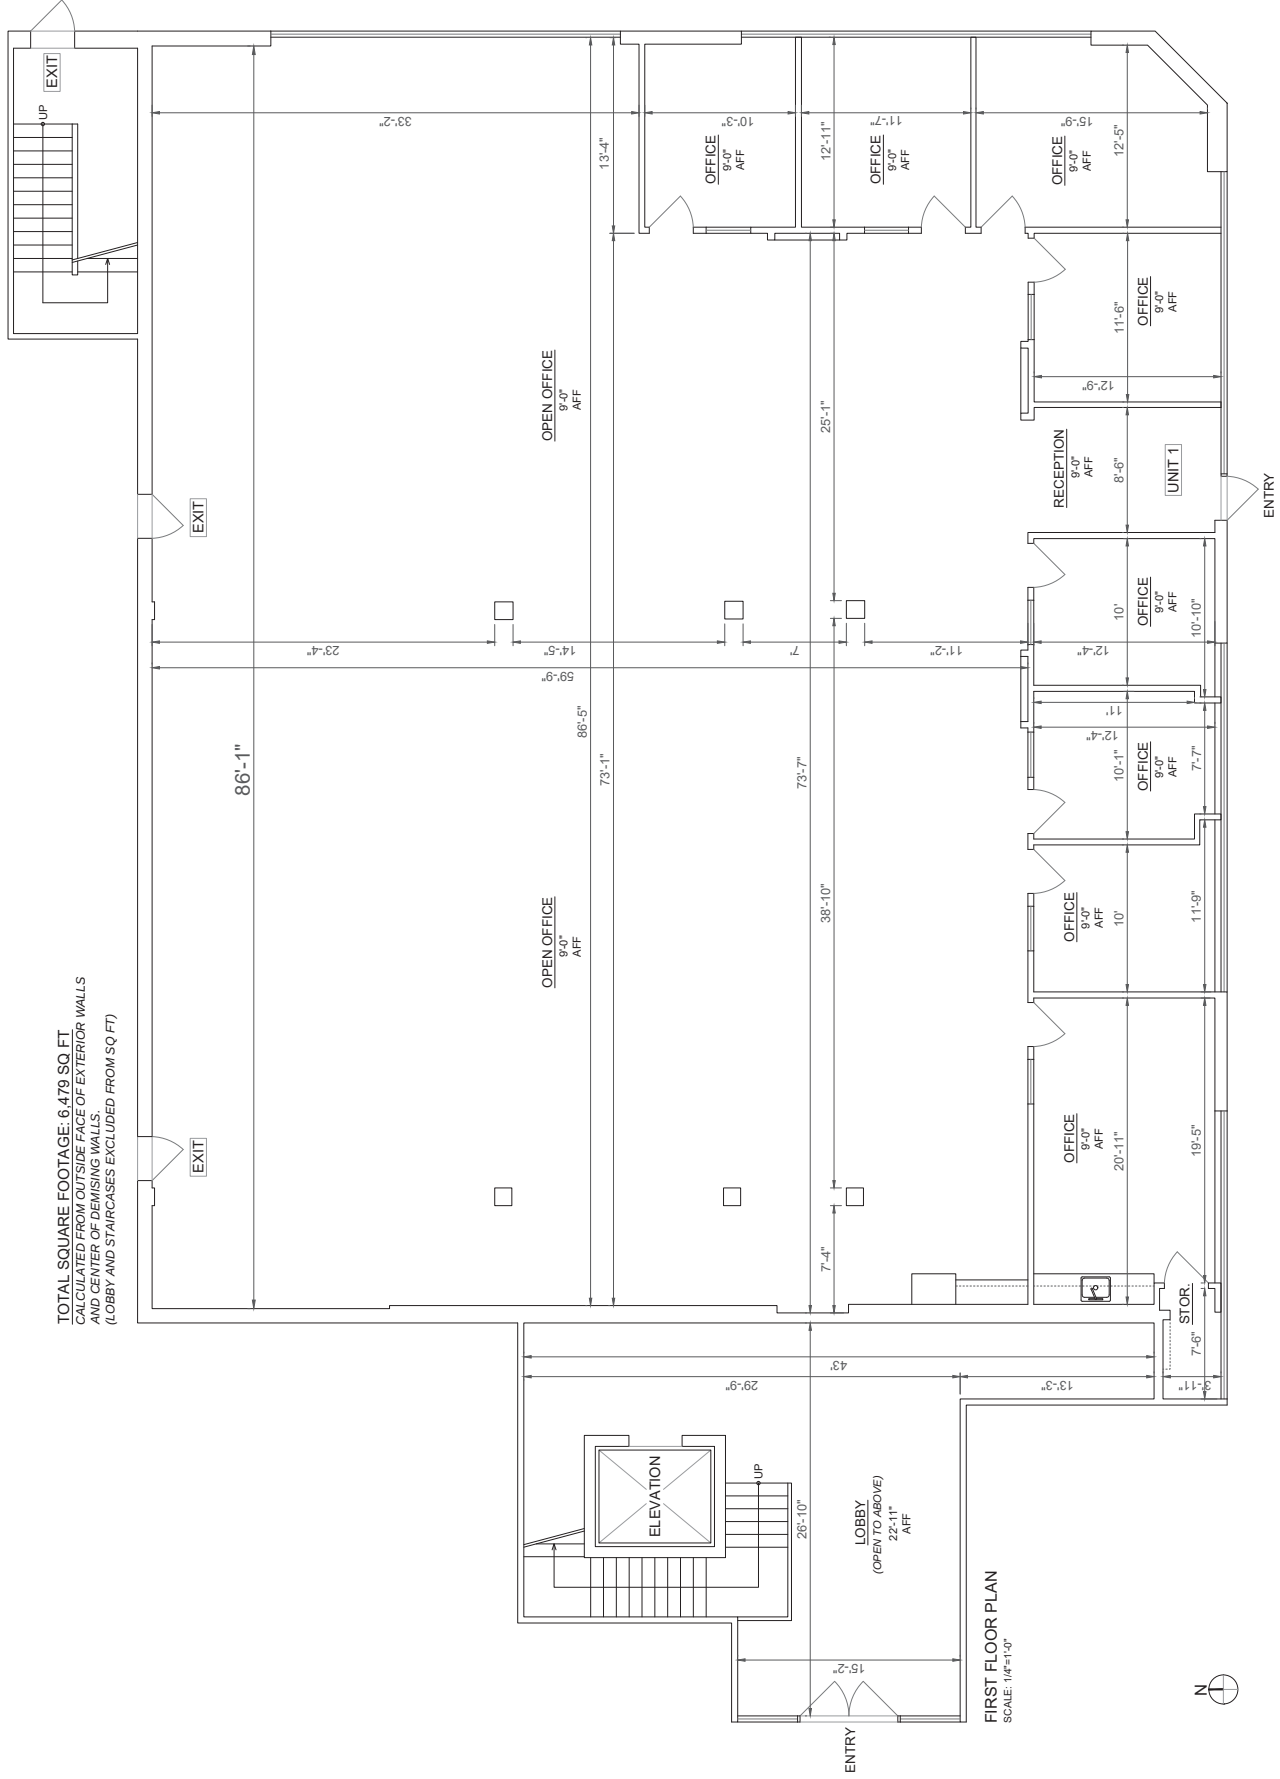

**FIRST FLOOR PLAN**  
SCALE: 1/4"=1'-0"