


WESTMINSTER, CA #0653

TENANT SPACE  
INT. 8,433.958 s.f.

- LEGEND**
- EXISTING SHELVING
  - RELOCATED SHELVING
  - NEW SHELVING
  - - - DEMO SHELVING

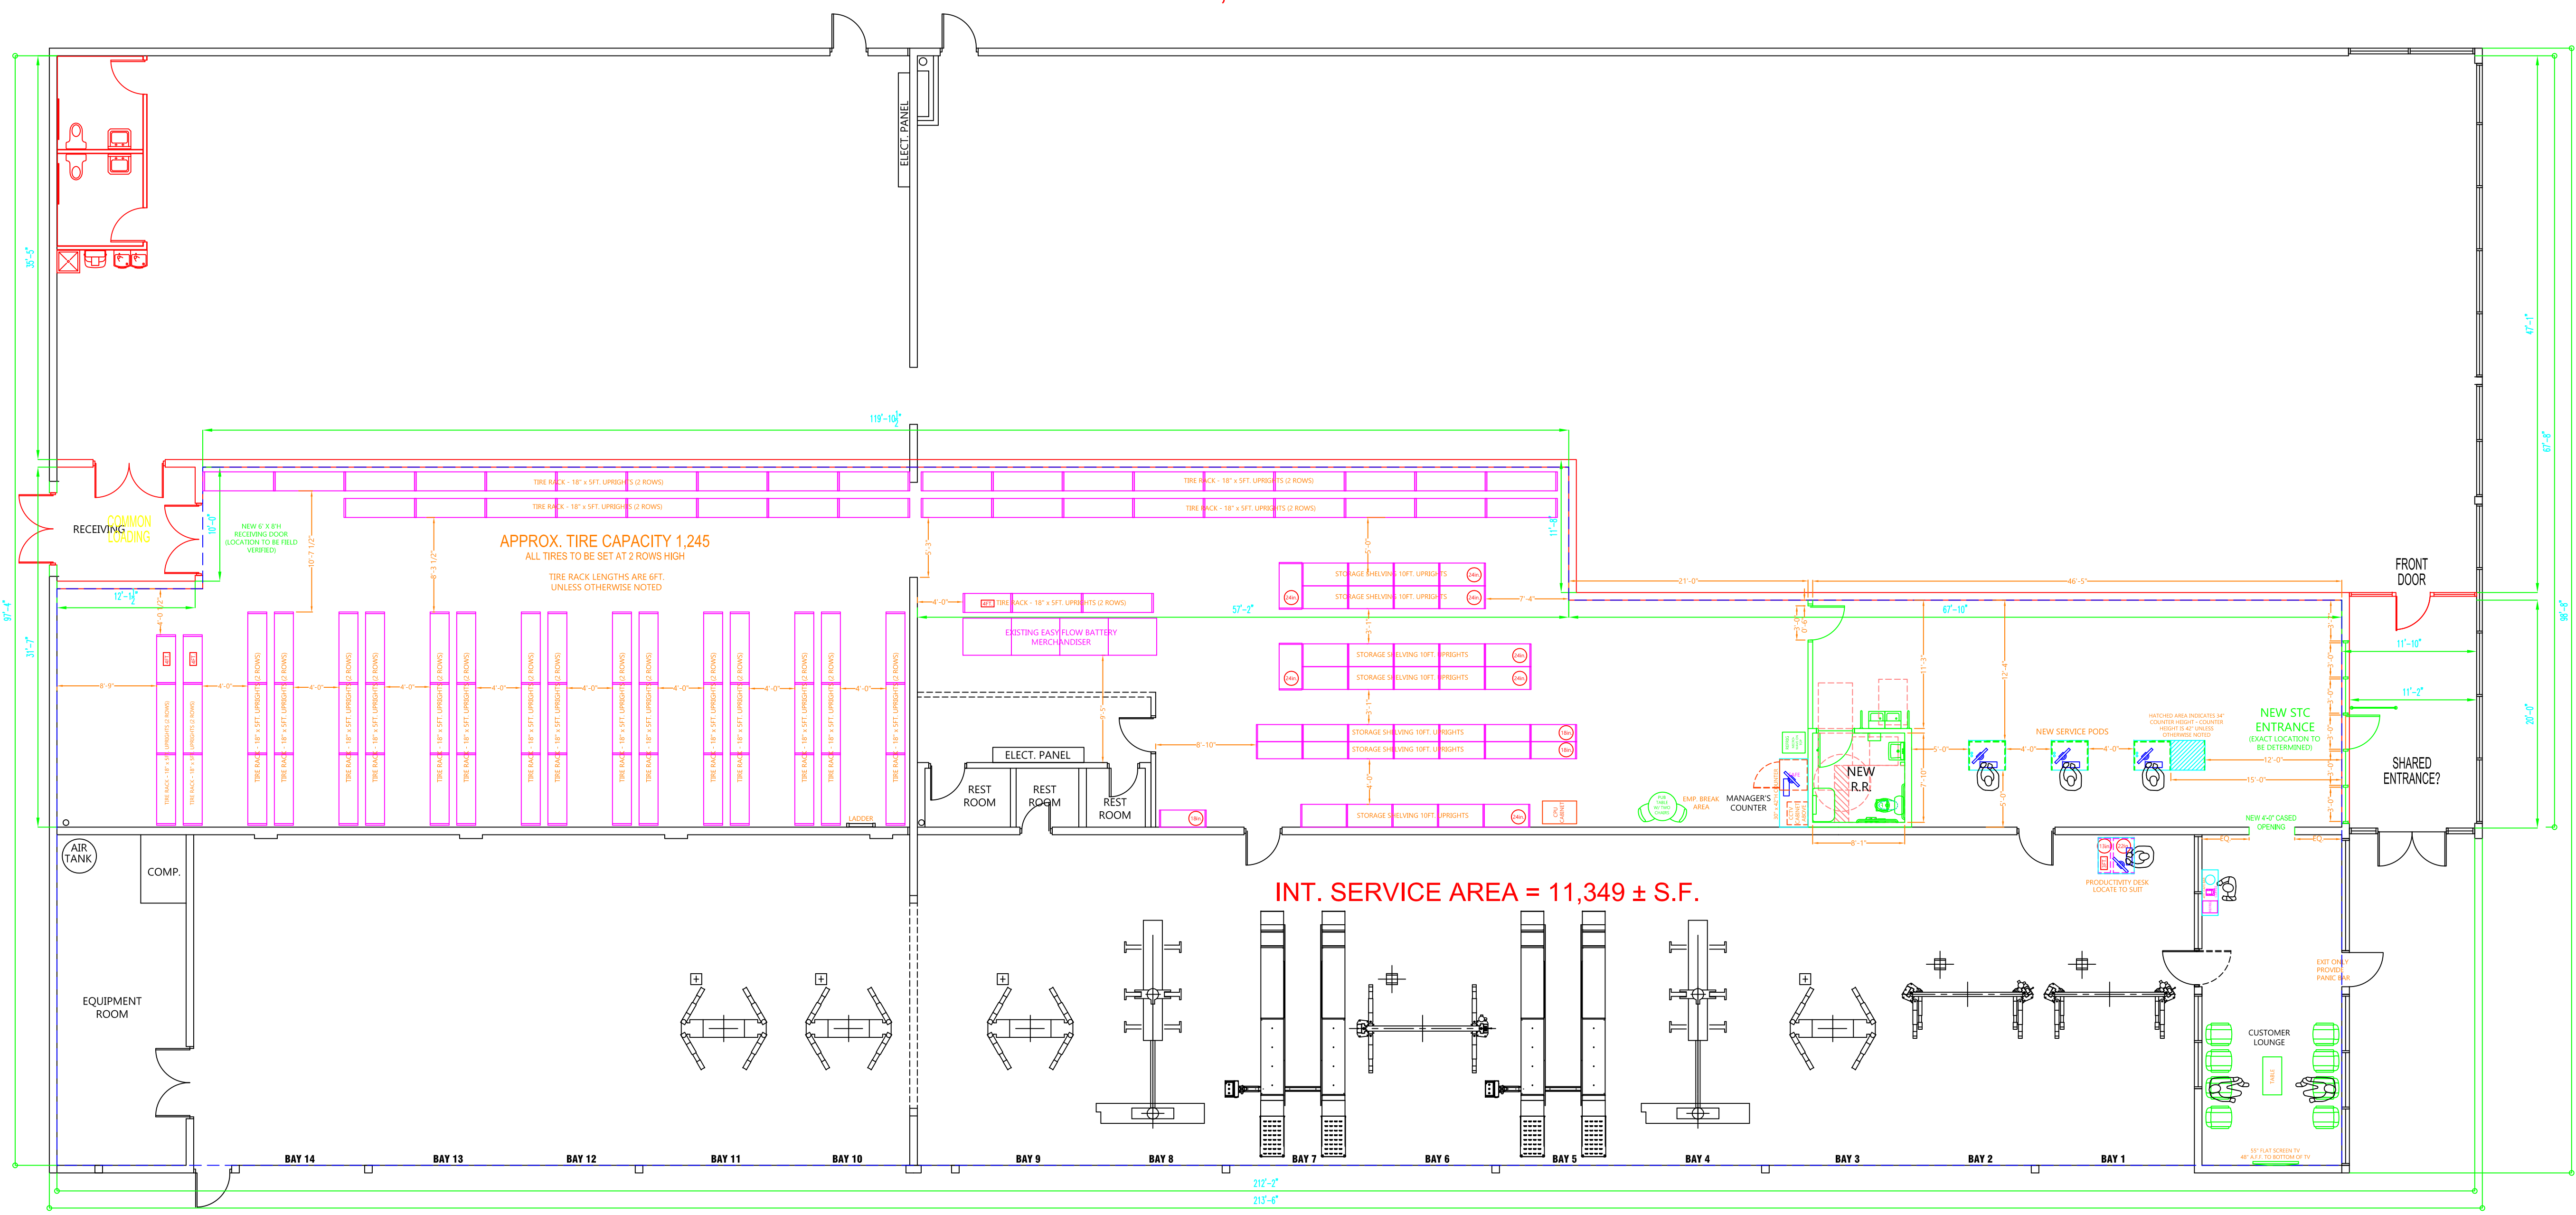

REV.	DESCRIPTION	DATE	REVISIONS
A	TENANT FIT OUT	06/07/21	
B	REVISED LAYOUT PER LATEST CONCEPT	07/28/22	
C	REVISED TIRE RACKING CONCEPT PER AS-BUILT	03/10/23	
D	REVISED LAYOUT PER LATEST REDUCED SCOPE	04/19/23	
E	AS-BUILT SHELVING	05/20/24	

SQ. FT. INFORMATION	
RETAIL -	
STOCK -	
SERVICE -	
INSIDE AREA -	
OUTSIDE AREA -	

**PEPBOYS**  
**AUTO**  
WESTMINSTER, CA. STORE # 0653

DRAWING INFORMATION	
File No.	0653
Date	06/04/21
Drawn by:	T.T.
Approved by:	
Scale:	1/8" = 1'
Drawing Title	
<b>FIXTURE PLAN</b>	
File Name	Rev.
<b>0653</b>	<b>F</b>

