


Property Key

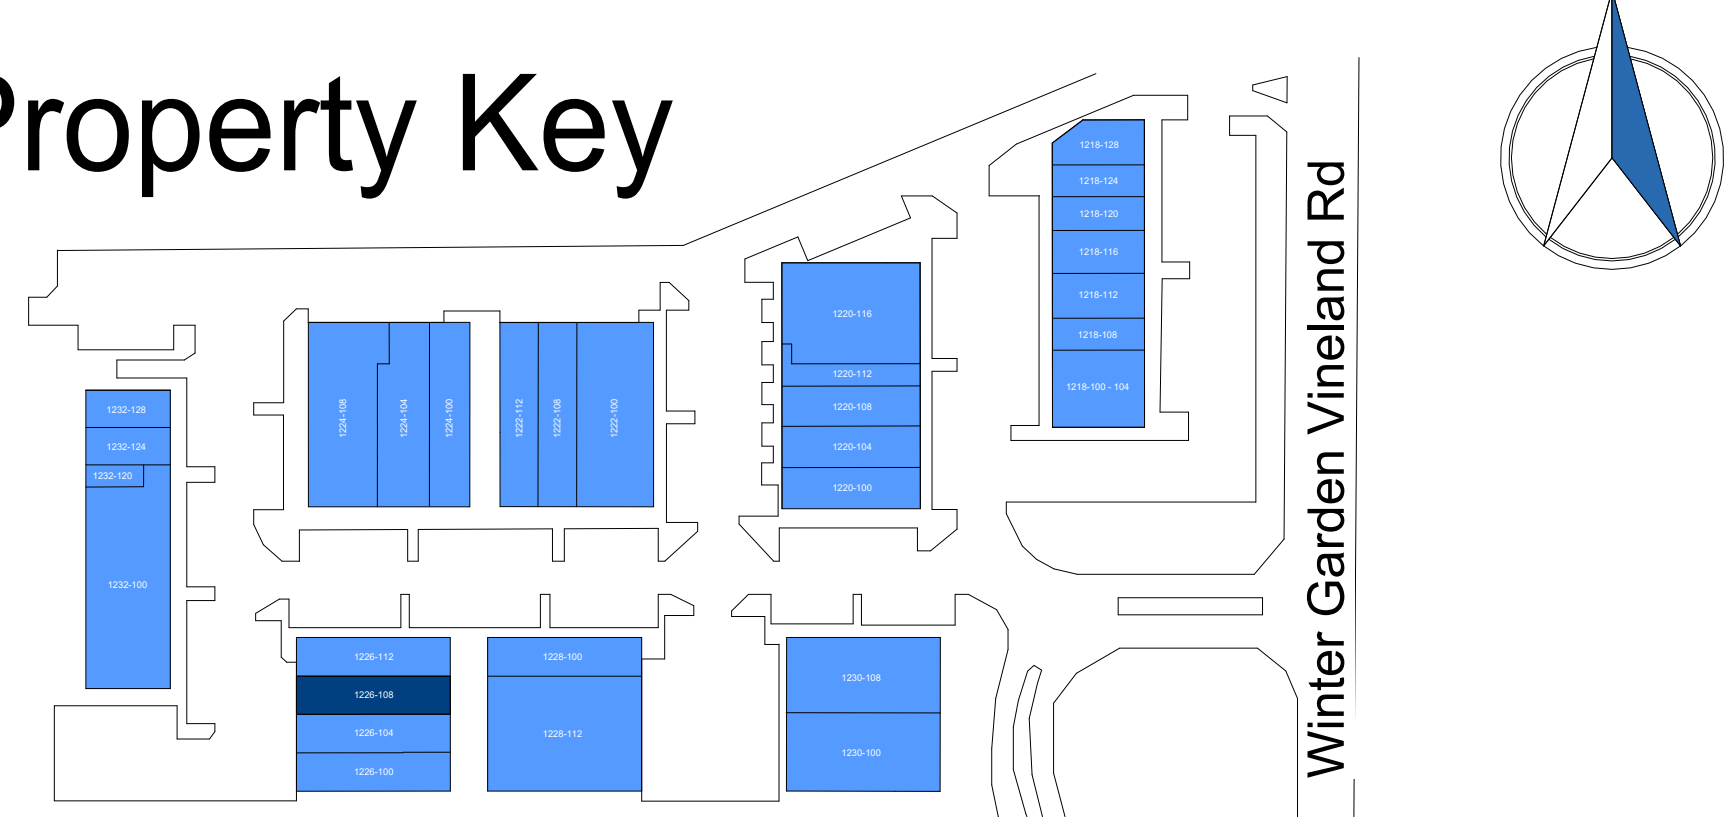

Winter Garden As Built Marketing Package

1226 Winter Garden Vineland Rd, Winter Garden, FL 34787, US

Building: 1226

Suite: 104

Sheet **E1**

Scale: Not to Scale
Sheet Size: 42" x 30"
Not For Construction




BAY SPACE

Usable Square Foot Analysis

Office Area	2,500	100 %
Warehouse Area	0	0%
Total Area	2,500	

Building Information

Deck Height:	16' - 11 1/2"
Clear Height:	11' - 10"
Ceiling Height:	9' - 10 1/2"
Sprinklered:	<input checked="" type="checkbox"/> Yes <input type="checkbox"/> No
Mechanical Area:	0 SQFT

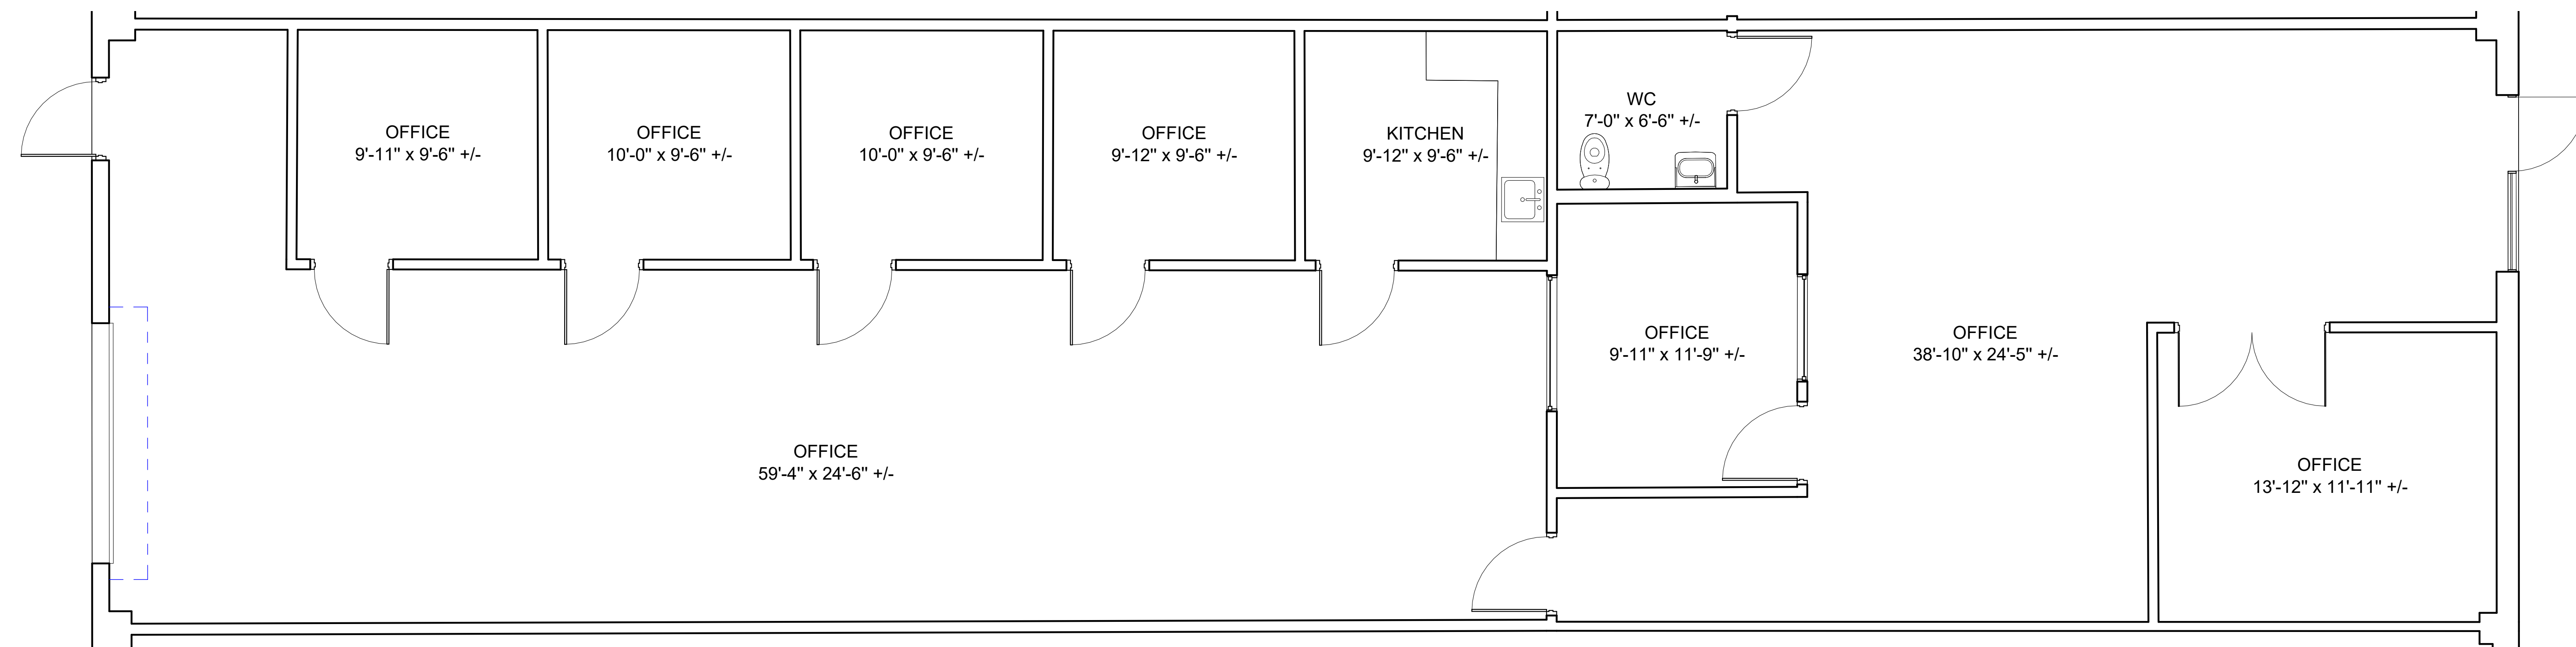

As Built Floor Plan for Marketing

