

225 Broadway

The Transportation Building

The very attractive building at 225 Broadway boasts a Renaissance Revival design, and where it is located is just as appealing. It sits adjacent to the Fulton Street Hub, is near City Hall and courts, and is located in a very popular and high-traffic area, perfect for any New York native. Enjoy nice views of City Hall and the Brooklyn Bridge as well as over the whole oculus. While it's chock full of old school charm, the building is equipped with a destination dispatch elevator allowing for a touchless and more efficient transportation experience.



Leasing Agent

Mendy Braun
212-349-2154
Mbraun@braunmgmt.com

OWNER

Bowling Green Assocs., L.P.

MANAGING AGENT

KF Braun Management LLC

LOBBY DESK

212-227-8638



Ground Floor - Suite Stor1

225 BROADWAY

Suite	Sq. Ft.	Monthly Rent	Monthly Electricity	Electricity	Rent per Sq. Ft.
Stor1	3,645	\$106,313		Direct Meter	\$350

ESCALATION: 3% Per Annum In Lieu of Operating Expense. R.E. Tax Pass Along

NOTES:

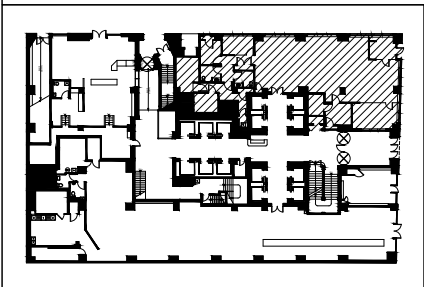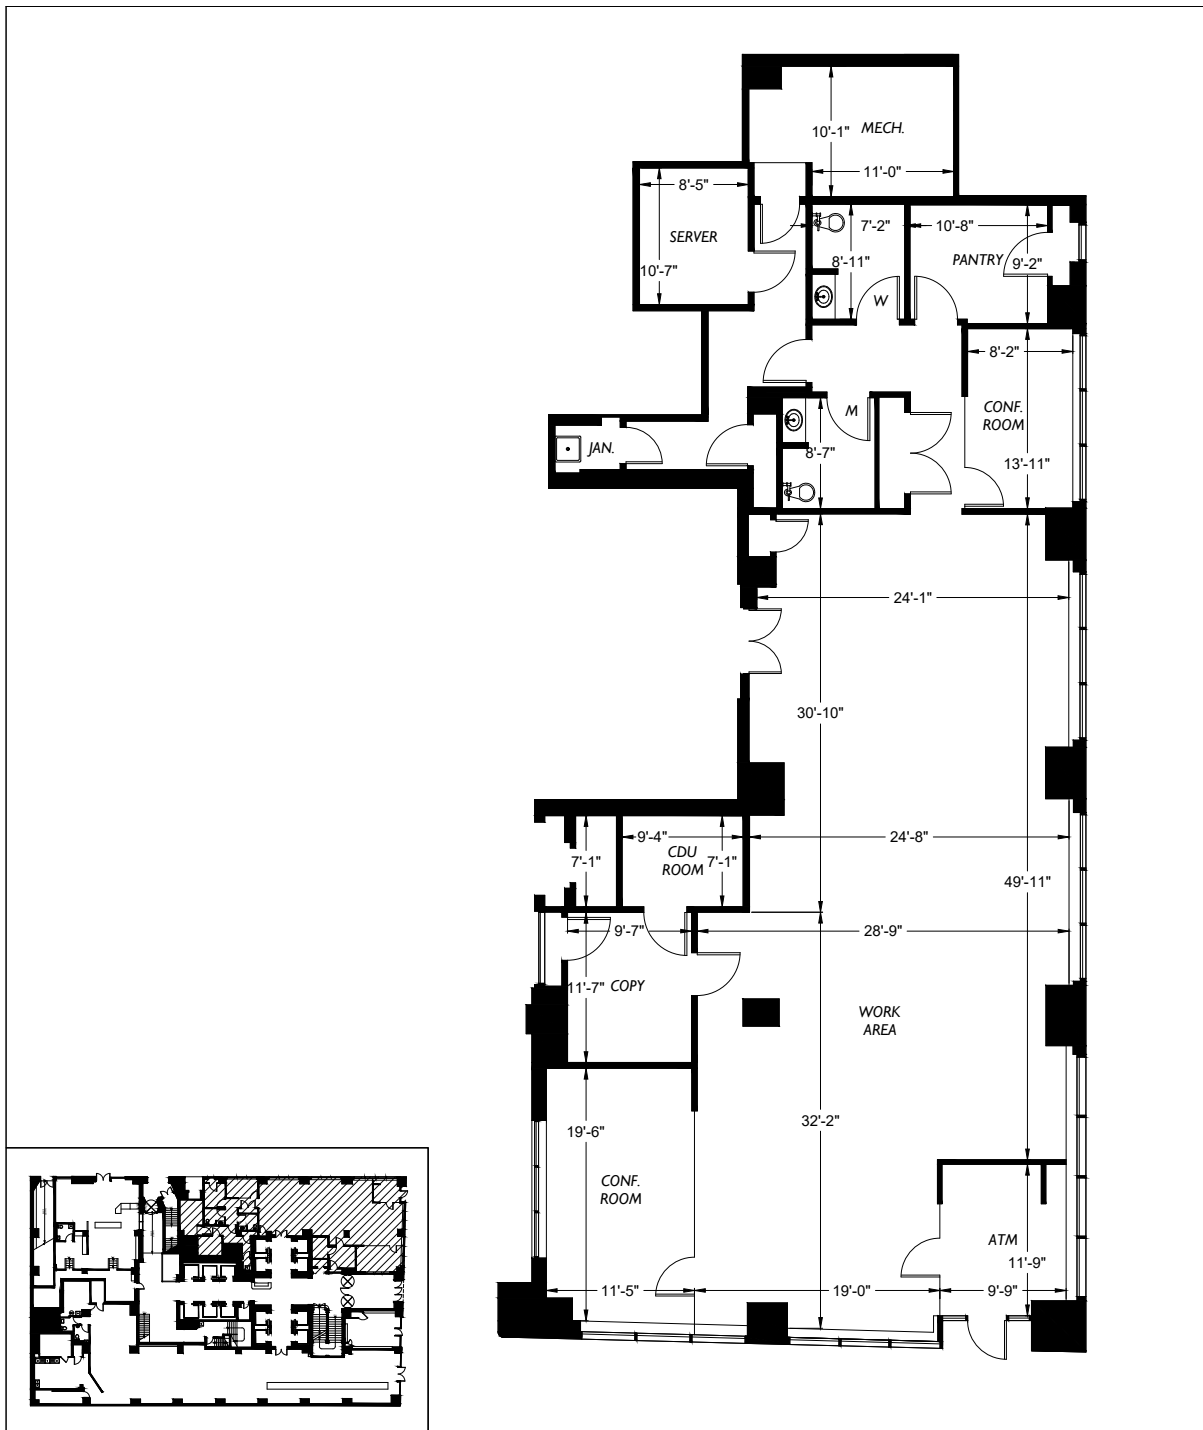

2-D
AS-BUILT
FLOOR PLANS

2DFLOORPLANS.COM
206-328-7410

600 NW Gilman Blvd. Suite E
Issaquah, WA 98027

**225 BROADWAY
SUITE BANK
NEW YORK, N.Y.**