


SUITE 270: 2,880 SF

SPACE AVAILABLE

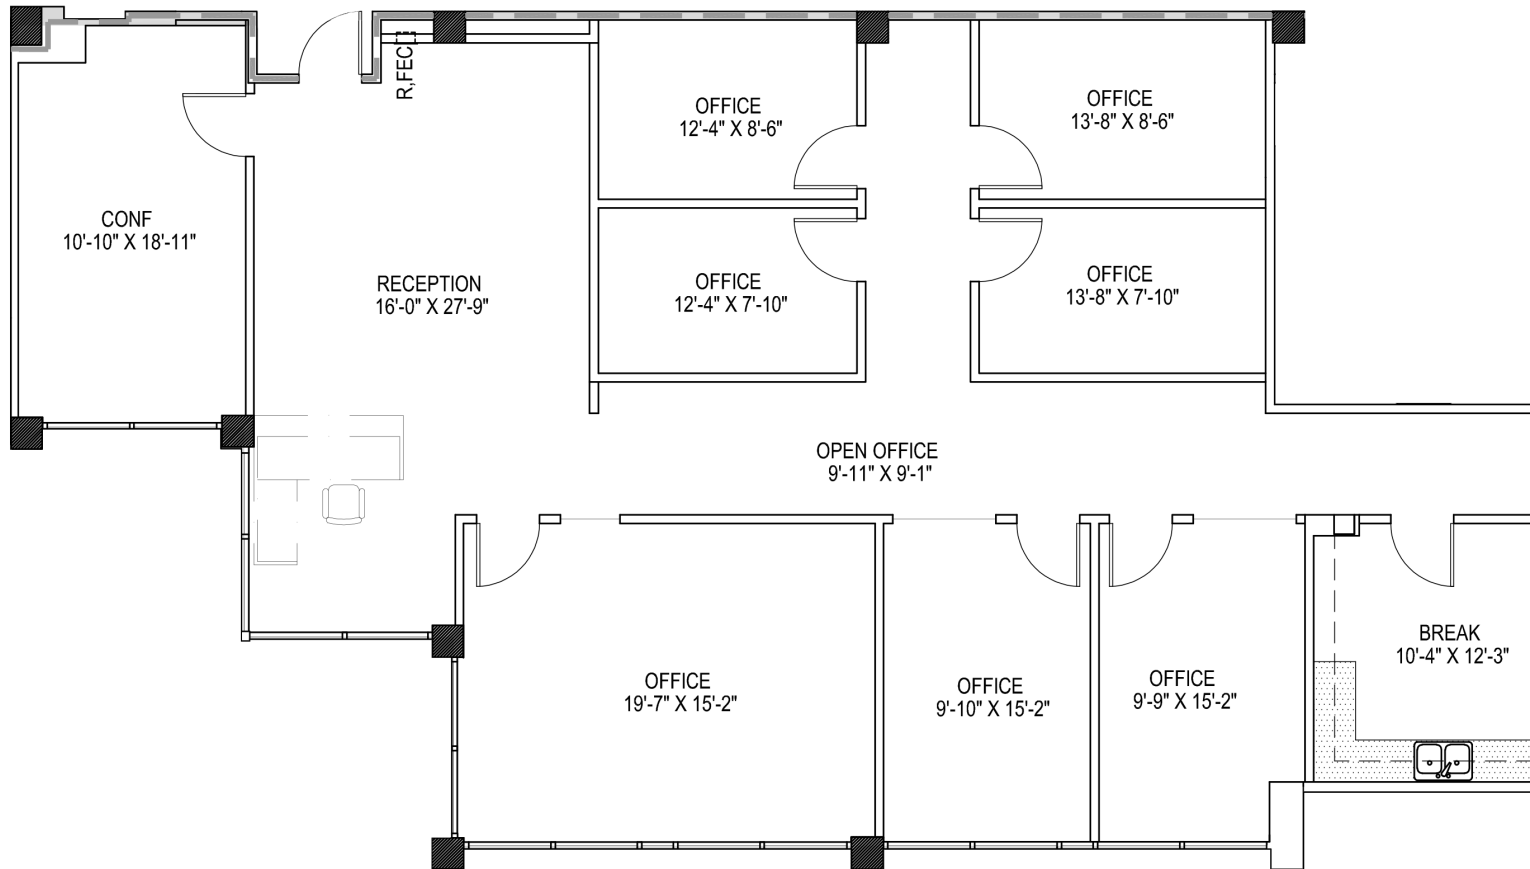

ANCHOR PLAZA
4343 Anchor Plaza Parkway
Tampa, FL 33634

No warranty or representation, expressed or implied, is made to the accuracy of information contained herein, and same is submitted subject to errors, change of price, rental or other conditions, withdrawal without notice, and to any special listing conditions imposed by our principals. PLANS NOT TO SCALE

BRAD MAYES
813.793.8642
Brad.Mayes@FranklinSt.com

MATT ALEXANDER
813.559.2006
Matthew.Alexander@FranklinSt.com

 **FranklinStreet**
Licensed Real Estate Broker | FranklinSt.com