
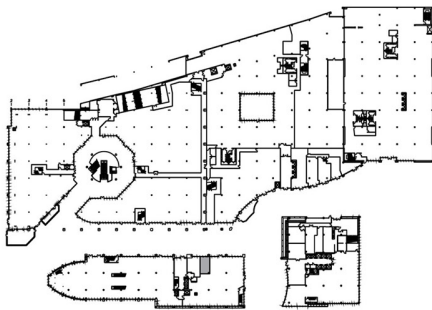


15301  
VENTURA

RETAIL

SUITE P21 | 545 RSF

SHERMAN OAKS/ENCINO

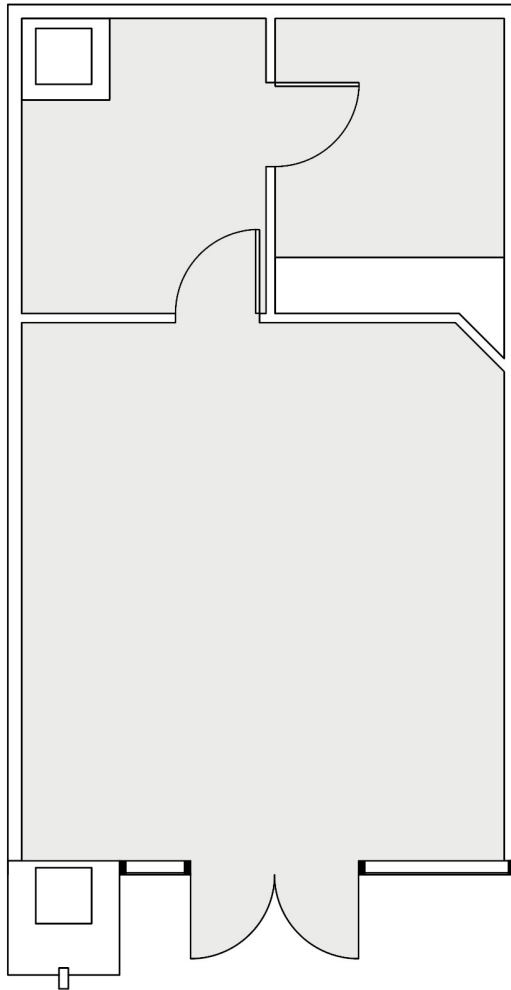

VENTURA

SEPULVEDA

AS-BUILT CONFIGURATION

NOT TO SCALE  
FURNITURE NOT INCLUDED

For more information, please contact:

CAMILLE PALEY  
310.855.2319  
camille.paley@douglasemmett.com

**Douglas  
Emmett**