




RADICE
CORPORATE CENTER

SUITE 260

1,295 SF

1000 CORPORATE DRIVE | FORT LAUDERDALE, FL

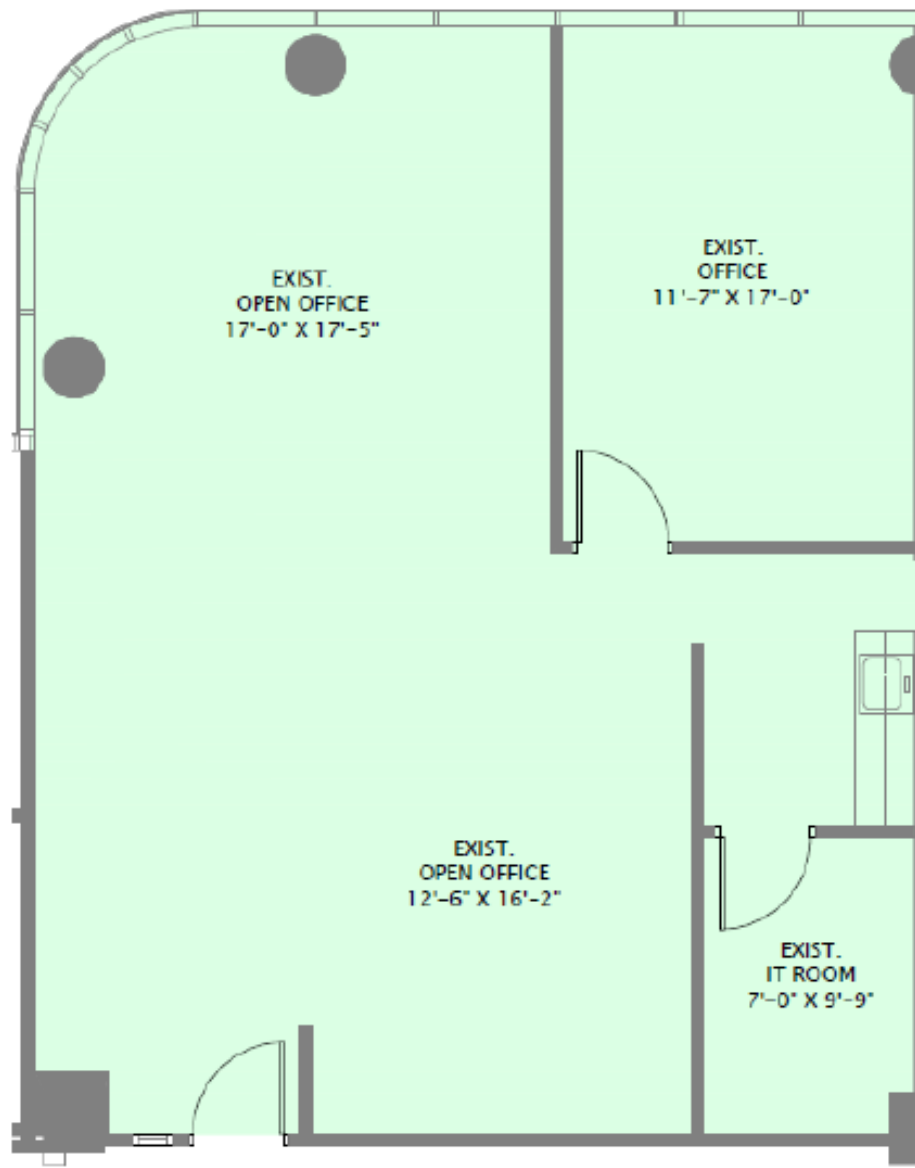

FOR MORE INFORMATION, PLEASE CONTACT

DEANNA LOBINSKY

Executive Director
+1 954 377 0489
deanna.lobinsky@cushwake.com

CHASE KULP

Senior Director
+1 954 377 0494
chase.kulp@cushwake.com

Cushman & Wakefield of Florida, LLC
515 E. Las Olas Blvd. | STE 900
Fort Lauderdale, Florida | 33301
Cushmanwakefield.com

