



1 EXISTING FLOOR PLAN
A1.1 SCALE: 1/4" = 1'-0"

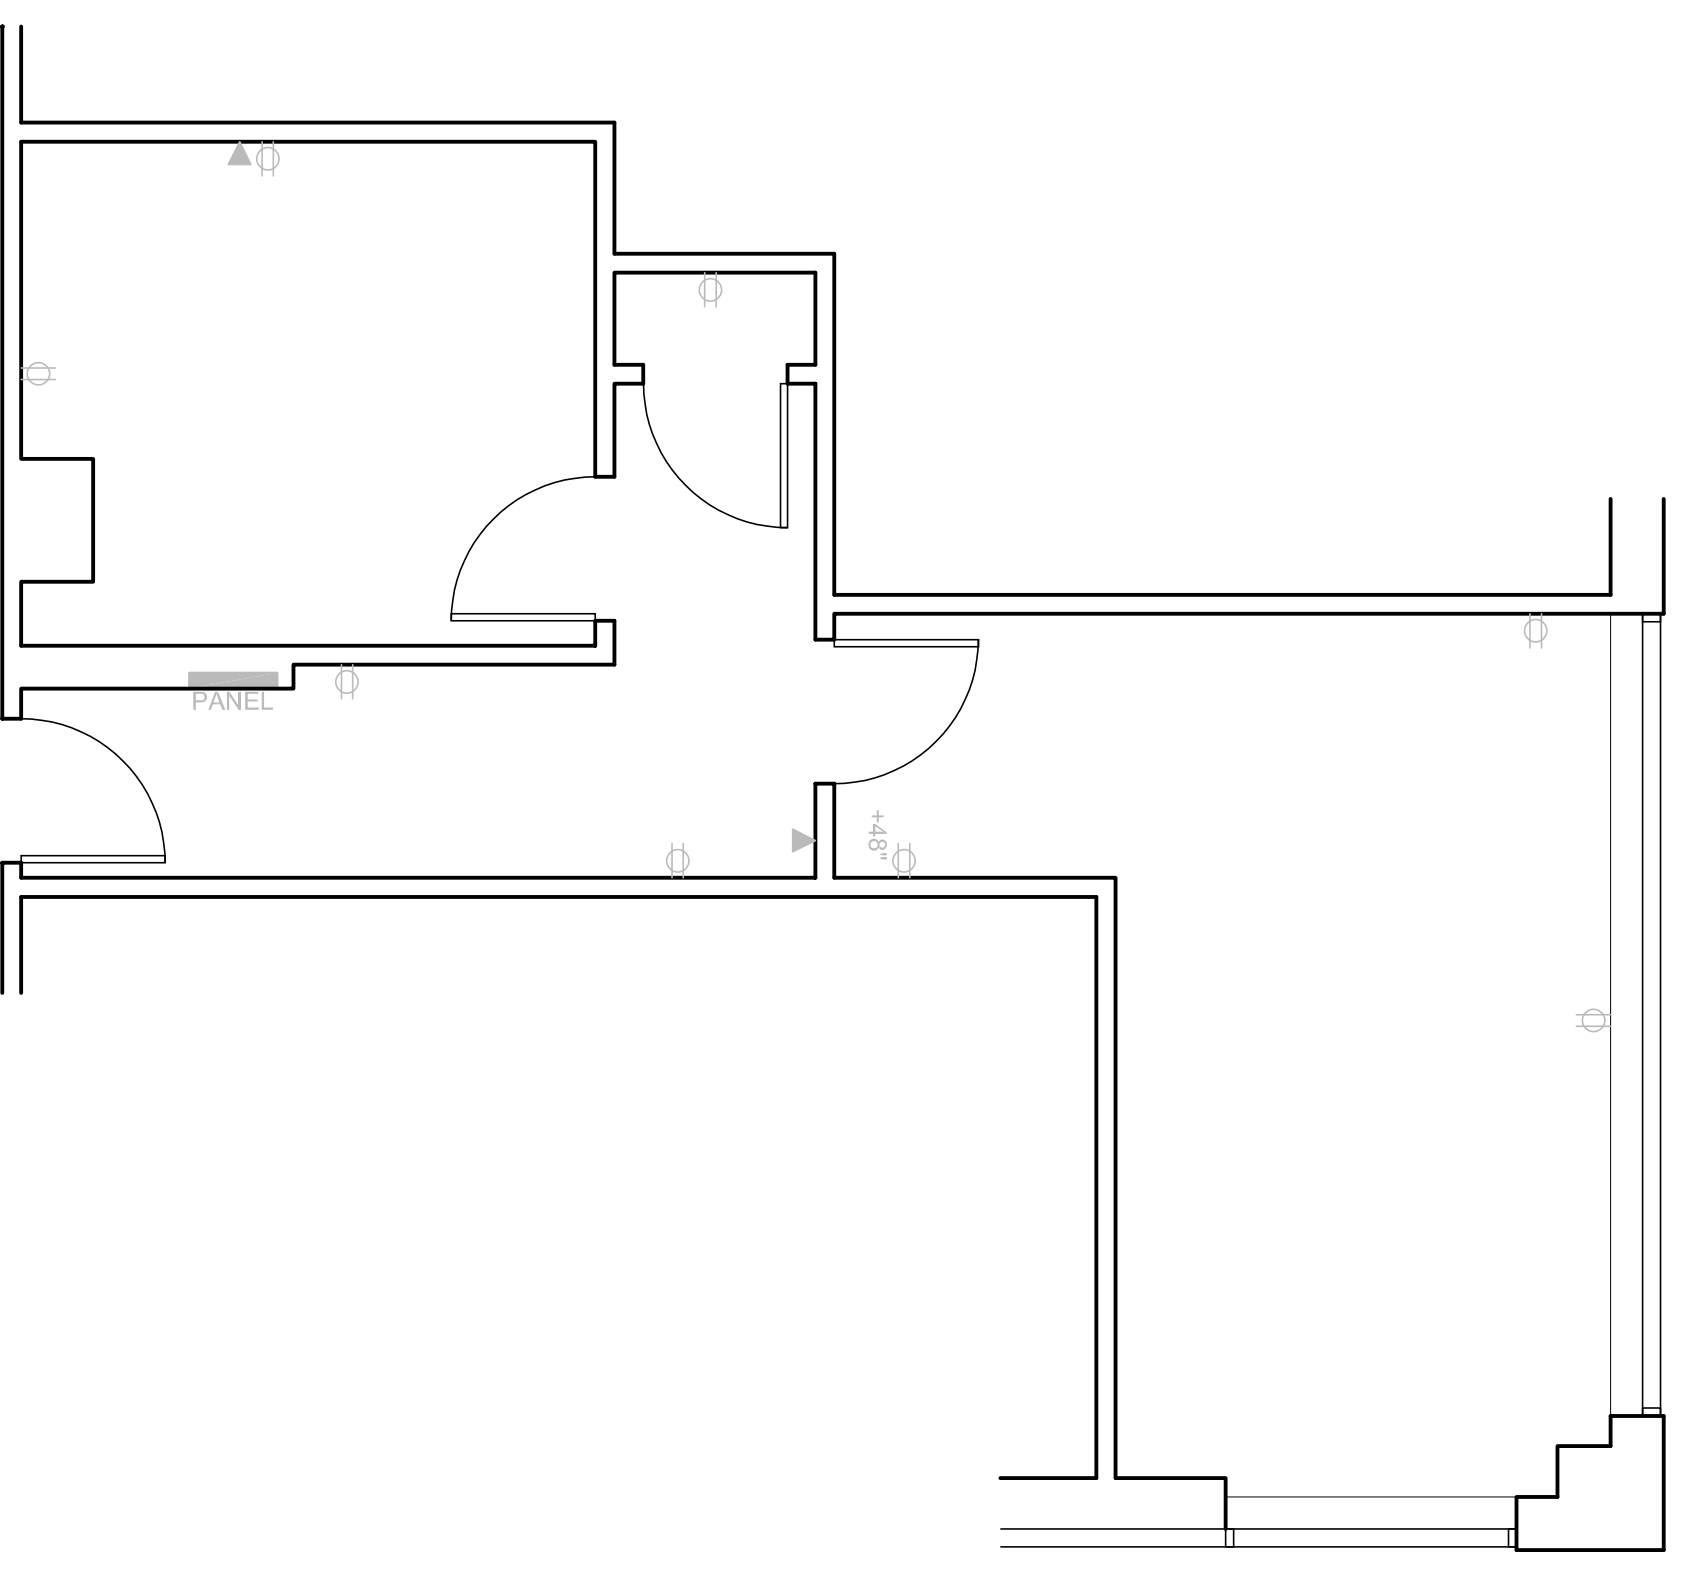

3 EXISTING ELECTRICAL PLAN
A1.1 SCALE: 1/4" = 1'-0"

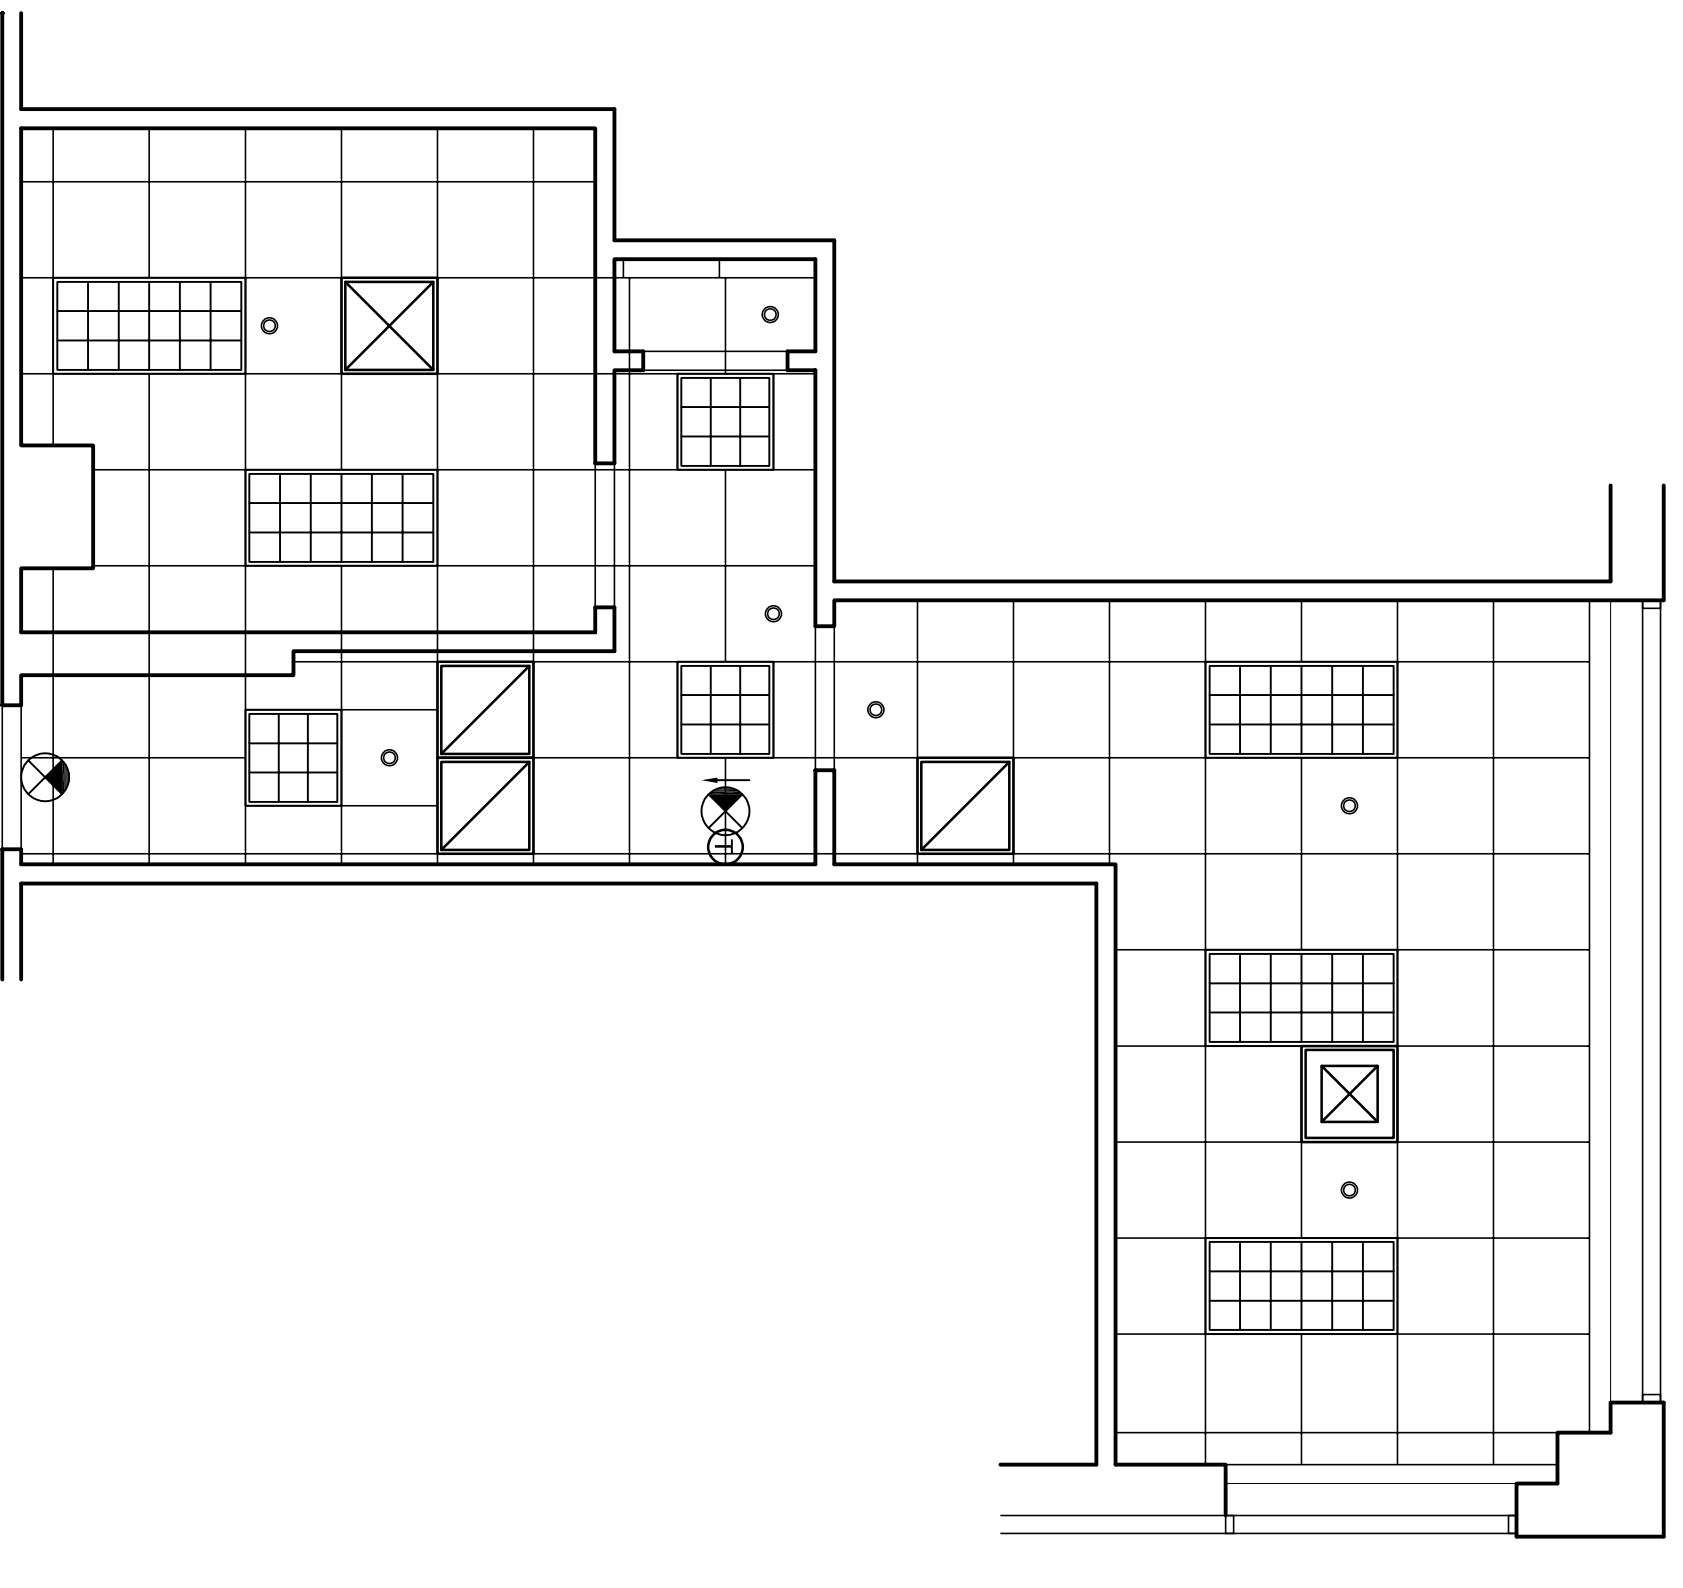

2 EXISTING REFLECTED CEILING PLAN
A1.1 SCALE: 1/4" = 1'-0"

REVISIONS		
NUMBER	DESCRIPTION	DATE

AS-BUILT DOCUMENTS
FOR
**PRINCE FREDERICK
MARKET SQUARE
SUITE 201**
PRINCE FREDERICK, MARYLAND

OWNER INFORMATION	
OWNER:	
ADDRESS:	
PHONE:	
EMAIL:	

LAWRENCE ABELL & ASSOCIATES LTD ARCHITECTS - PLANNERS	
ARCHITECT INFORMATION	
CONTACT:	STEPHEN ABELL
ADDRESS:	314 EAST CHARLES STREET LA PLATA, MD 20646
PHONE:	301-332-1900
EMAIL:	SABELL@LAA.CO

EXISTING FLOOR PLANS	
PROJECT NUMBER:	28-040.01
DATE:	01-12-2026
DRAWN BY:	A.H.
CHECKED BY:	S.A.

SCALE: AS NOTED

A1.1