



10509 San Diego Mission Rd.
San Diego, 92108

9.7.2010

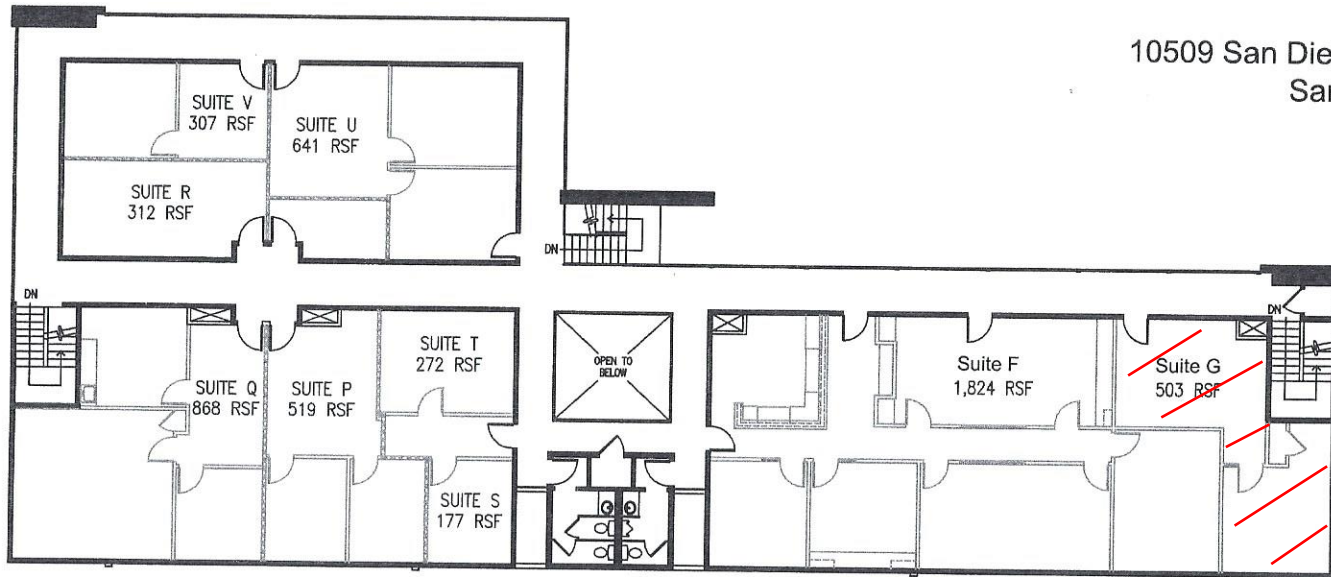

AS BUILT PLAN - Second Floor

SCALED TO FIT

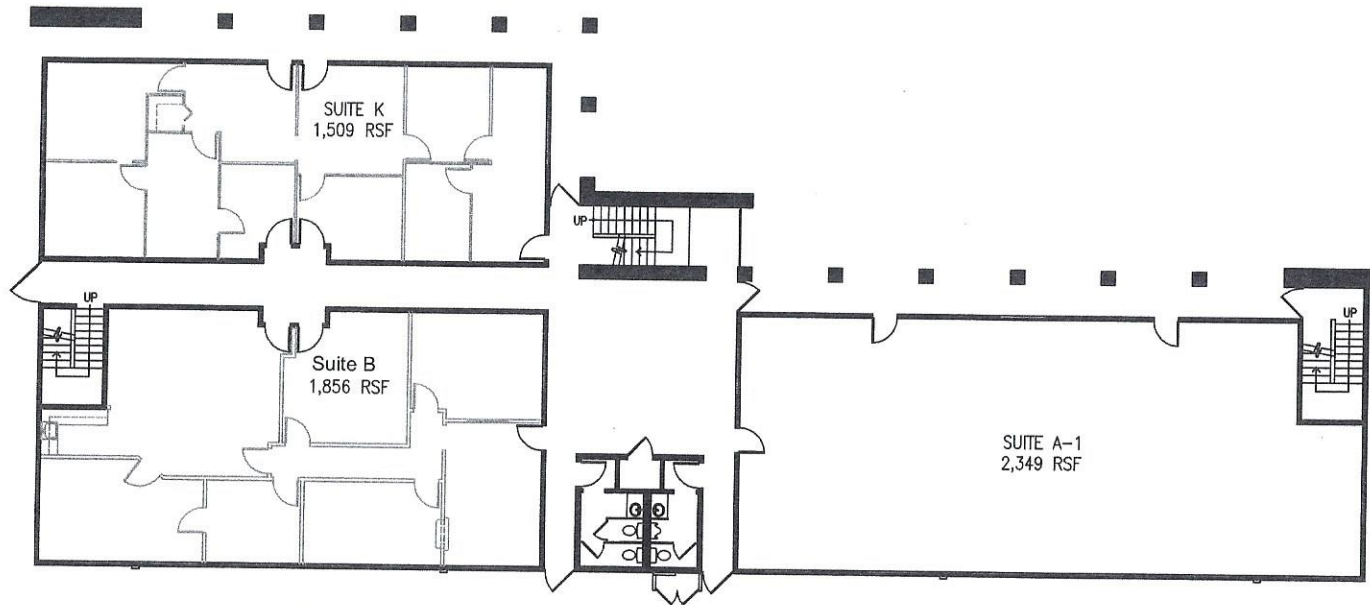

AS BUILT PLAN - First Floor

SCALED TO FIT