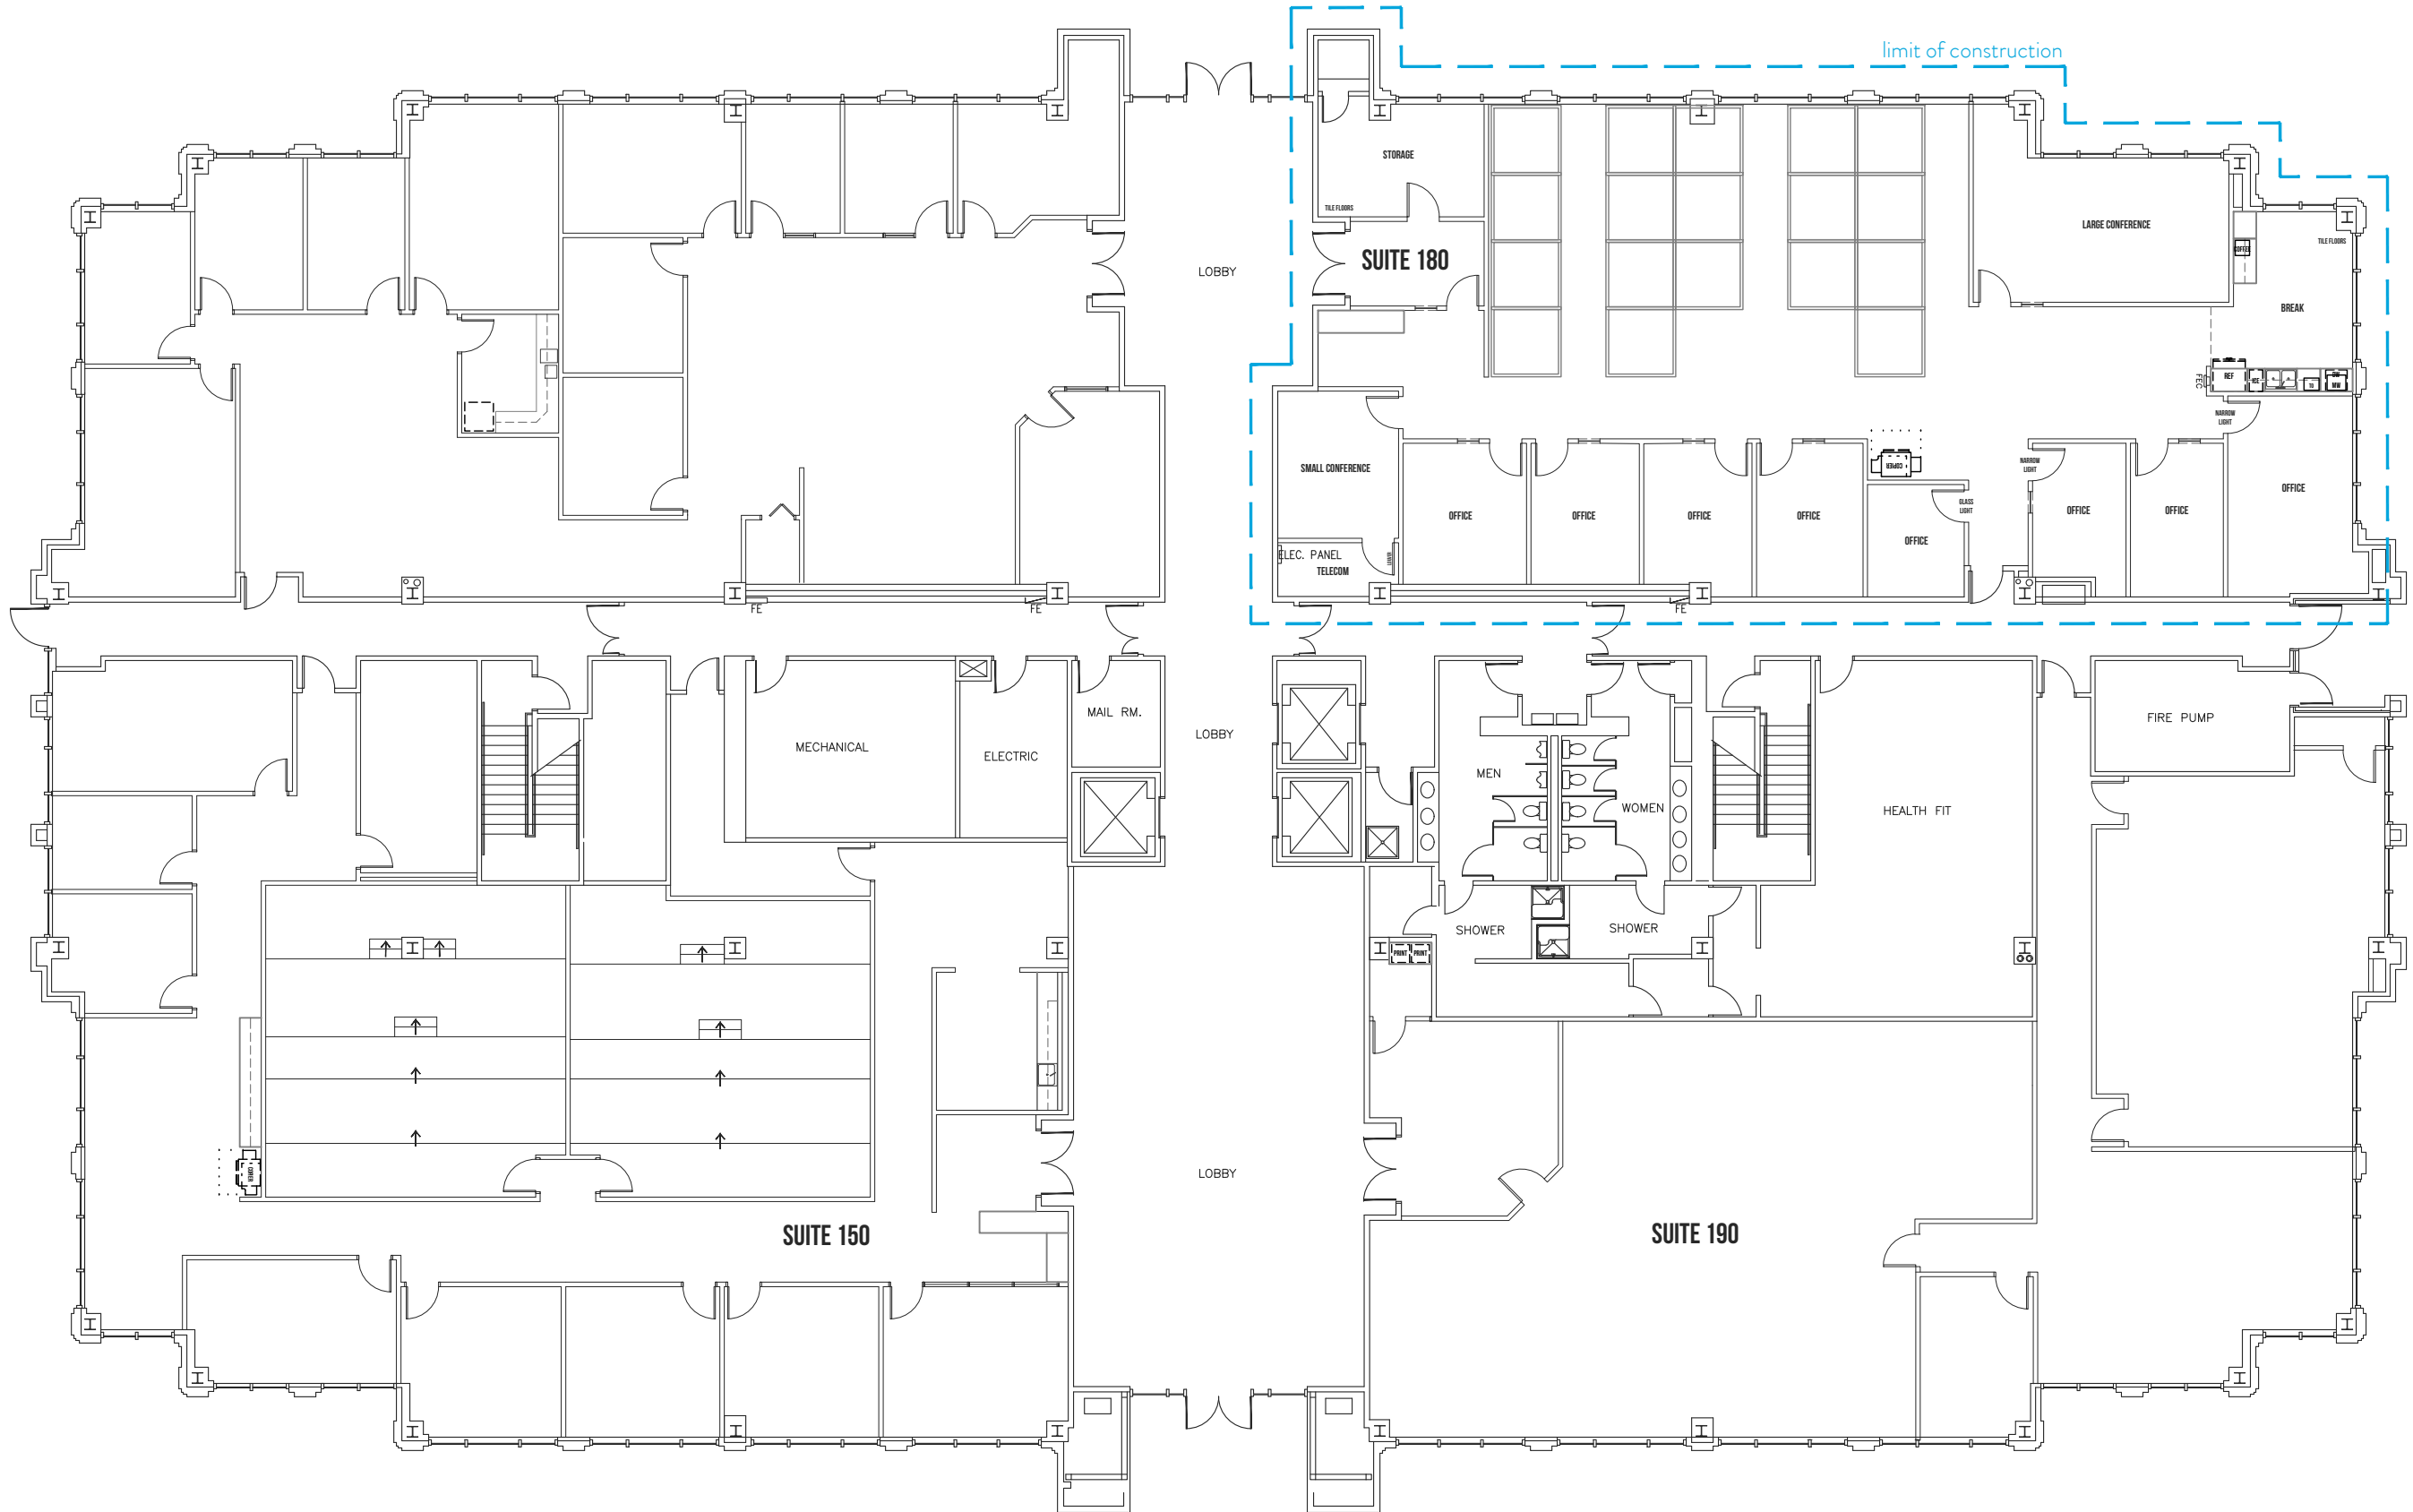


ELEVATE
DESIGN
©2016 ELEVATE DESIGN, LLC. ALL RIGHTS RESERVED.

1st Floor @ Two Meridian
AS-BUILT

ISSUE DATE: 02.09.2023

SCALE: 1/16"=1'-0" 16' 8' 0 16'