
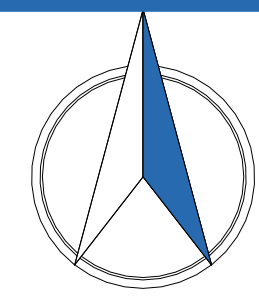


Property Key

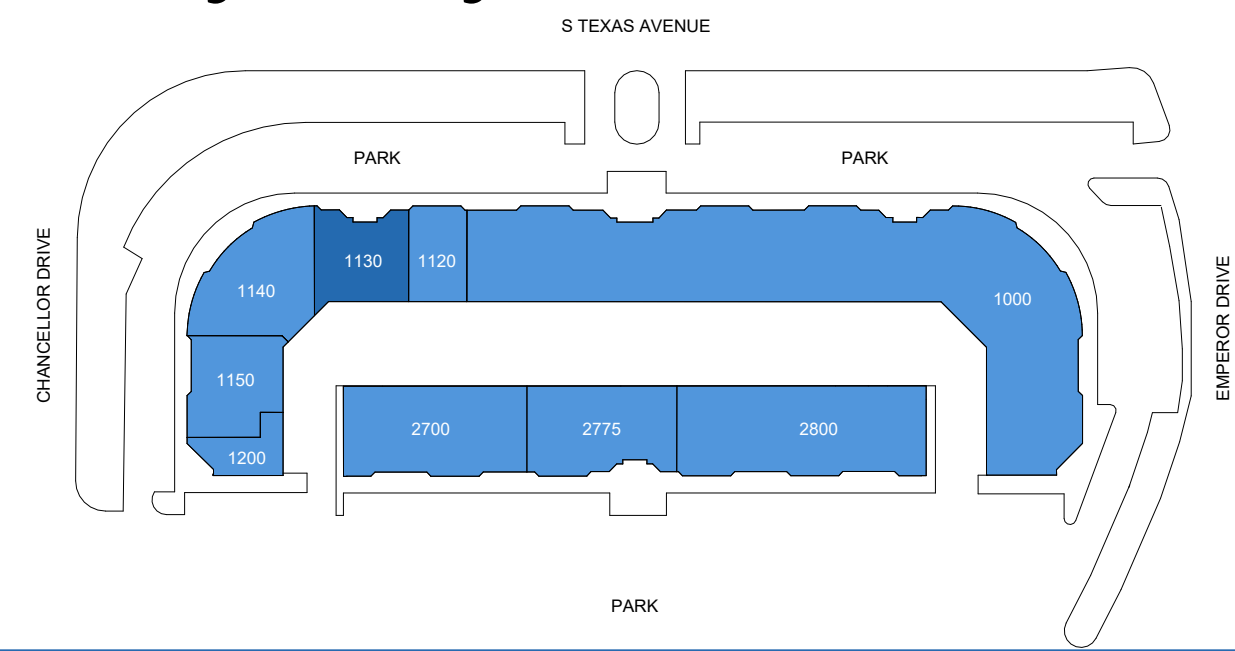

Lakefront As Built Marketing Package


6101 Chancellor Dr, Orlando, FL 32809, US

Building: 6101

Suite: 1130

Sheet **E1**

Scale: Not to Scale
Sheet Size: 42" x 30"
Not For Construction

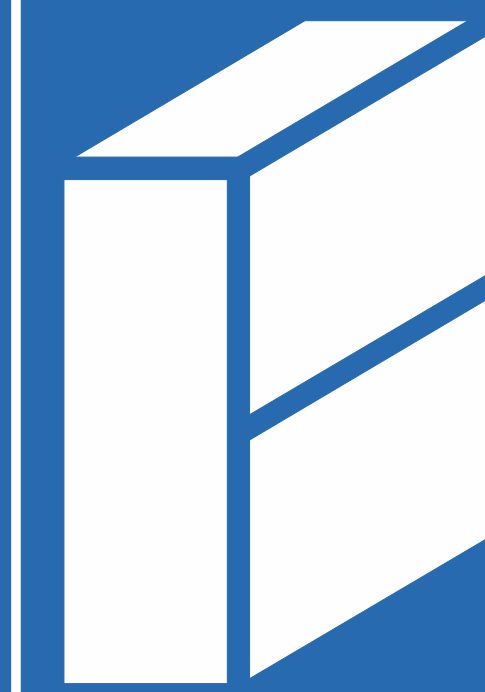


BAY SPACE

Usable Square Foot Analysis

Office Area	5,827	100 %
Warehouse Area	0	0%
Total Area	5,827	

Building Information

Deck Height:	16' - 5"
Clear Height:	9' - 6 1/4"
Ceiling Height:	N/A
Sprinklered:	<input type="checkbox"/> Yes <input checked="" type="checkbox"/> No
Mechanical Area:	0 SQFT

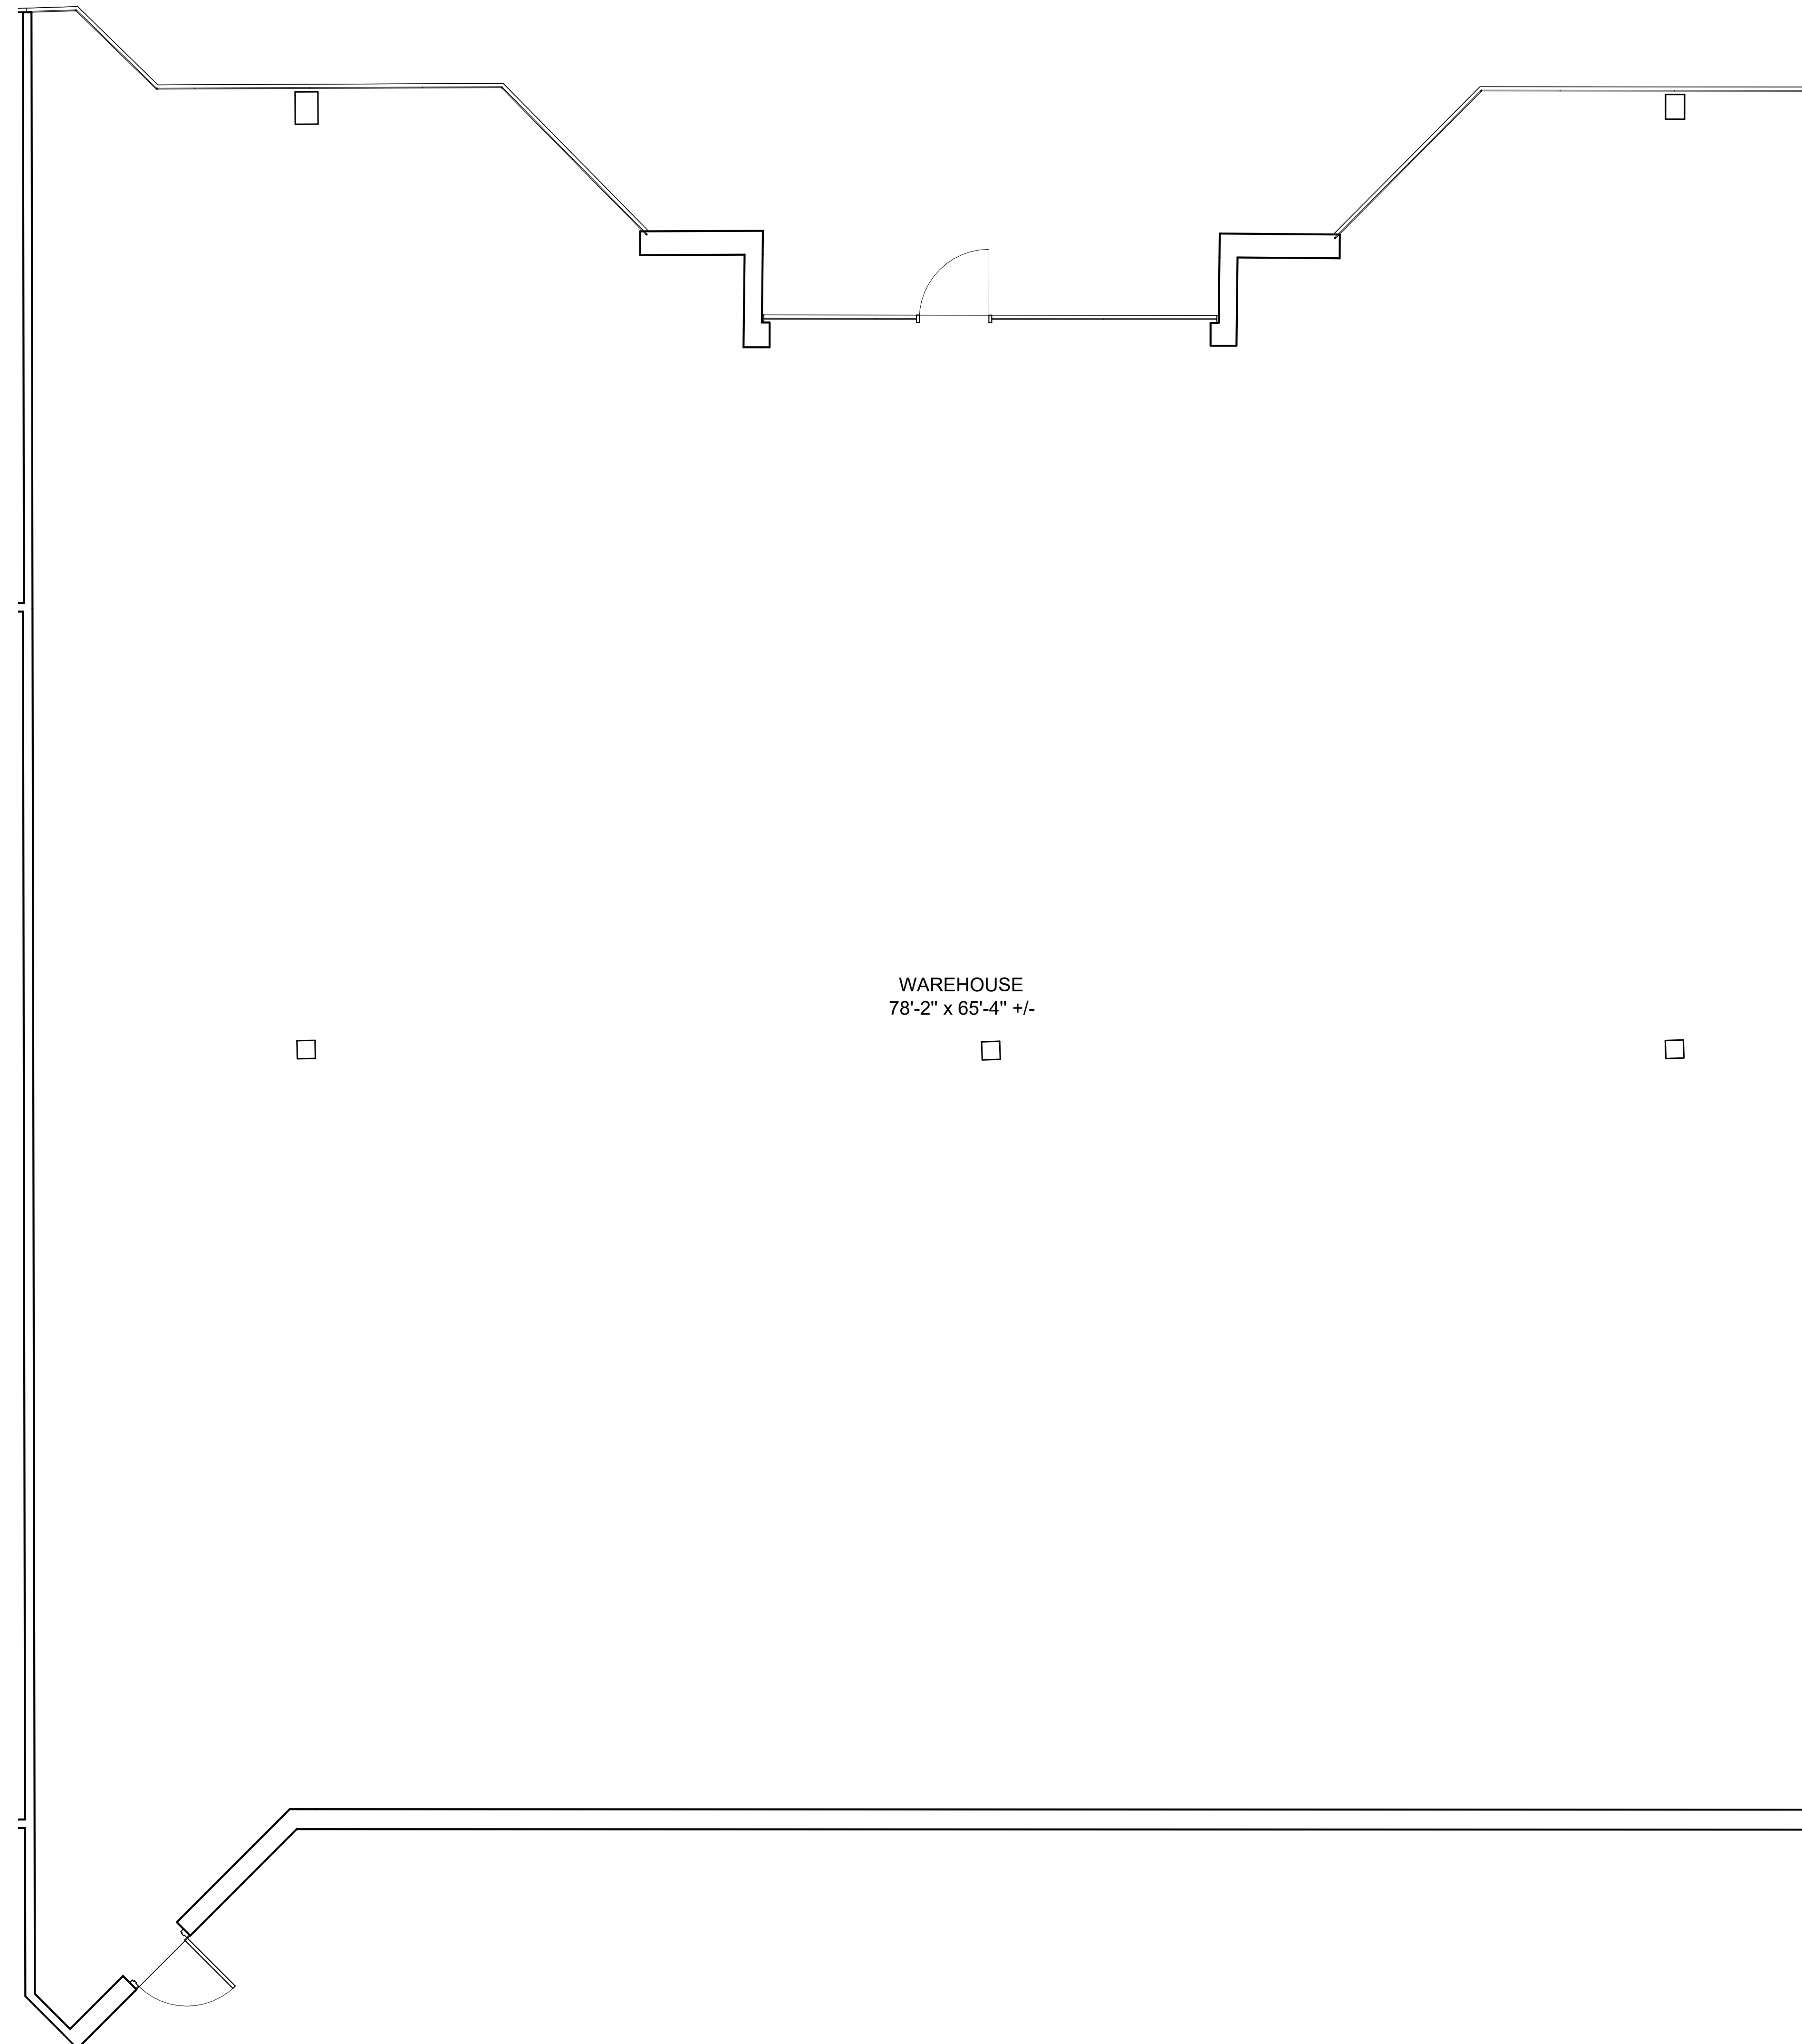

WAREHOUSE
78'-2" x 65'-4" +/-

① 1130
1/4" = 1'-0"

As Built Floor Plan for Marketing

