


**SUITE 102**

AVAILABLE: 4,106-8,889 RSF

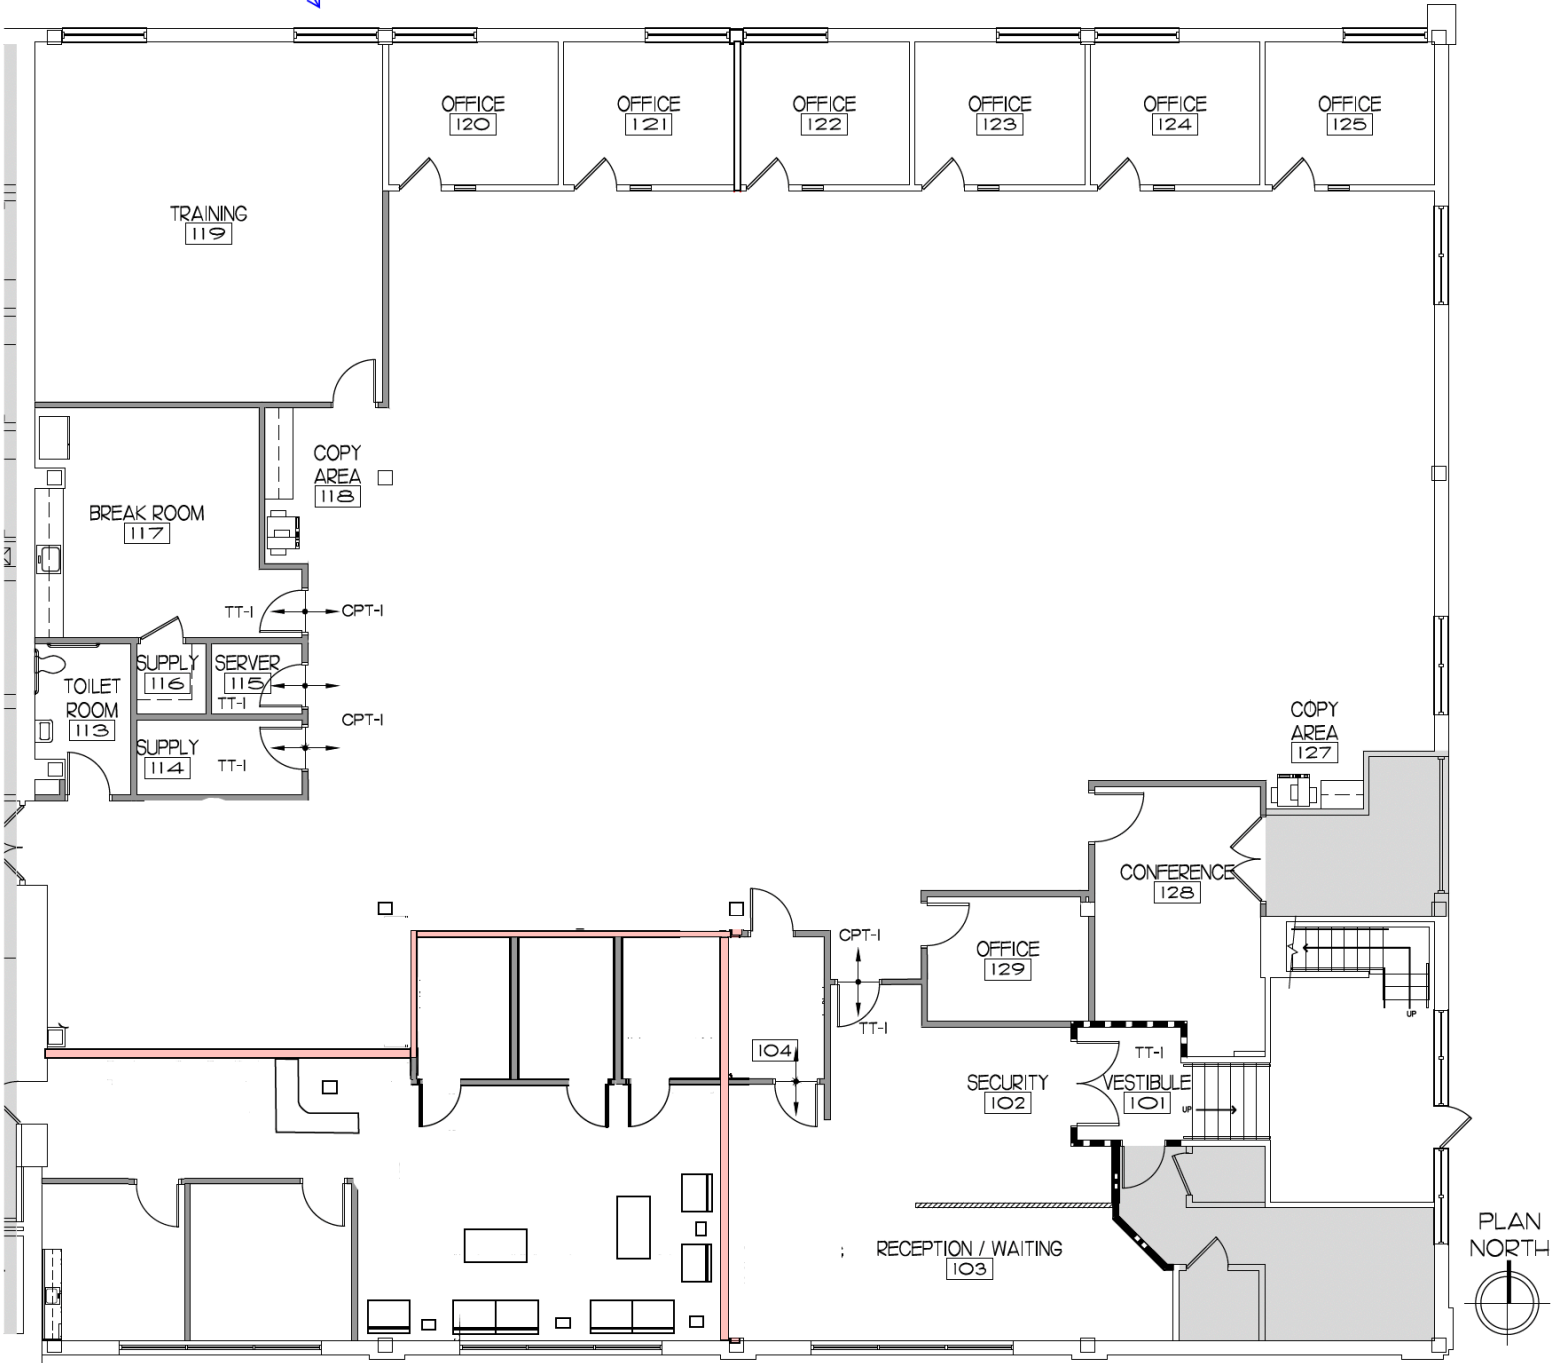

1 FINISH PLAN  
10-7 1/8" = 1'-0"

**SUITE 104**

AVAILABLE: 1,411 RSF