
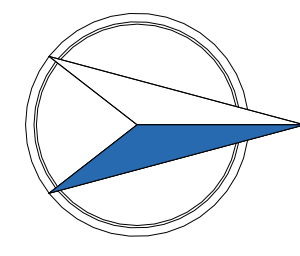


Property Key

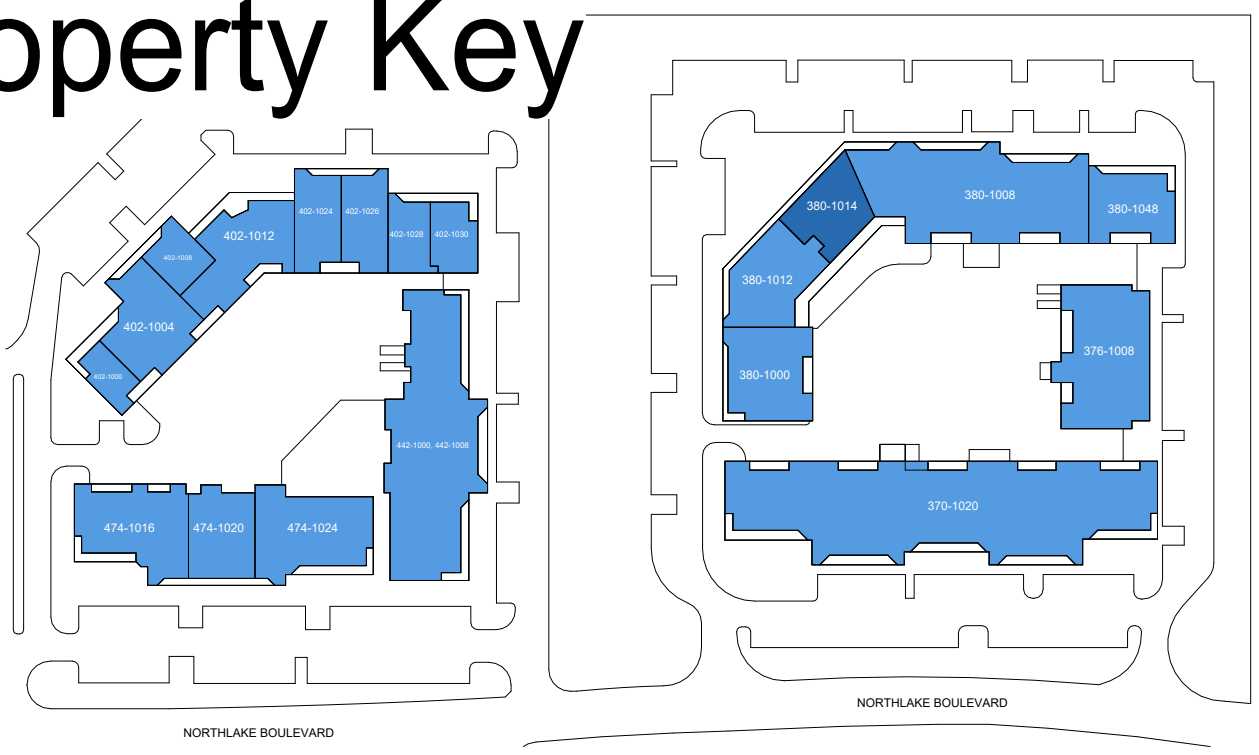

Alt Springs As Built Marketing Package

380 Northlake Blvd, Alt Springs, FL 32701, US

Building: 380

Suite: 1014

Sheet **E1**

Scale: Not to Scale
Sheet Size: 42" x 30"
Not For Construction




BAY SPACE

Usable Square Foot Analysis

Office Area	2,224	100 %
Warehouse Area	0	0%
Total Area	2,224	

Building Information

Deck Height:	13' - 9 1/2"	
Clear Height:	10' - 9"	
Ceiling Height:	9' - 0 1/2"	
Sprinklered:	<input checked="" type="checkbox"/> Yes	<input type="checkbox"/> No
Mechanical Area:	622 SQFT	

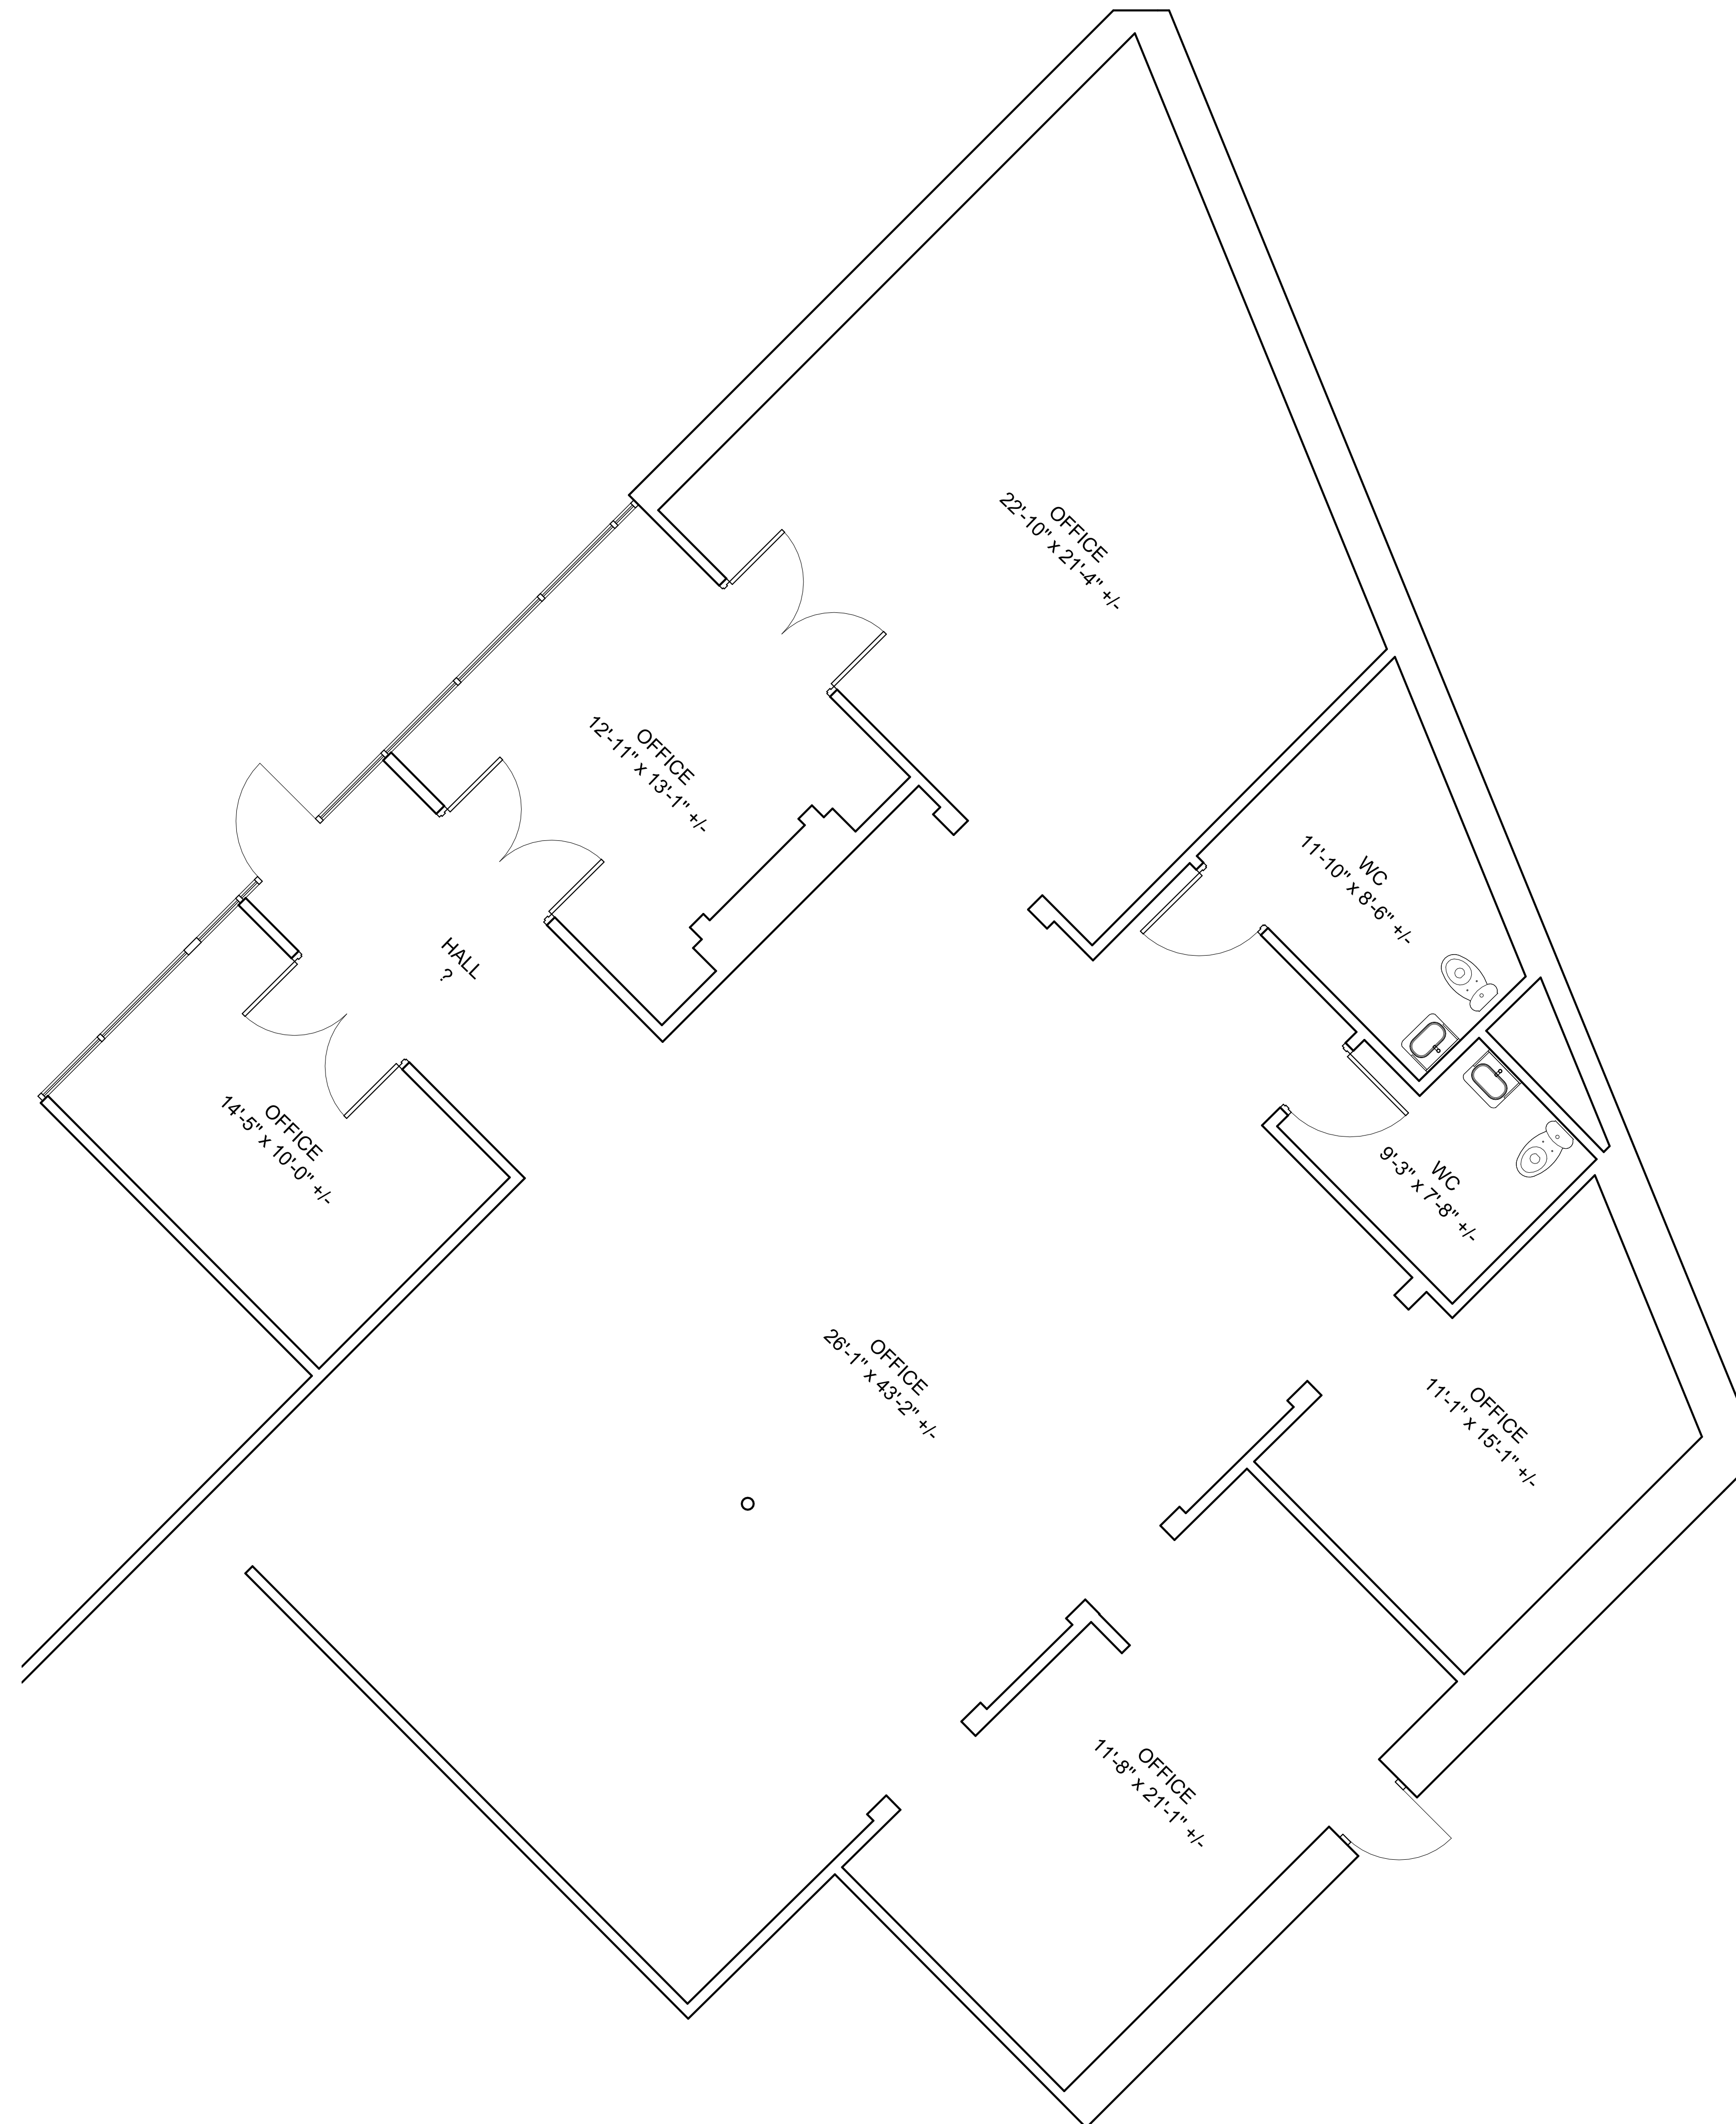

As Built Floor Plan for Marketing

