



2420 17th Street
Lower Highlands

Jamie Gard

Vice Chairman

tel. 303-260-4341

jamie.gard@nmrk.com

Whitney Hake

Senior Managing Director

tel. 303-260-4202


whitney.hake@nmrk.com

Grace Lessard

Associate Director

tel. 303-260-4210

grace.lessard@nmrk.com

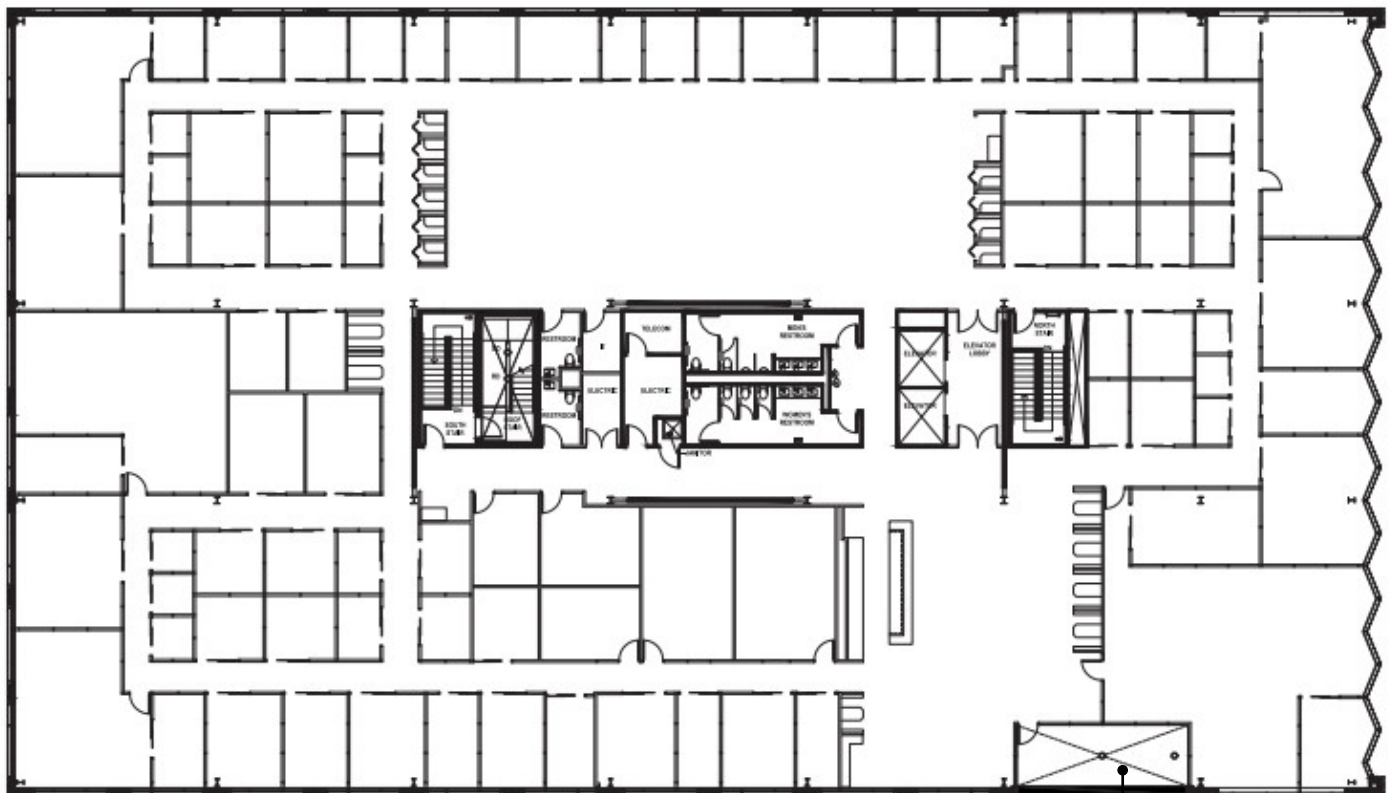

Private Outdoor
Balcony



Floor 4

As-Built | 24,983 RSF

NEWMARK