


EXISTING WALL
EXISTING FIRE RATED WALL

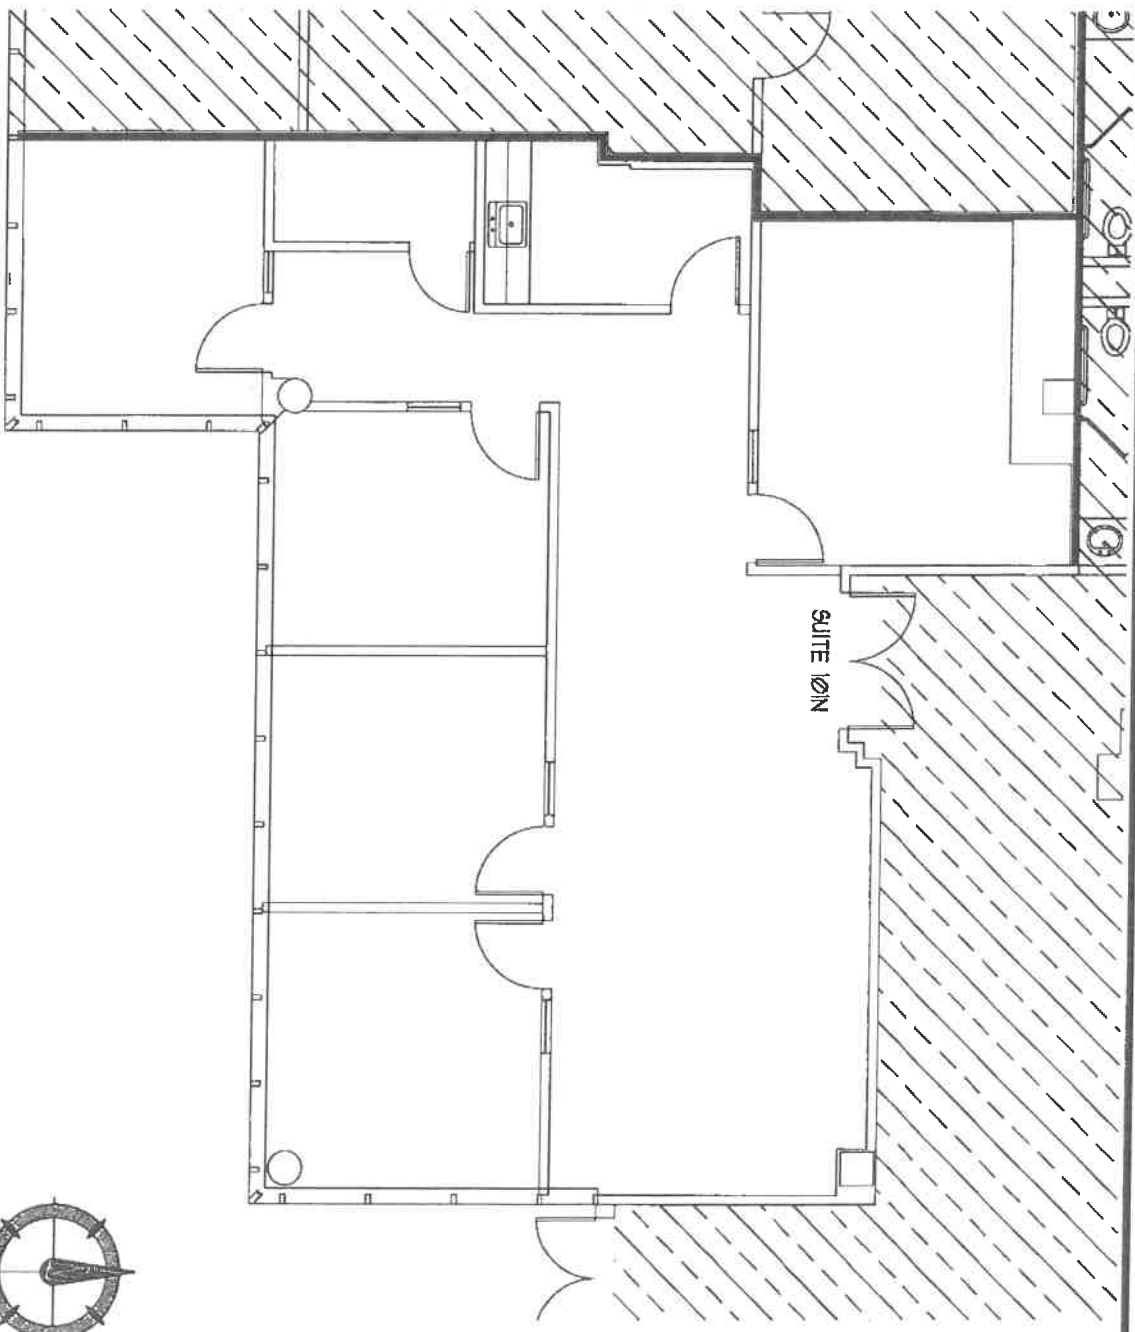

TRIESCHMANN DUMALA

architectural group
6451 EAST ROGERS CIRCLE | SUITE 9 | BOCA RATON | FL 33487
P: 561.981.8000
AA26002244

AA26002252

WWW.TDARCHGROUP.COM

SUITE 101N

INTERNATIONAL PLAZA - NORTH BUILDING
AS-BUILT PLAN

NOTE: SPACE NEEDS TO BE REVERIFIED DUE TO SITE CONDITIONS
NOTE: FURNITURE FOR ILLUSTRATION PURPOSES ONLY
NOTE: ROOM SIZES ARE APPROXIMATE

SCALE : 1/8" = 1'
DRAWN : JS
07/28/16