


Property Key

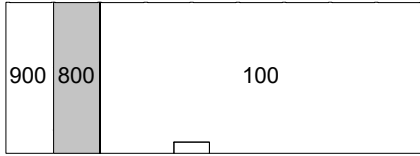

WMGSA Roosevelt As Built Marketing Package

10901-11001 Roosevelt Boulevard and 1000 112th Circle, St. Petersburg, FL 33716

Building: 2D
Suite: 2D-800
Sheet: A-2

Scale: Not to Scale
Sheet Size: 8.5" x 11"
Not For Construction




BAY SPACE

Total Area - 2,052 SF

Building Information

DECK HEIGHT:	N/A
CEILING HEIGHT:	8'-6"
CLEAR HEIGHT:	8'-6"
SPRINKLERED:	No

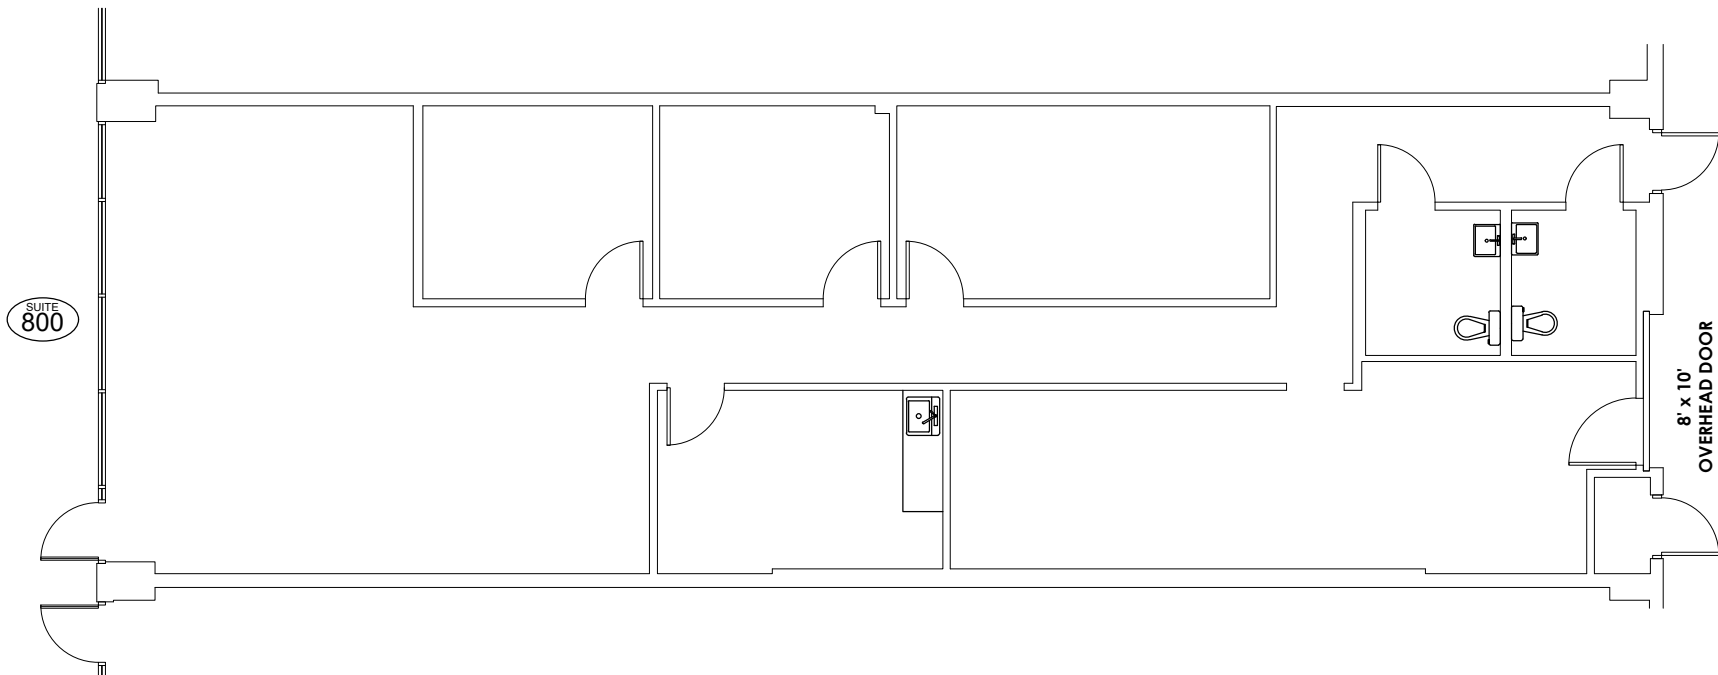

8' x 10'
OVERHEAD DOOR

