
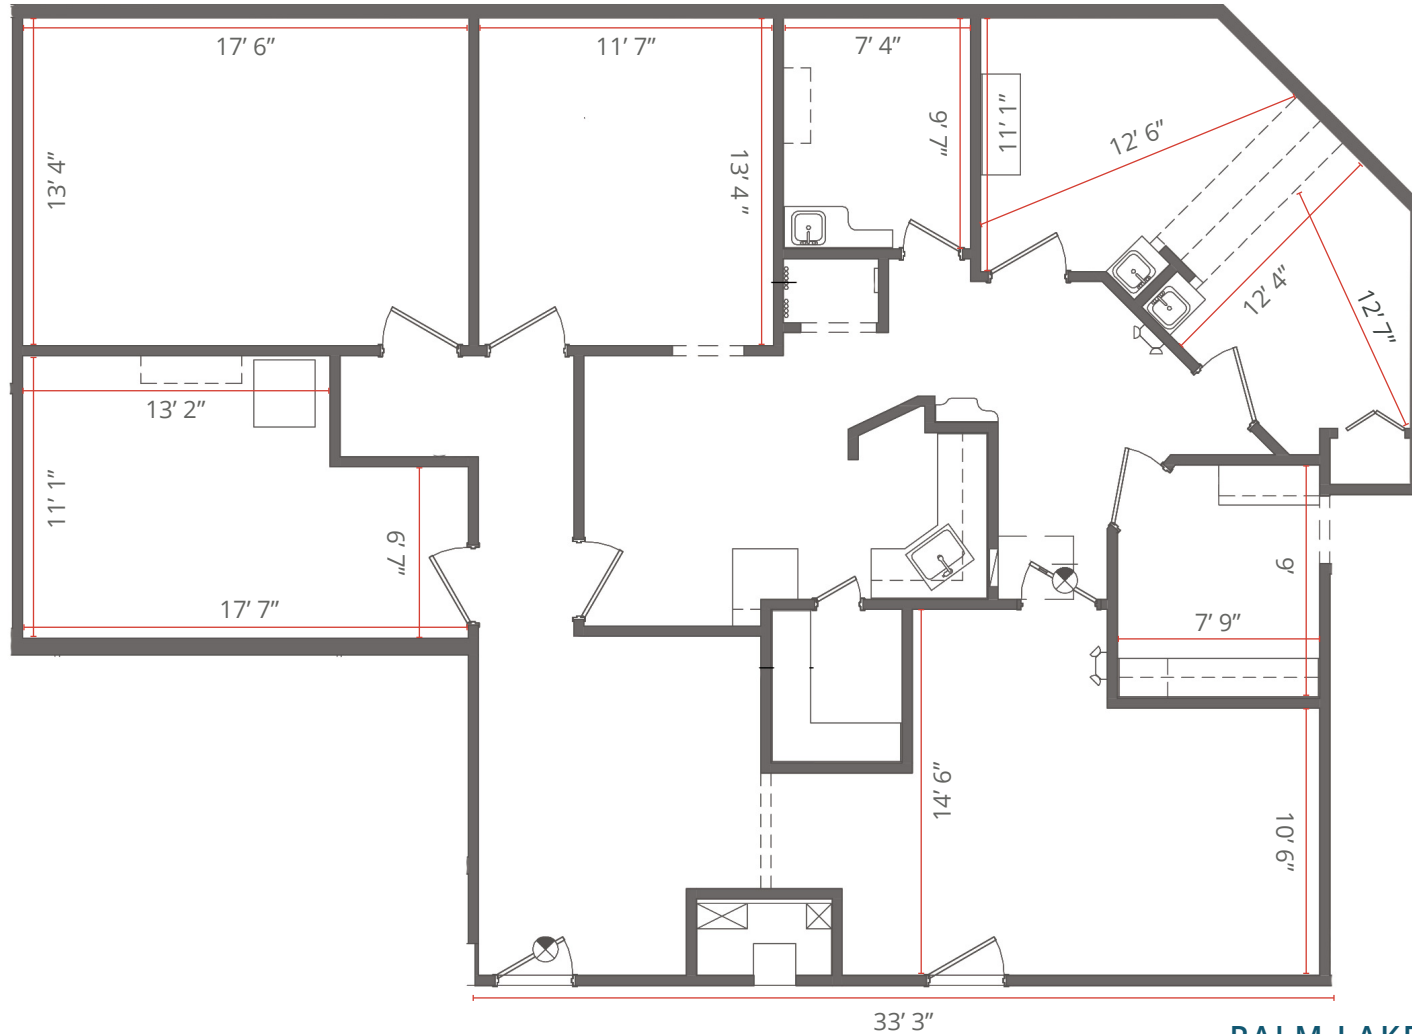


SPACE AVAILABLE

# SUITE 195: 2,097 RSF

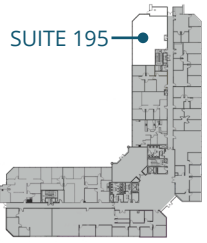

**PALM LAKE AT TAMPA PALMS**  
15310 Amberly Drive  
Tampa, FL 33647

No warranty or representation, expressed or implied, is made to the accuracy of information contained herein, and same is submitted subject to errors, change of price, rental or other conditions, withdrawal without notice, and to any special listing conditions imposed by our principals. PLANS NOT TO SCALE

**LORENZO GONZALEZ** | SENIOR ASSOCIATE  
813.793.8461 | Lorenzo.Gonzalez@FranklinSt.com

**CLAY WOMMACK** | SENIOR DIRECTOR  
813.345.58886 | Clay.Wommack@FranklinSt.com

**FranklinStreet**  
Licensed Real Estate Broker | FranklinSt.com