
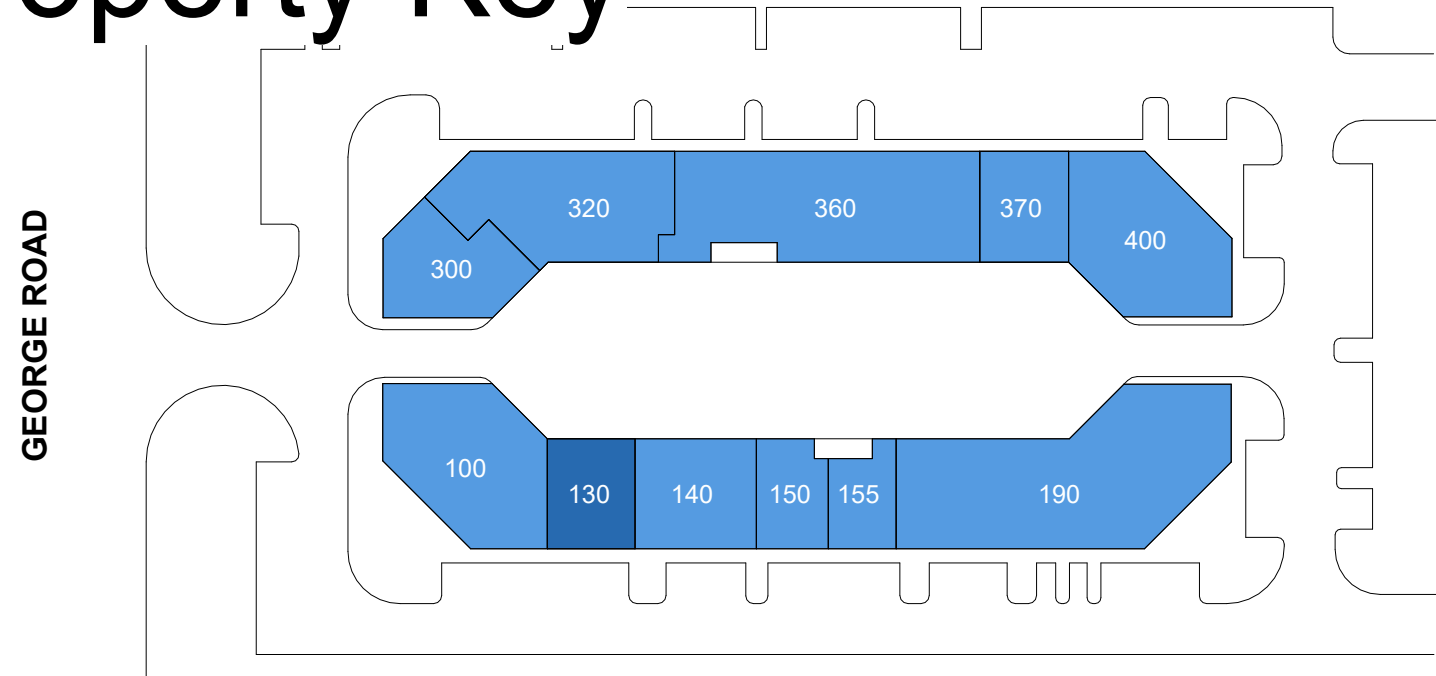


Property Key

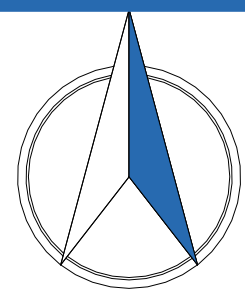


Presidents As Built Marketing Package

4801 - 4803, George Rd, Tampa, FL 33634, US

Building: 4803
Suite: 130
Sheet **E1**

Scale: Not to Scale
Sheet Size: 42" x 30"
Not For Construction

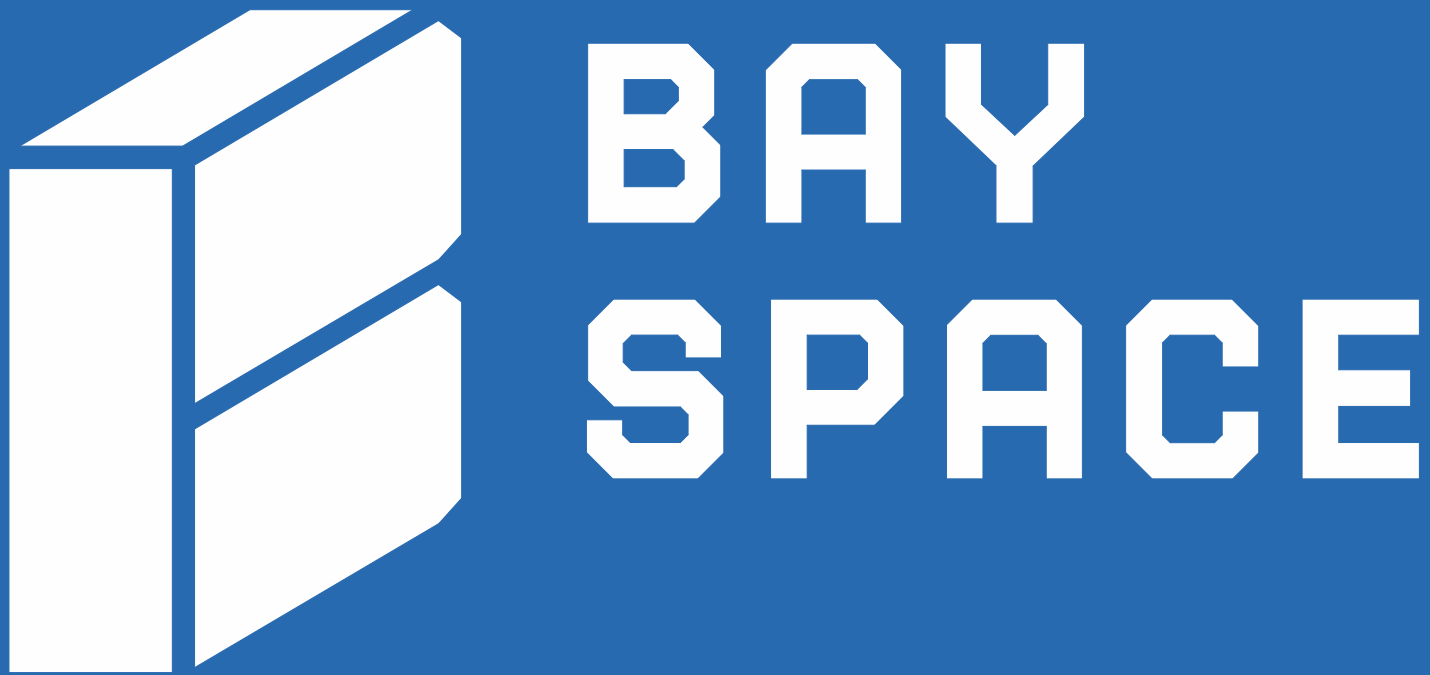

Usable Square Foot Analysis

Office Area	3,464	100 %
Warehouse Area	0	0%
Total Area	3,464	

Building Information

Deck Height:	16' - 1"
Clear Height:	8' - 6 1/2"
Ceiling Height:	7' - 8"
Sprinklered:	☒ Yes ☐ No
Mechanical Area:	15 SQFT

