


# Property Key

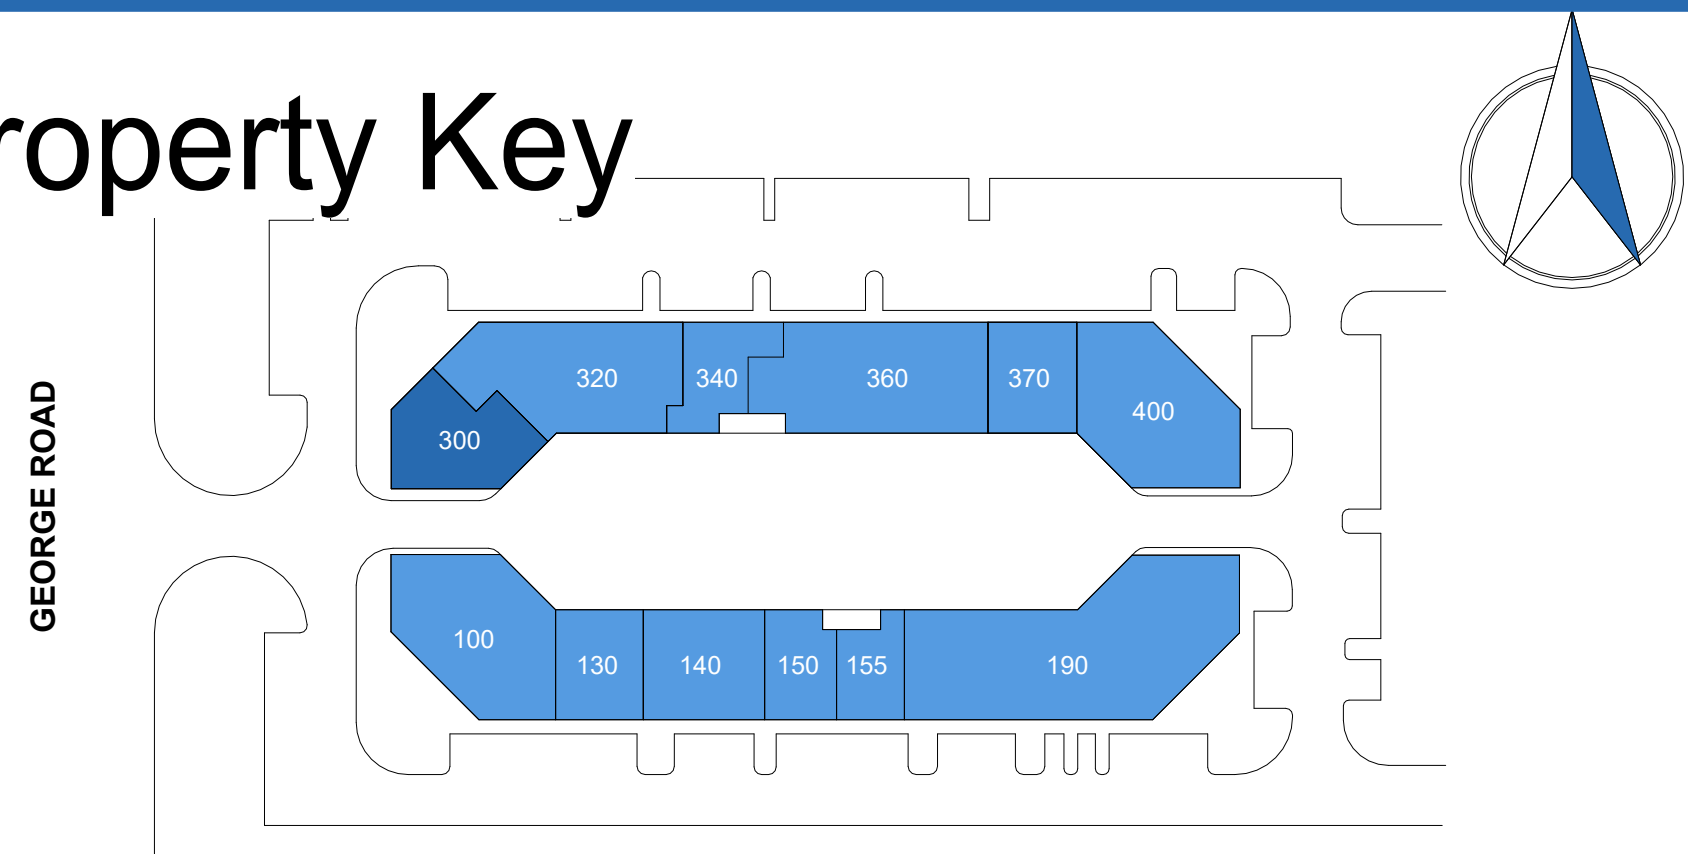

# Presidents As Built Marketing Package


4801 - 4803, George Rd, Tampa, FL 33634, US

Building: 4803

Suite: 300

Sheet **E1**

Scale: Not to Scale  
Sheet Size: 42" x 30"  
Not For Construction

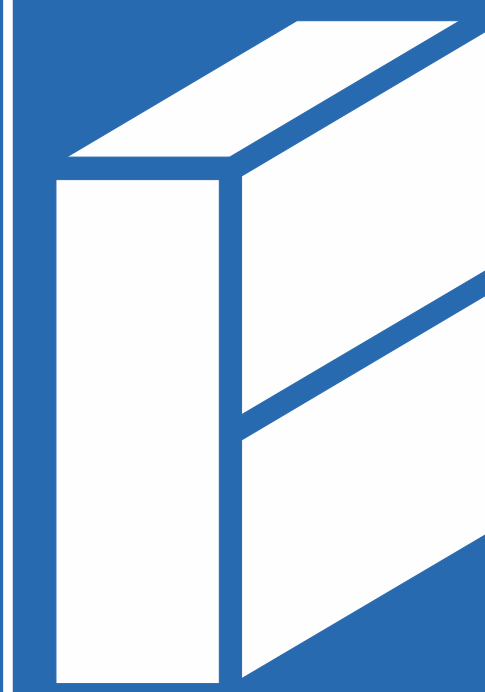

# BAY SPACE

## Usable Square Foot Analysis

Office Area	2,755	100 %
Warehouse Area	0	0%
Total Area	2,755	

## Building Information

Deck Height:	16' - 1"
Clear Height:	8' - 10"
Ceiling Height:	7' - 11"
Sprinklered:	<input checked="" type="checkbox"/> Yes <input type="checkbox"/> No
Mechanical Area:	0 SQFT

