


# Property Key

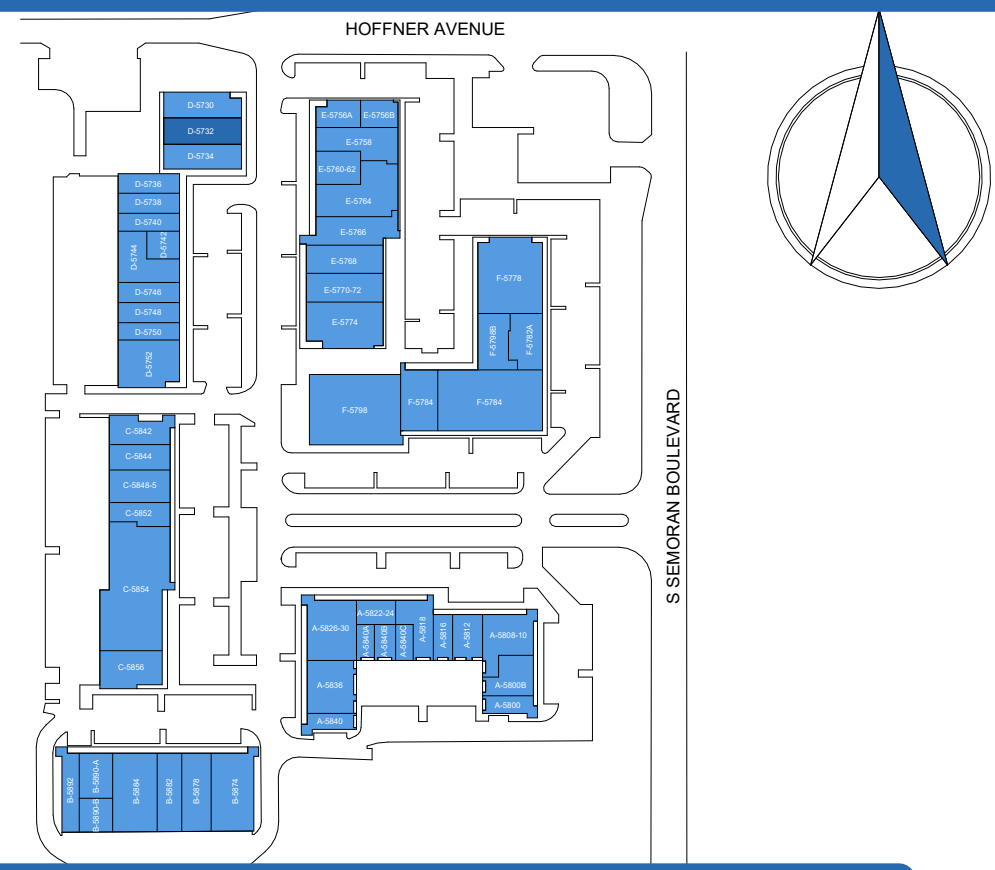


# OBIC As Built Marketing Package

5730-5892 S Semoran Blvd, Orlando, FL 32809, US

Building Number: 5730

Suite: 5732

Sheet **E1**

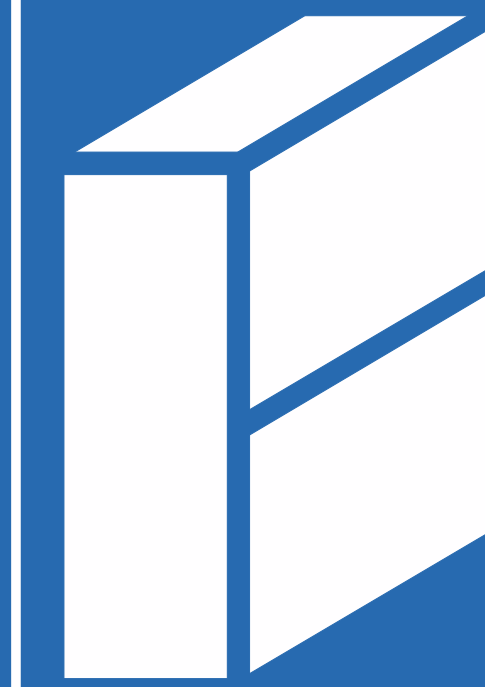

# BAY SPACE

Scale: Not to Scale  
Sheet Size: 42" x 30"  
Not For Construction

## Usable Square Foot Analysis

Office Area	2,958	100 %
Warehouse Area	0	0%
Total Area	2,958	

## Building Information

Deck Height:	N/A
Clear Height:	N/A
Ceiling Height:	N/A
Sprinklered:	<input type="checkbox"/> Yes <input checked="" type="checkbox"/> No
Mechanical Area:	0 SQFT

