


Property Key

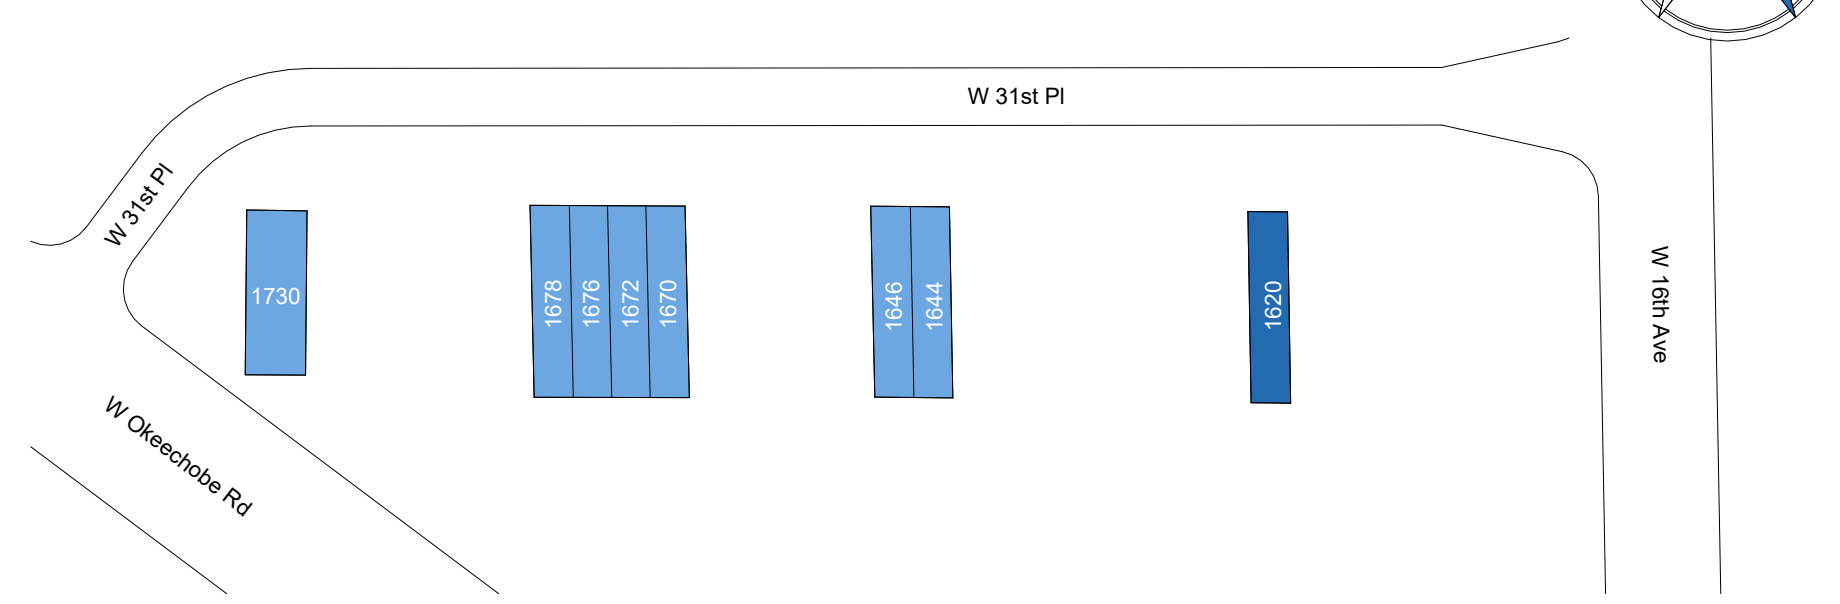

Hialeah Buildings

1620 W 31st St, Hialeah, FL 33012

Building: 1

Suite: 1620

Sheet **E1**



BAY SPACE


Scale: Not to Scale
Sheet Size: 42" x 30"
Not For Construction

Usable Square Foot Analysis

| | SQFT | BUILDING PERCENTAGE |
|----------------|------|---------------------|
| Office Area | 0 | 0% |
| Warehouse Area | 0 | 0% |
| Total Area | 0 | |

Building Information

| | |
|------------------|---|
| Deck Height: | 14' - 8 3/4" |
| Clear Height: | 12' - 10 1/4" |
| Ceiling Height: | 7' - 8 3/4" |
| Sprinklered: | <input type="checkbox"/> Yes <input checked="" type="checkbox"/> No |
| Mechanical Area: | 0 SQFT |

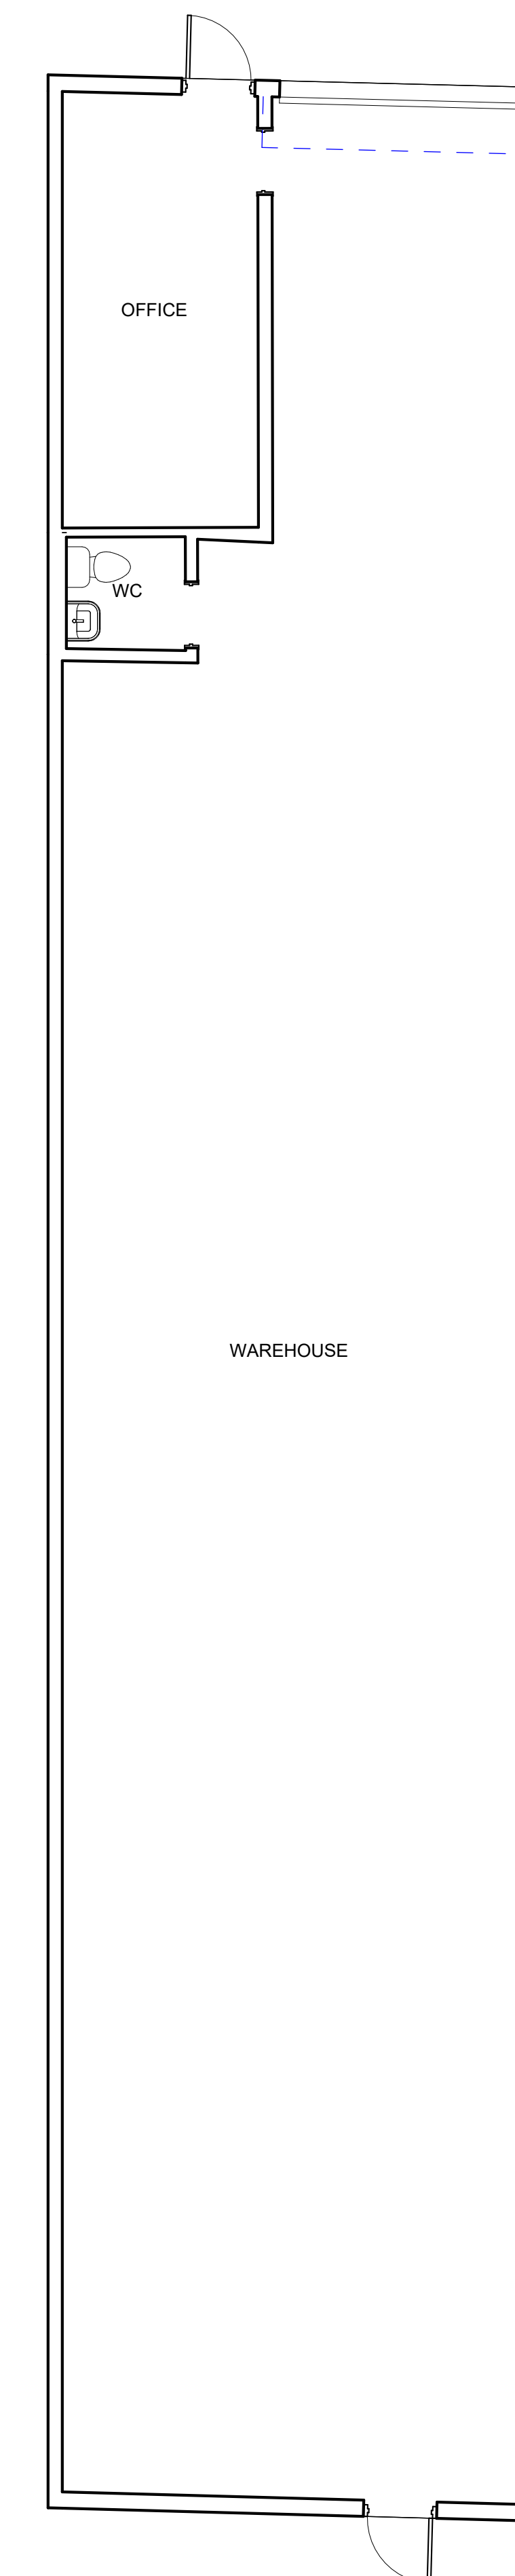

② 1620
3/16" = 1'-0"

As Built Floor Plan for Marketing

