
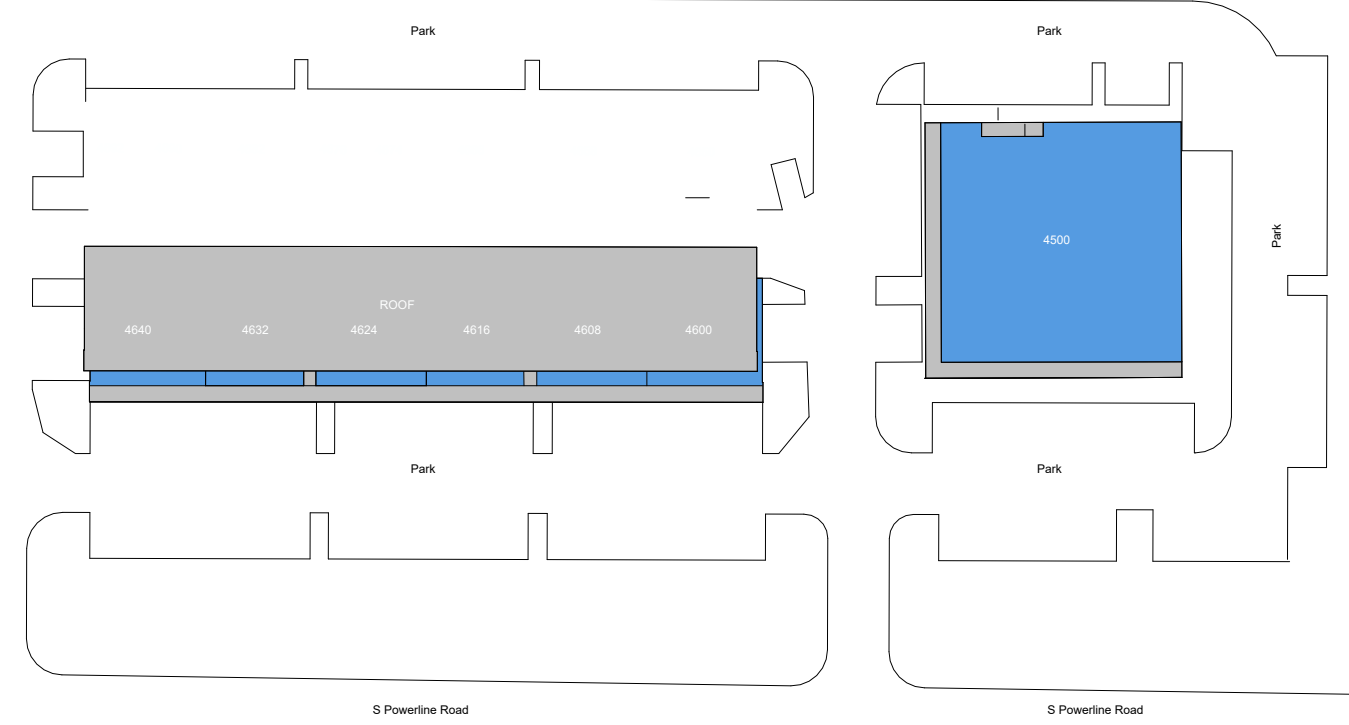


# Property Key

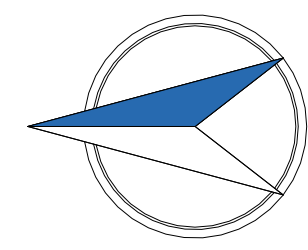


# Deerfield

4650 N Powerline Rd, Pompano Beach, 33073 FL

Building: 4650

Suite: 4692

Sheet **E1**

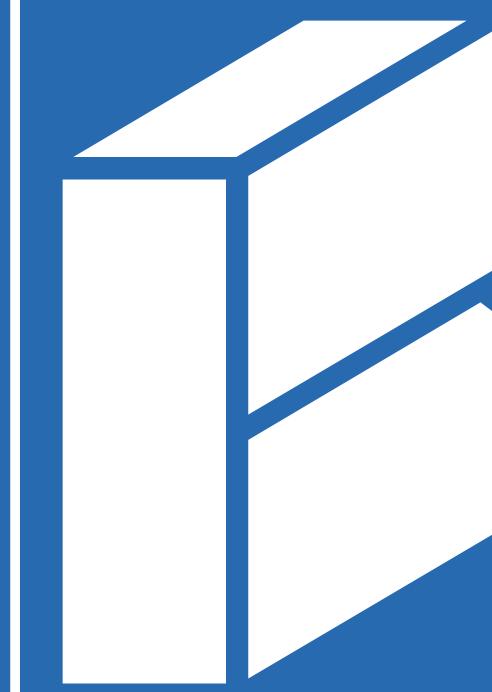

# BAY SPACE


Scale: Not to Scale  
Sheet Size: 42" x 30"  
Not For Construction

## Usable Square Foot Analysis

	SQFT	BUILDING PERCENTAGE
Office Area	1,500	100 %
Warehouse Area	0	0 %
Total Area	1,500	

## Building Information

Deck Height:	15' - 10 1/4"	
Clear Height:	9' - 11 1/4"	
Ceiling Height:	8' - 1 1/4"	
Sprinklered:	<input type="checkbox"/> Yes	<input checked="" type="checkbox"/> No
Mechanical Area:	0 SQFT	

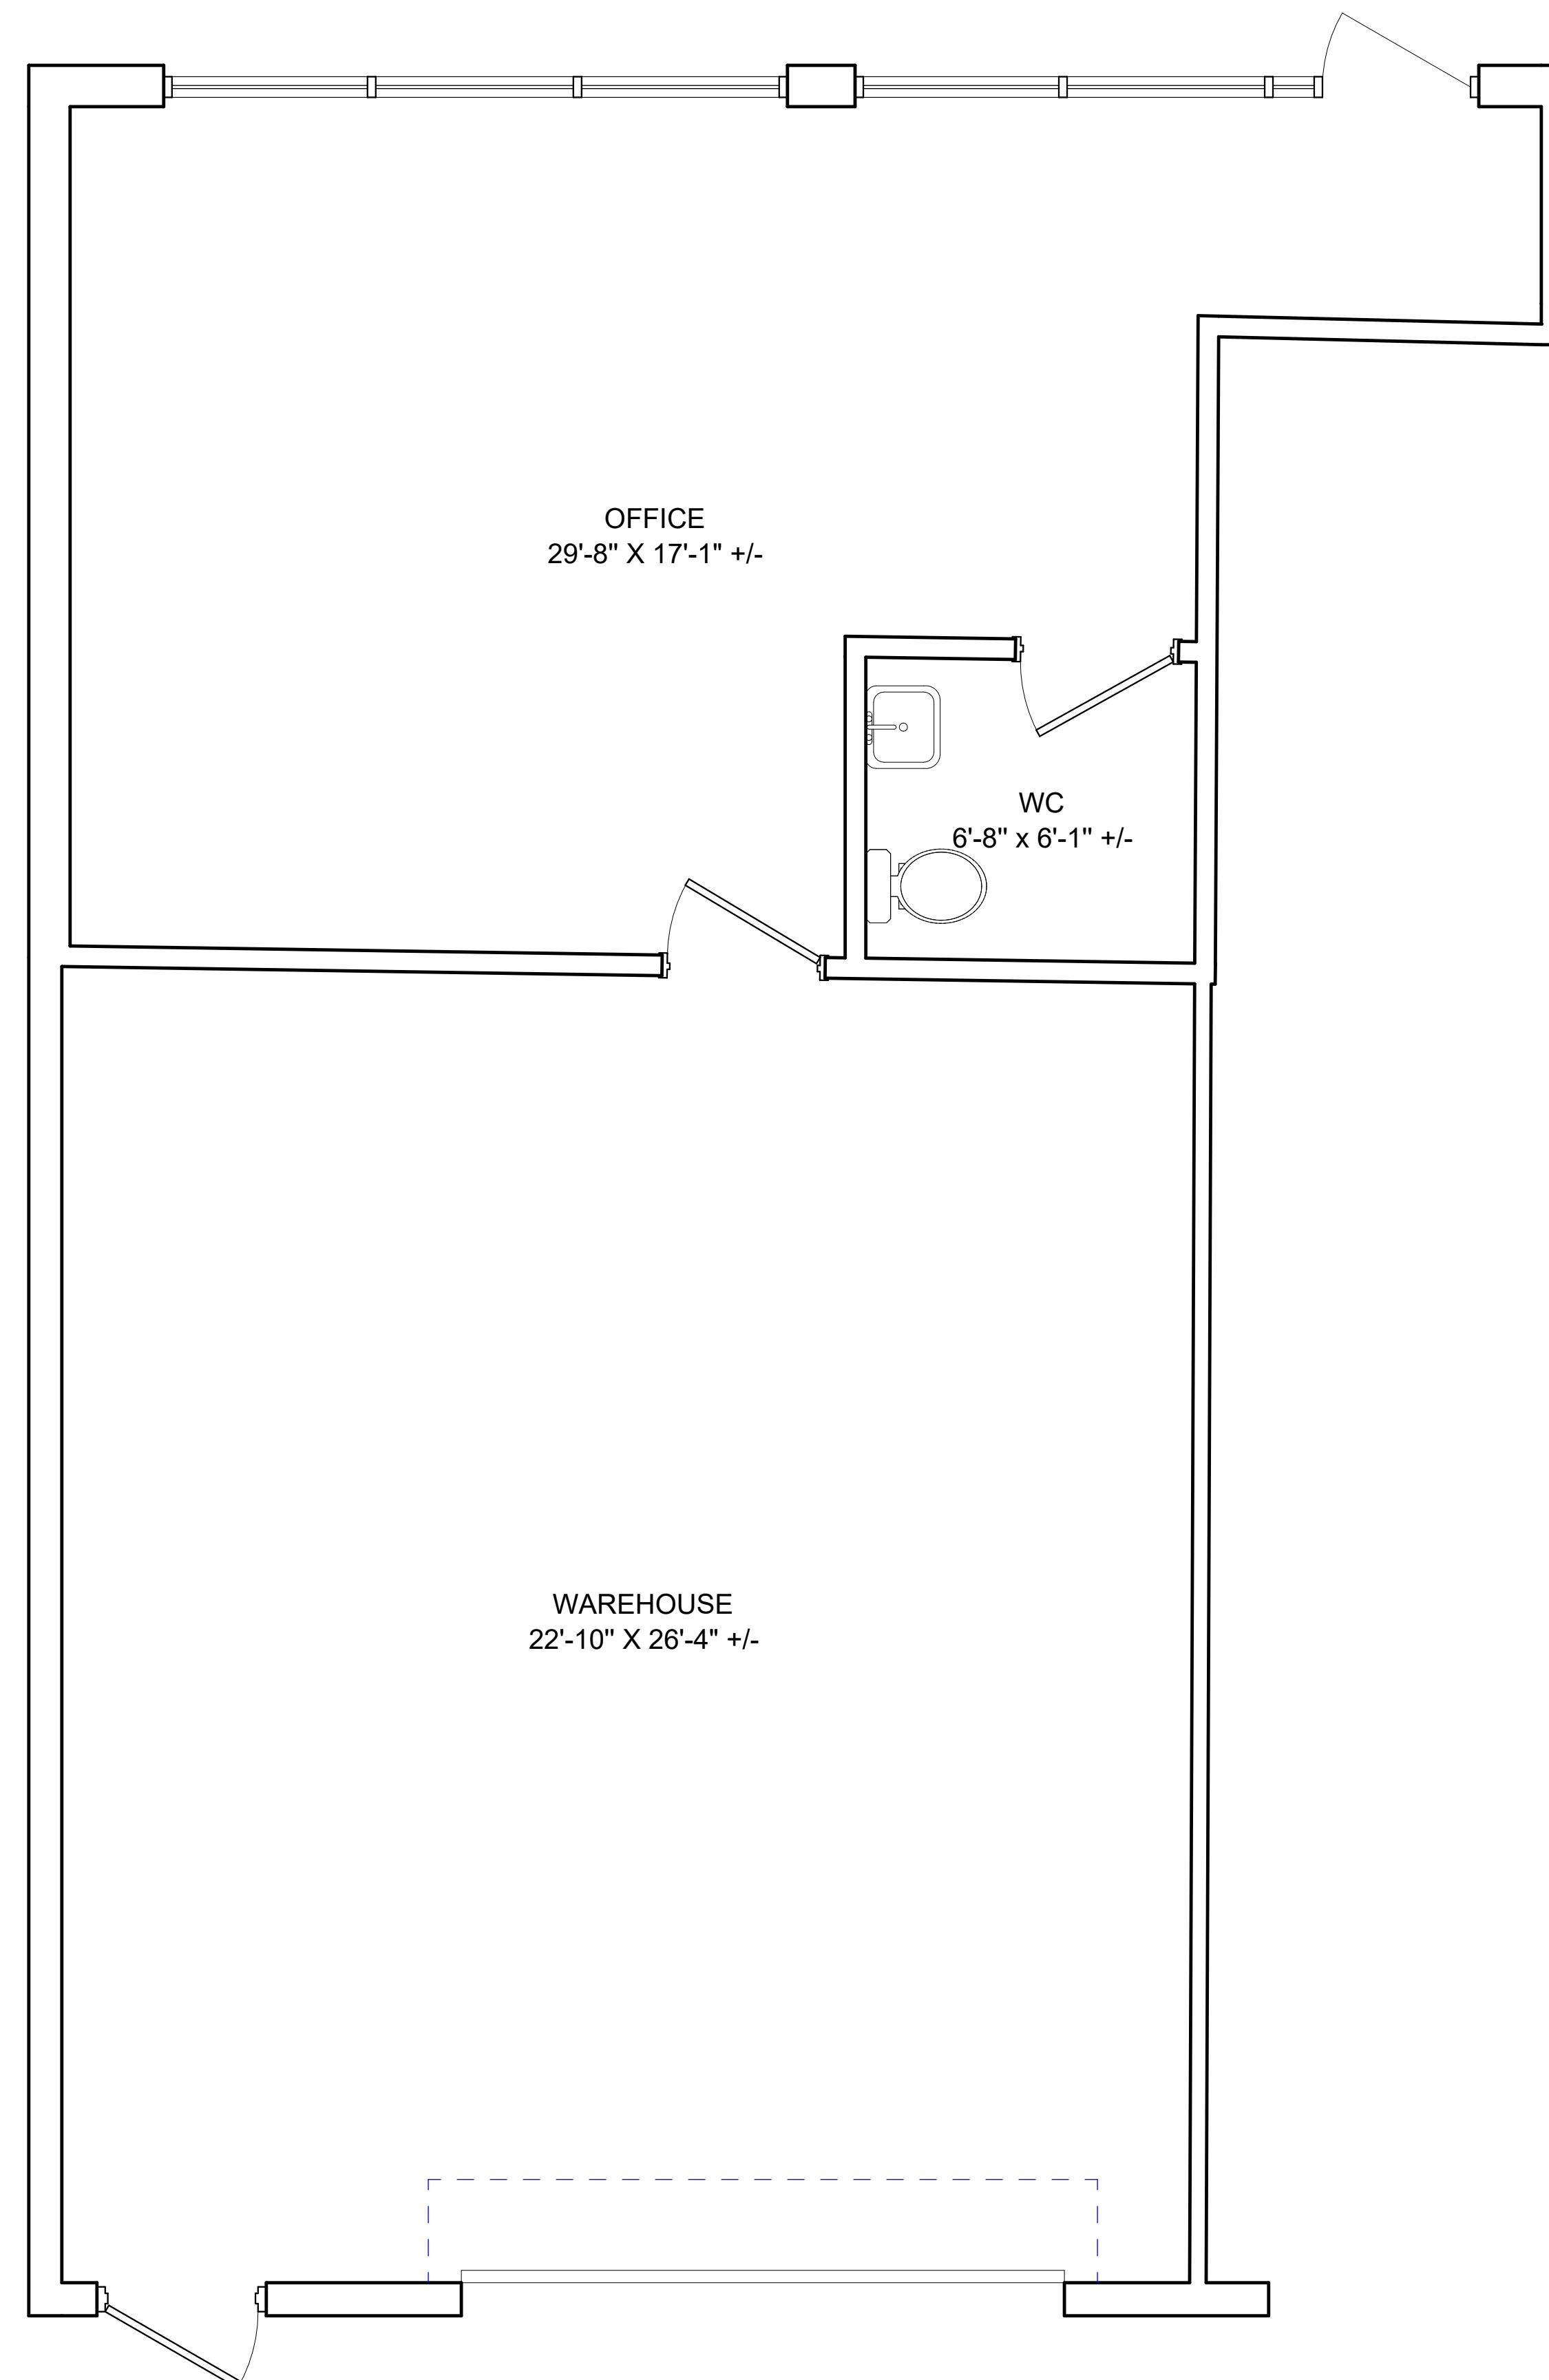

② 4692  
3/8" = 1'-0"

As Built Floor Plan for Marketing

