
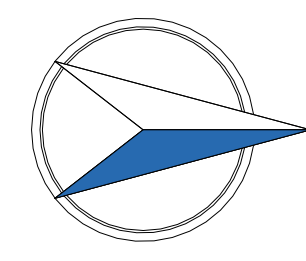


Property Key

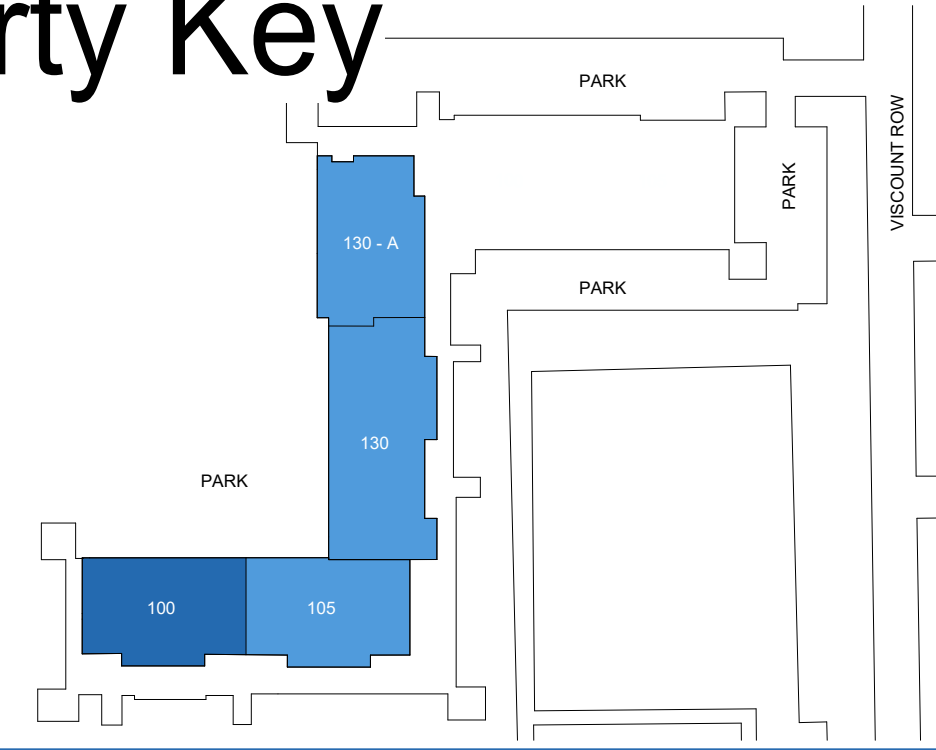

Southland As Built Marketing Package

7558 Southland Blvd, Orlando, FL 32809, US

Building: 7558

Suite: 100

Sheet **E1**



BAY SPACE


Scale: Not to Scale
Sheet Size: 42" x 30"
Not For Construction

Usable Square Foot Analysis

Office Area	7,811	100 %
Warehouse Area	0	0%
Total Area	7,811	

Building Information

Deck Height:	14' - 8 1/4"
Clear Height:	10' - 0"
Ceiling Height:	10' - 0"
Sprinklered:	<input checked="" type="checkbox"/> Yes <input type="checkbox"/> No
Mechanical Area:	97 SQFT

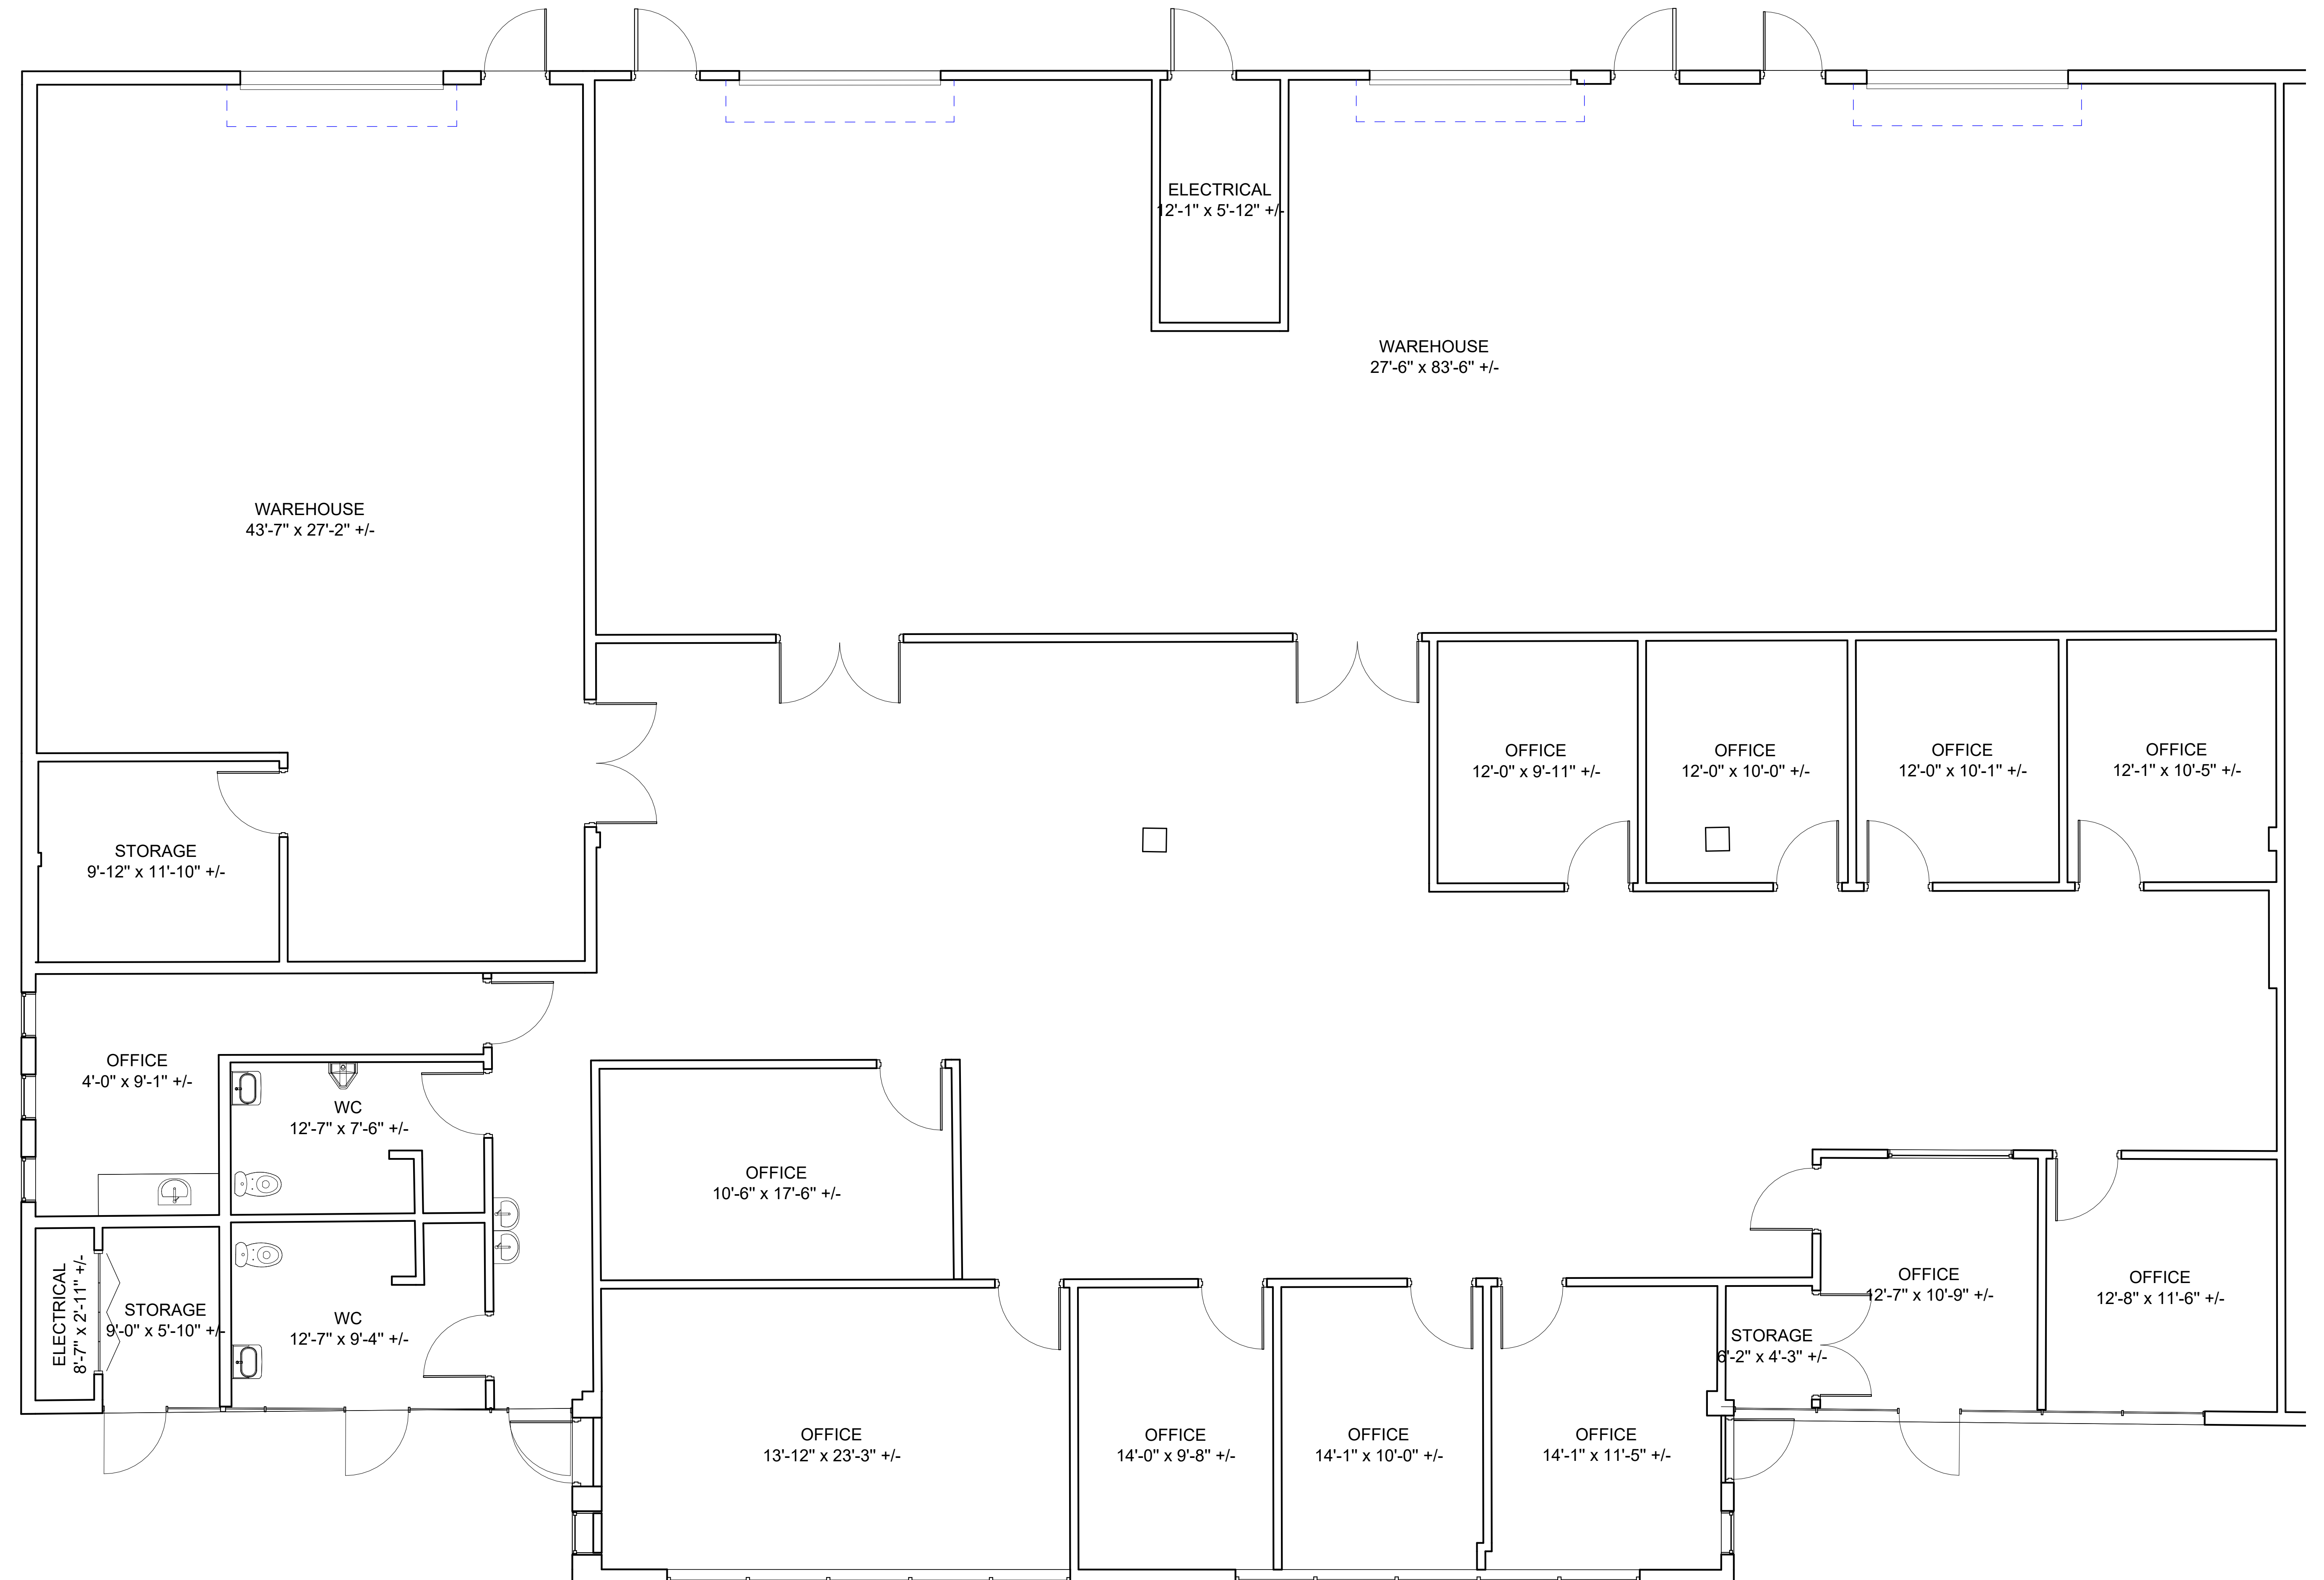

① 100
1/4" = 1'-0"

As Built Floor Plan for Marketing

