


Property Key

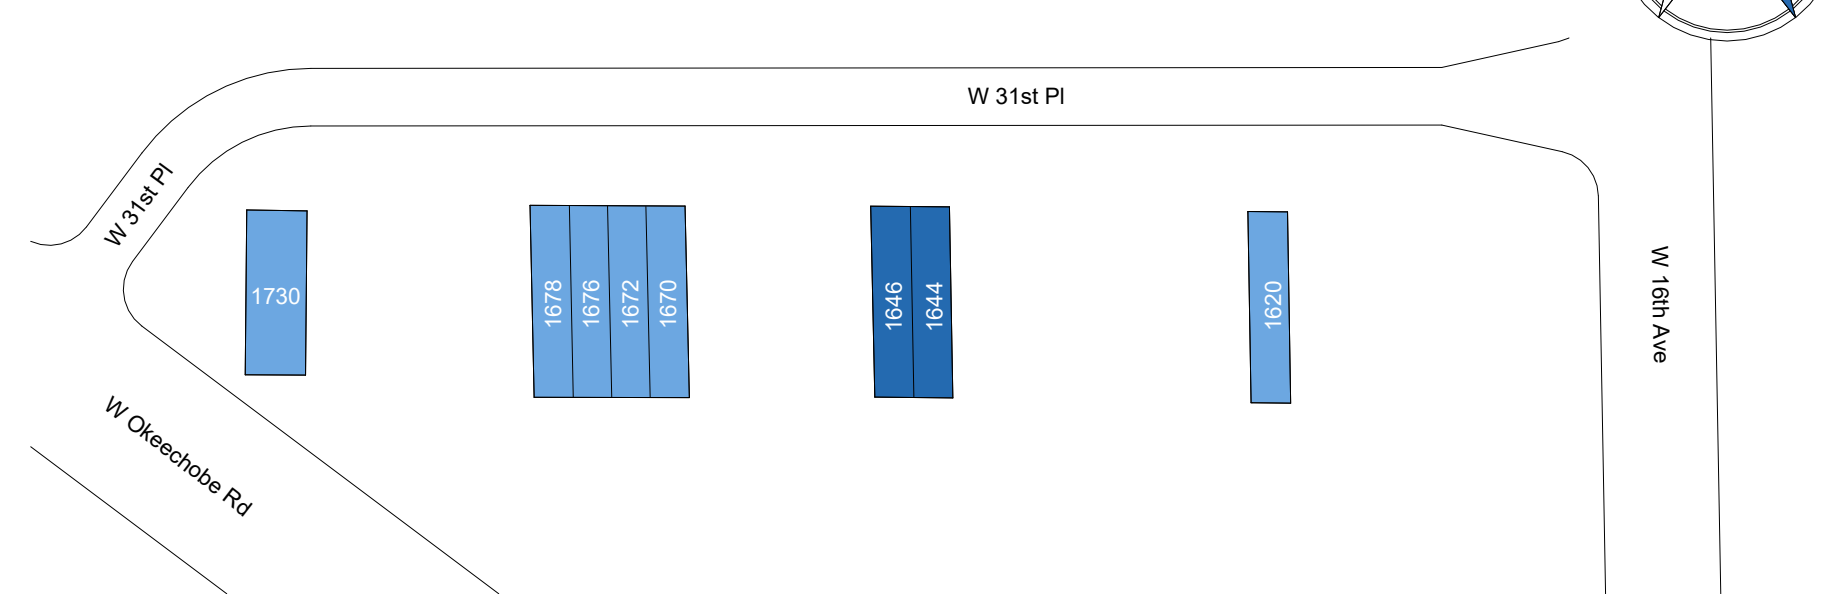

Hialeah Buildings

1646-1644 W 31st St, Hialeah, FL 33012

Building: 2

Suite: 1646-1644

Sheet **E1**



BAY SPACE


Scale: Not to Scale
Sheet Size: 42" x 30"
Not For Construction

Usable Square Foot Analysis

	SQFT	BUILDING PERCENTAGE
Office Area	0	0%
Warehouse Area	0	0%
Total Area	0	

Building Information

Deck Height:	18' - 0"
Clear Height:	12' - 8"
Ceiling Height:	7' - 8 3/4"
Sprinklered:	<input type="checkbox"/> Yes <input checked="" type="checkbox"/> No
Mechanical Area:	0 SQFT

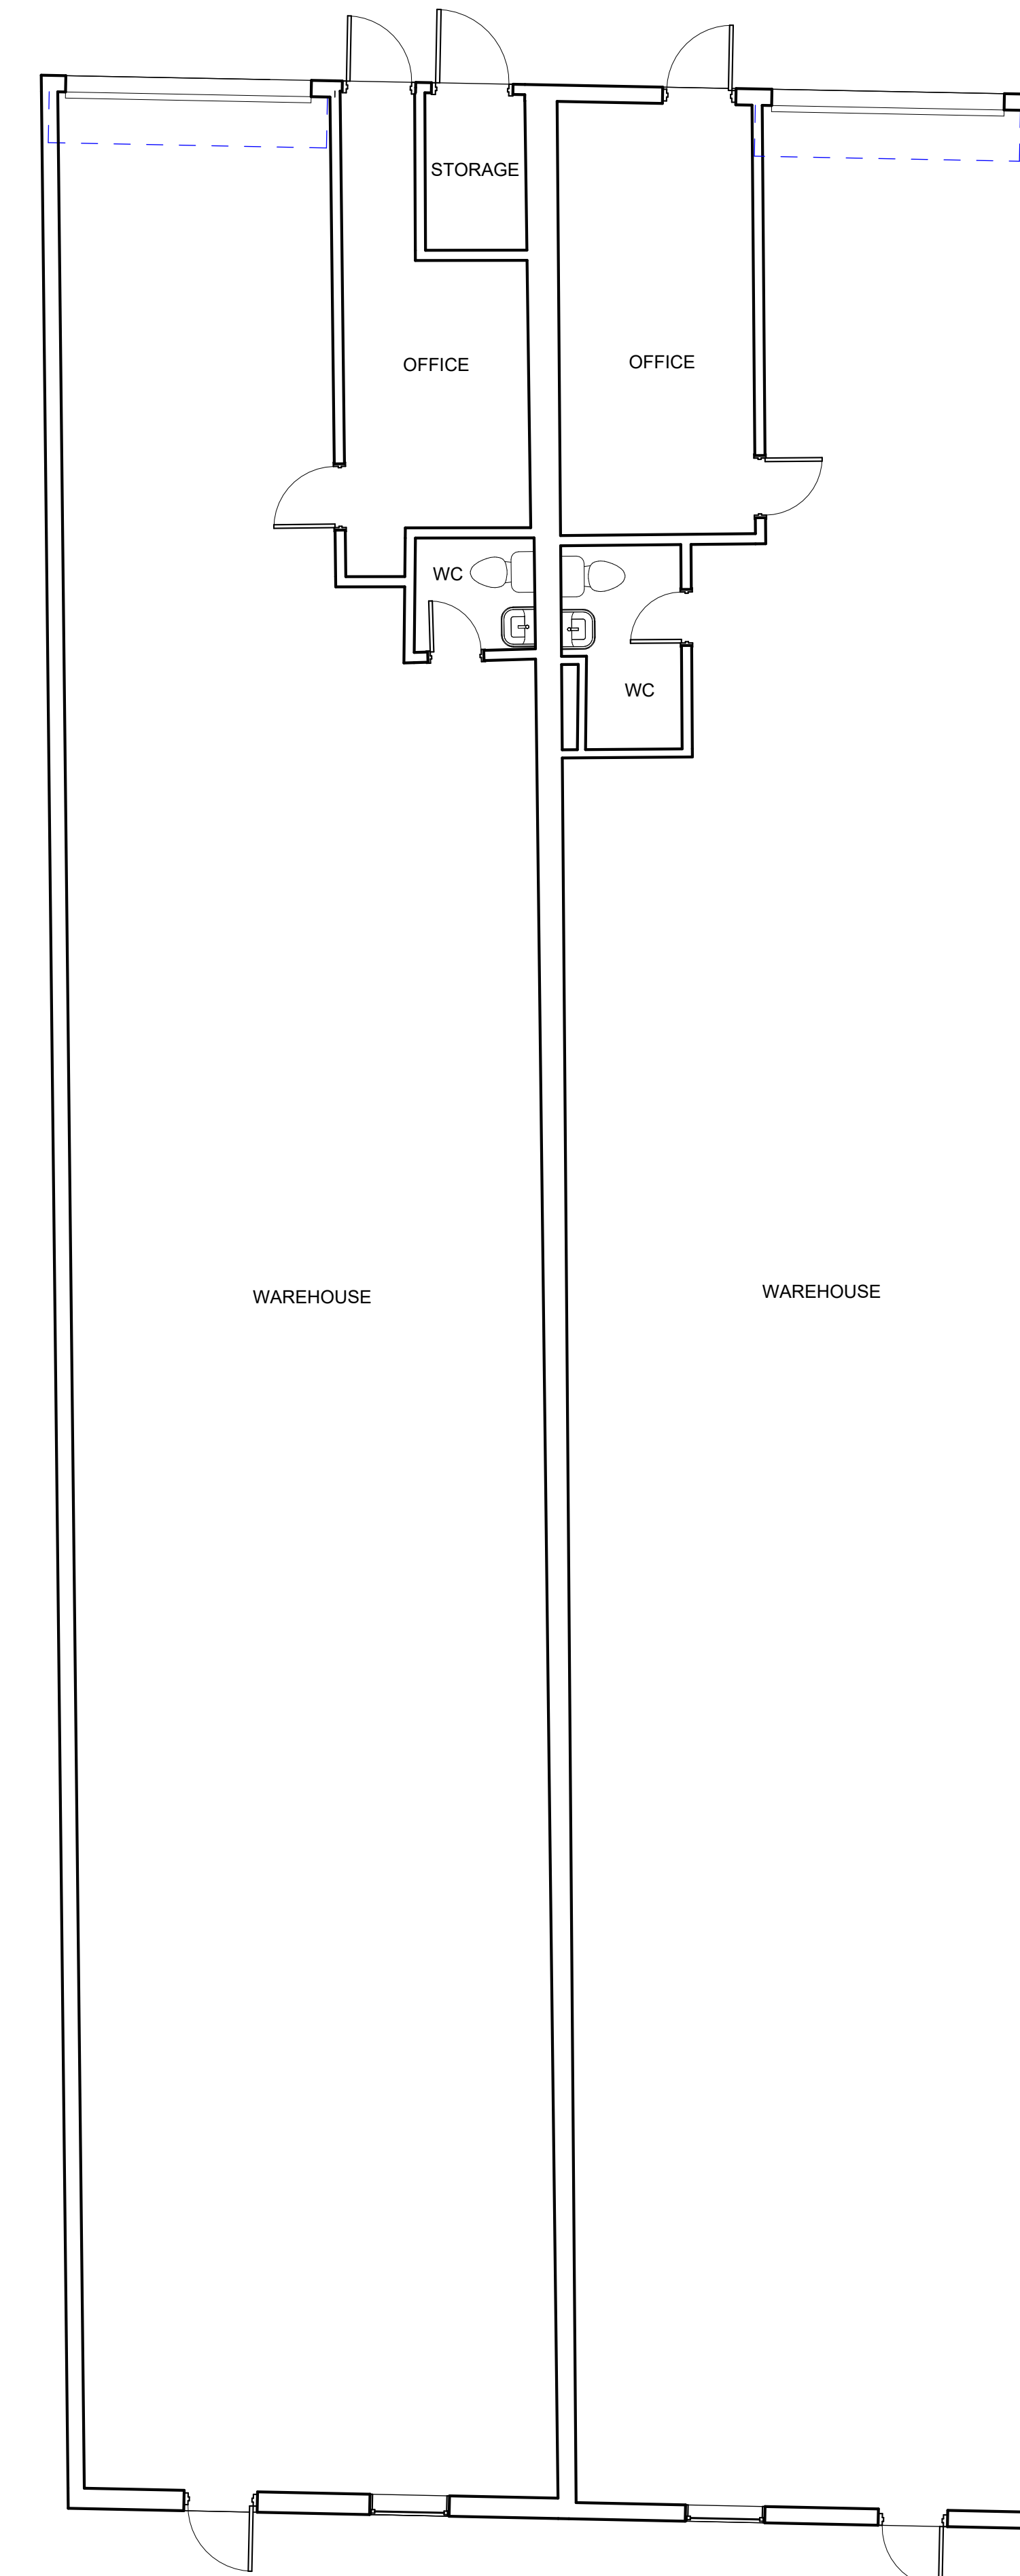

② 1644 - 1646
3/16" = 1'-0"

As Built Floor Plan for Marketing

