

Property Key




Alt Springs As Built Marketing Package

750 Northlake Blvd, Alt Springs, FL 32701, US

Building: 750
Suite: 1020
Sheet **E1**

Scale: Not to Scale
Sheet Size: 42" x 30"
Not For Construction

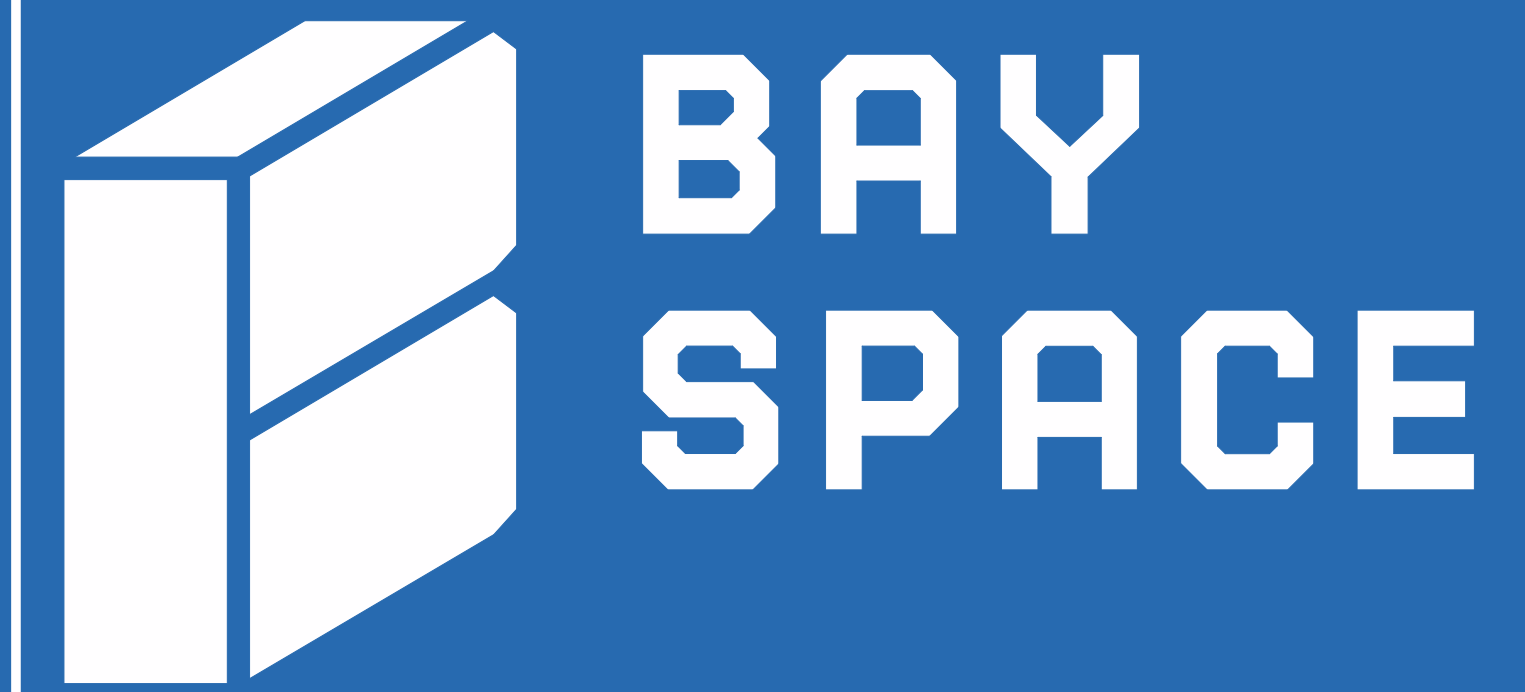

Usable Square Foot Analysis

Office Area	1,183	60%
Warehouse Area	778	40%
Total Area	1,961	

Building Information

Deck Height:	14' - 1"
Clear Height:	9' - 0 1/2"
Ceiling Height:	9' - 0 1/2"
Sprinklered:	<input checked="" type="checkbox"/> Yes <input type="checkbox"/> No
Mechanical Area:	0 SQFT

