


SPACE AVAILABLE

SUITE 5214: 7,619 SF

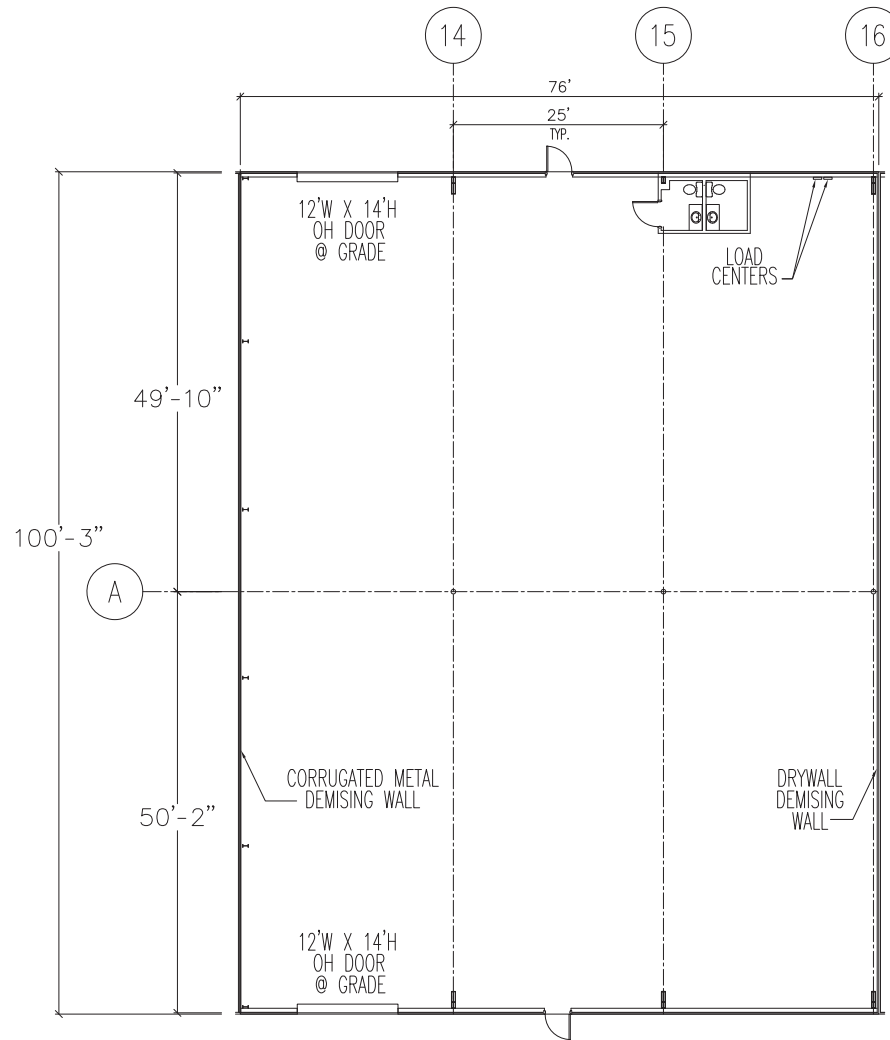

SUNSHINE INDUSTRIAL PARK
5214 126th Ave N
Clearwater, FL 337600

No warranty or representation, expressed or implied, is made to the accuracy of information contained herein, and same is submitted subject to errors, change of price, rental or other conditions, withdrawal without notice, and to any special listing conditions imposed by our principals. PLANS NOT TO SCALE

BRAD HUTTON
813.793.8492
Brad.Hutton@FranklinSt.com

PATRICK KELLY
813.682.6210
Pat.Kelly@FranklinSt.com

REID DOMINGUEZ
813.291.2658
Reid.Dominguez@FranklinSt.com

FranklinStreet
Licensed Real Estate Broker | FranklinSt.com