

3307 M

FLOOR FOUR
SUITE 400
9,399 SF

Matt Pacinelli


matt.pacinelli@streamrealty.com
202.595.1498

John Klinke

jklinke@streamrealty.com
202.595.1446

Alex Green

agreen@streetcompanies.com
202.607.7736

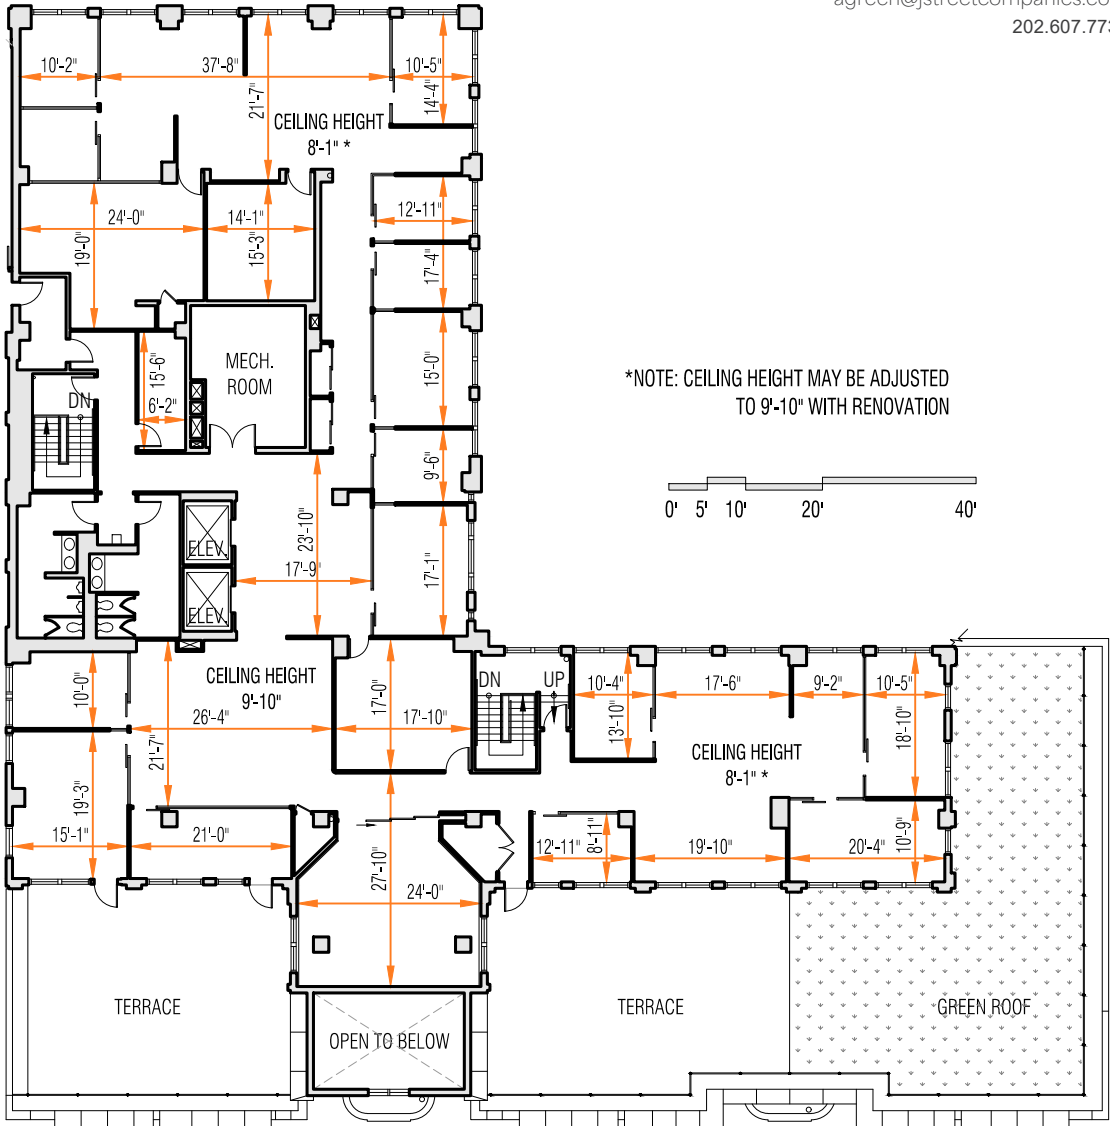

M STREET NW