

Suite 408
2,878 SF

Josh Schweitz

Managing Director

503.970.0094

josh.schweitz@nmrk.com

Travis Parrott, SIOR

Managing Director

503.972.5535

travis.parrott@nmrk.com

Trozell Benware


Brokerage Services Specialist

971.226.4956



trozell.benware@nmrk.com

NEWMARK

As-Built

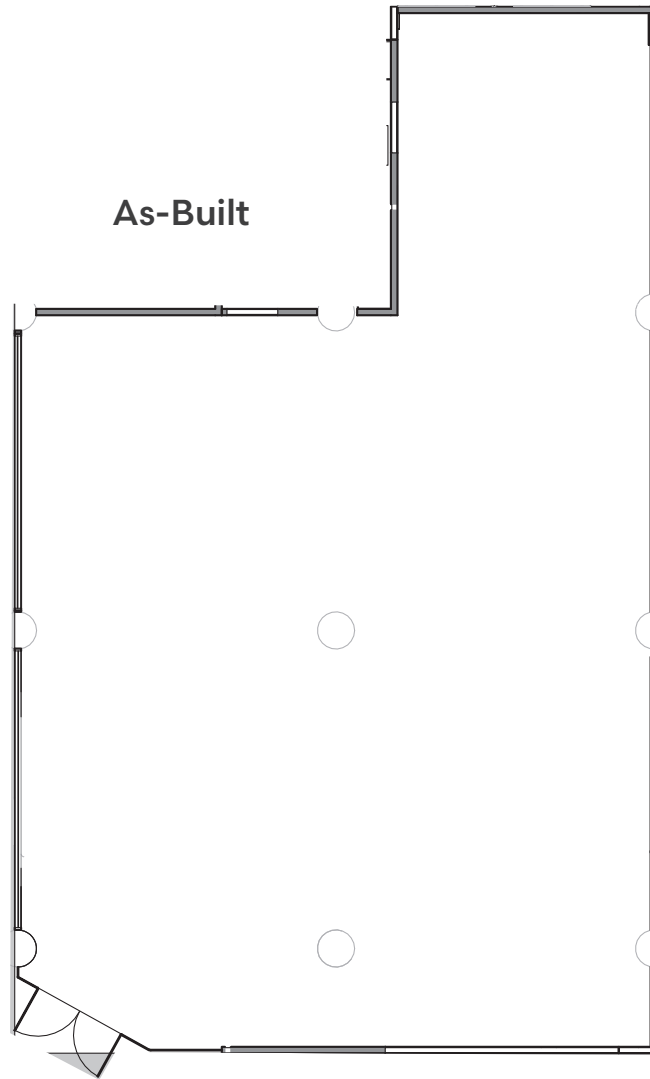

**Potential
Build Out**

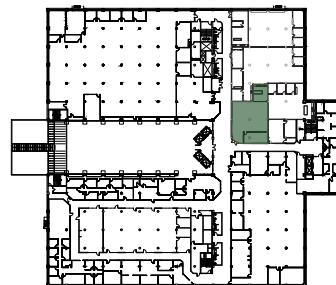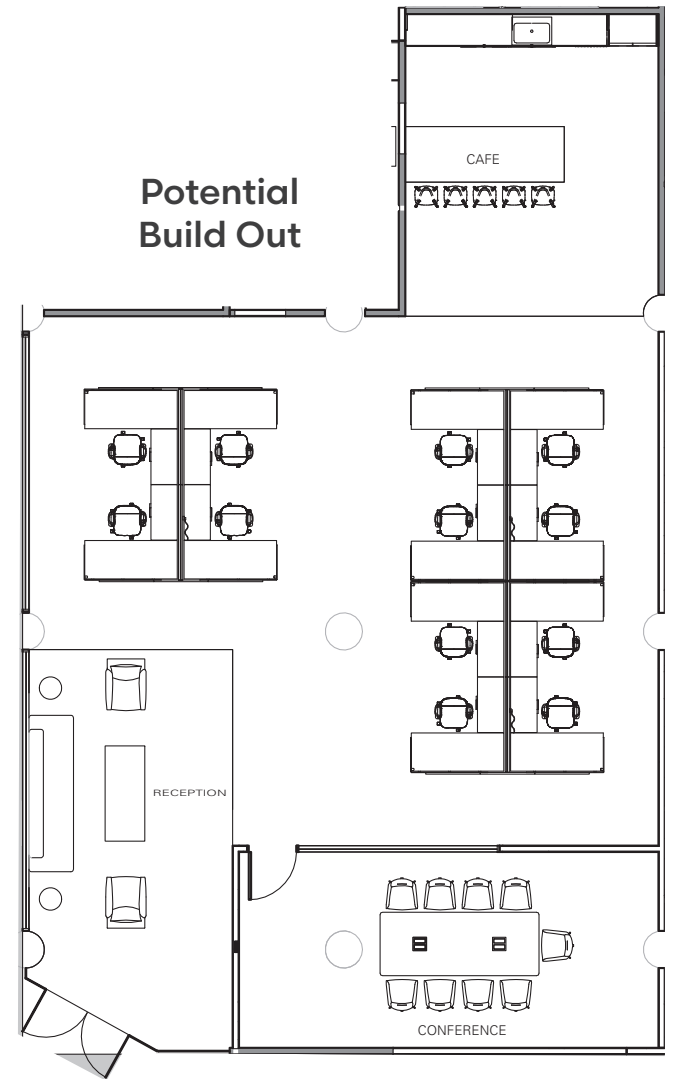

MP

MONTGOMERY
PARK

Suite 408 2,878 SF

Josh Schweitz

Managing Director

503.970.0094

josh.schweitz@nmrk.com

Travis Parrott, SIOR

Managing Director

503.972.5535

travis.parrott@nmrk.com

Trozell Benware

Brokerage Services Specialist

971.226.4956

trozell.benware@nmrk.com

NEWMARK

