


Property Key

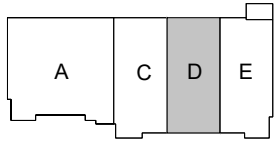

Turtle Creek As Built Marketing Package

4900 - 4914 Creekside Drive, Clearwater, FL 33760

Building: 4902

Suite: D

Sheet: A-3

Scale: Not to Scale
Sheet Size: 8.5" x 11"
Not For Construction




BAY SPACE

Total Area - 2,100 SF

Building Information

DECK HEIGHT:	12'-11"
CEILING HEIGHT:	8'-10"
CLEAR HEIGHT:	11'-5"
SPRINKLERED:	No
OVERHANG AREA:	82

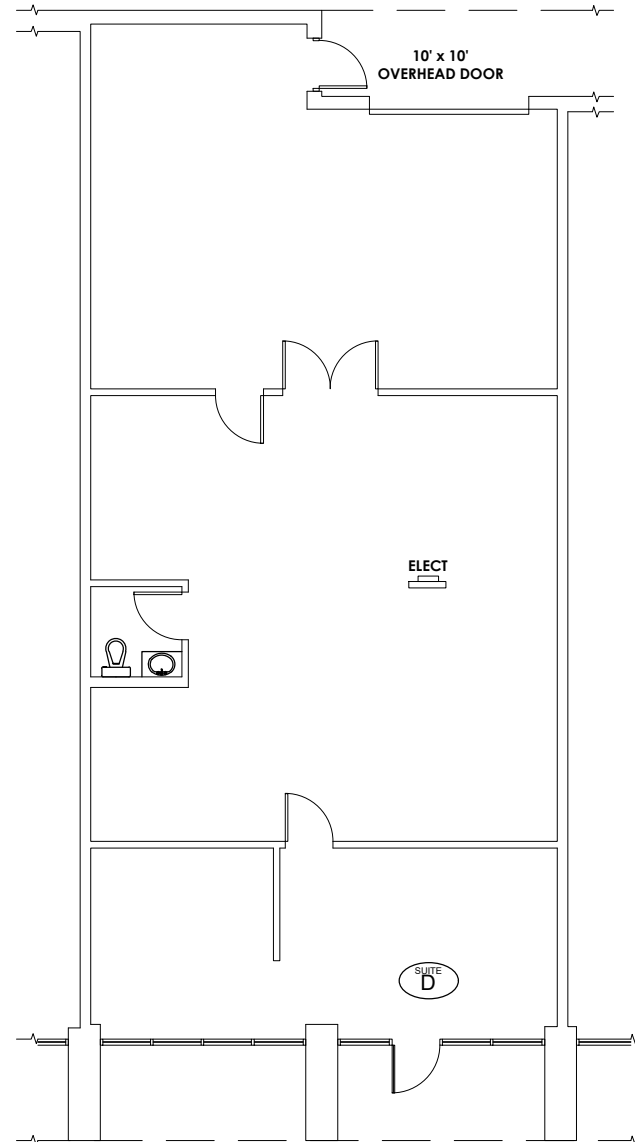

As Built Floor Plan for Marketing

