

Room Schedule				
Label		Room Name	Area	Type
01	Main Level	1. HEATED/MAIN	4,114.76	Commercial Heated
02	Main Level	2. COMMON	30.46	Commercial Common
			4,145.22 ft²	


SITE PLAN

- Suite #171
- City Parking
- Neighbouring Build.

Sheet Index

AS Built-47 Rankin Ave STE 101, Asheville, NC 28801


.1 Main Floor Plan

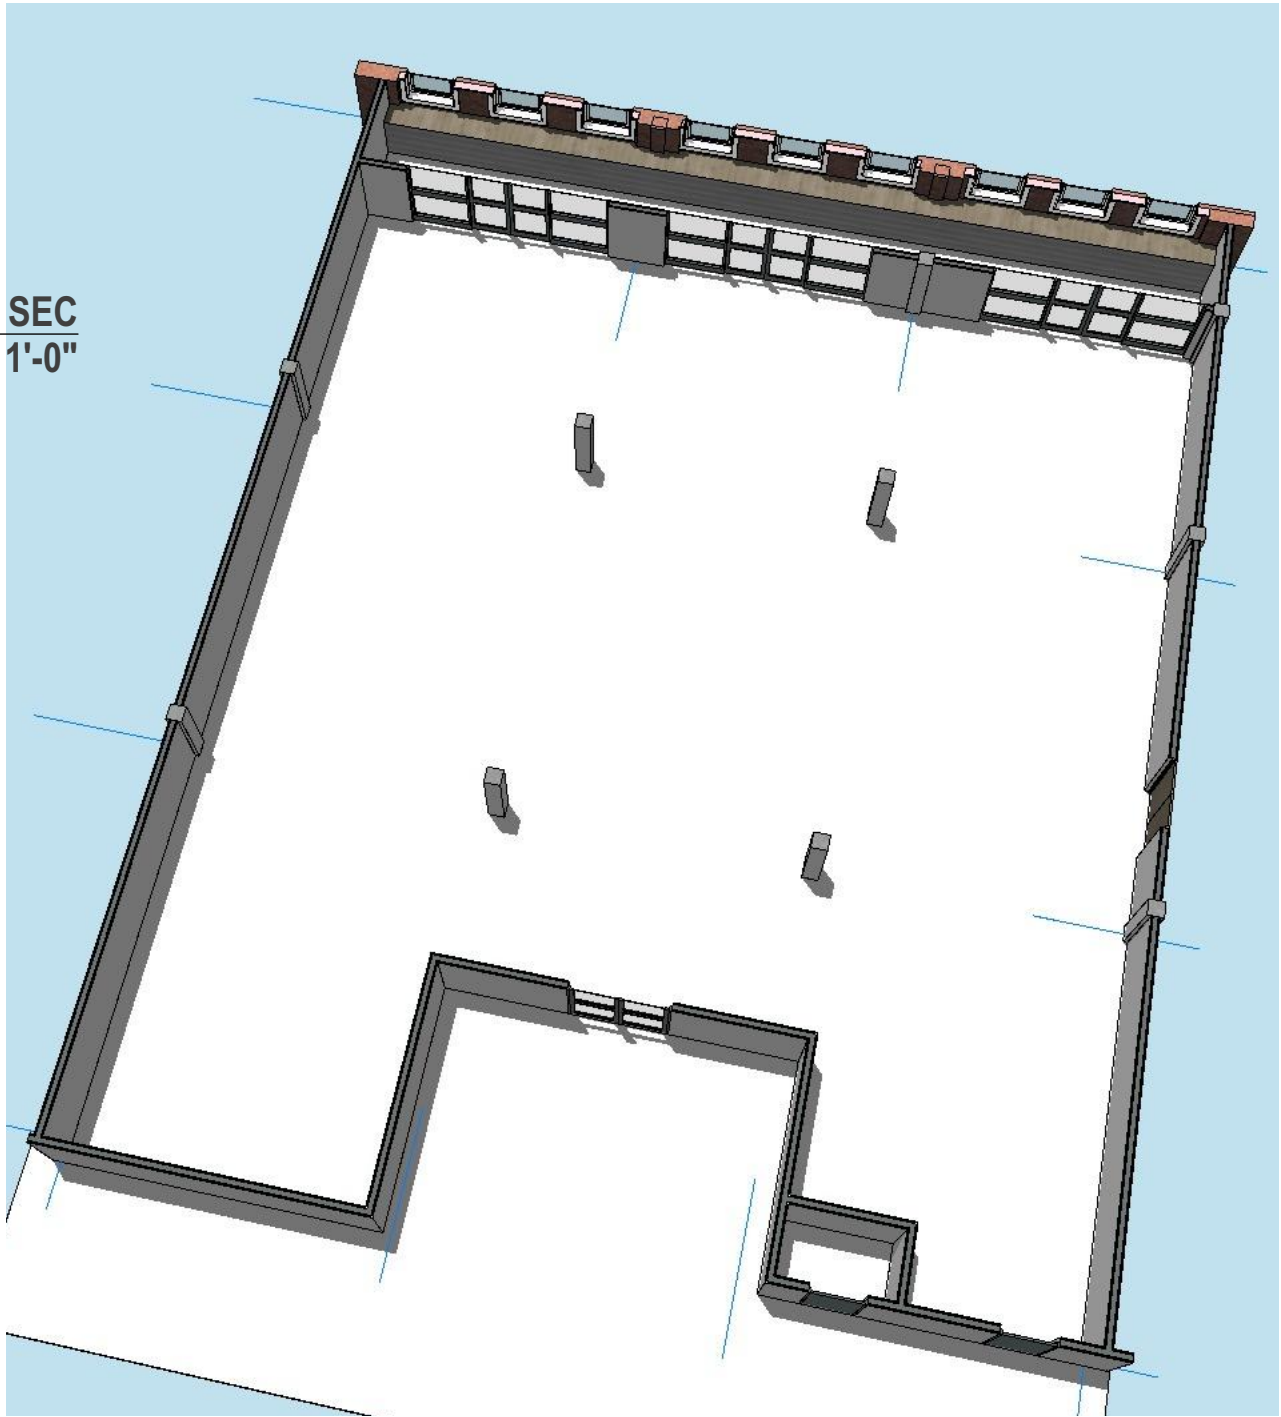

Generic Perspective



Site Plan
1" = 50'

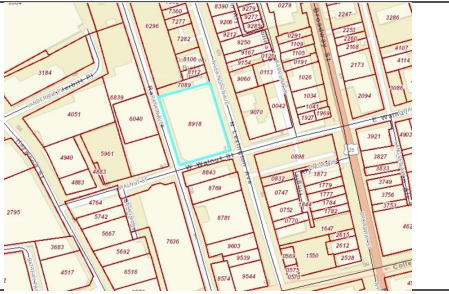

PROJECT LOCATION MAP

- GENERAL NOTES:
- DO NOT USE AS A BLUEPRINTS WITHOUT MR LLC PERMISSION.
 - PLEASE NOTE INTERIOR DIMENSIONS WERE NOT USED IN CALCULATING SQUARE FOOTAGE
 - SIZE OF HEATED AND NOT HEATED AREA AND OTHER INFORMATION WERE OBTAINED PER THE NC REAL ESTATE COMMISSION GUIDELINES (6' FOR EXTERNAL WALLS EXCEPT CONDOMINIUMS)
 - FOR REMODELING QUESTIONS OR MORE DETAILED CAD DRAWINGS (INC SITE PLAN, SECTIONS, ELEVATIONS) ALSO 3D MODEL PLEASE CONTACT ALFRED ZALYS MOB. 828 231 7305 E-MAIL: A.ZALYS@HOTMAIL.COM

Revision History

RevID	ChID	Change Name	Date

- LEGEND MAP:
- HEATED RESIDEN.FINISHED
 - HEATED COMMERC.FINISHED
 - NOT HEATED/NOT FINISHED
 - OPEN DECK
 - COVERED PORCH

Client:

e-mail address
phone number

Company Title



Company

Measure Rite LLC
103 Poplar Spring Trail, Hendersonville
#Contact Country NC 28739

Site Address

**47 Rankin Ave STE 101,
Asheville, NC 28801**

Drawing Name

**Main Level, Room Schedule,
Site Plan, Generic Perspective,
SEC, Sheet Index**

Drawing Status

AS Built

Contact Name
Alfred ZALYS
mob. 828 231 7305

Job Nr.
MR 1189
Date
5/13/2025

Drawing Scale
1/8" = 1'-0", 1" = 1'-0", 1" = 50',
Layout Nr.
1

Layouts Total
1
Paper Size
ANSI B

Layout ID

.1

Revision