

WEBB
MEDICAL
PLAZA B

14418 W MEEKER BLVD | SUN CITY WEST, AZ 85375

Floor 03


Suite 300

AS-BUILT

4,358 SF

AVAILABLE

*DIVISIBLE TO 2,174 SF

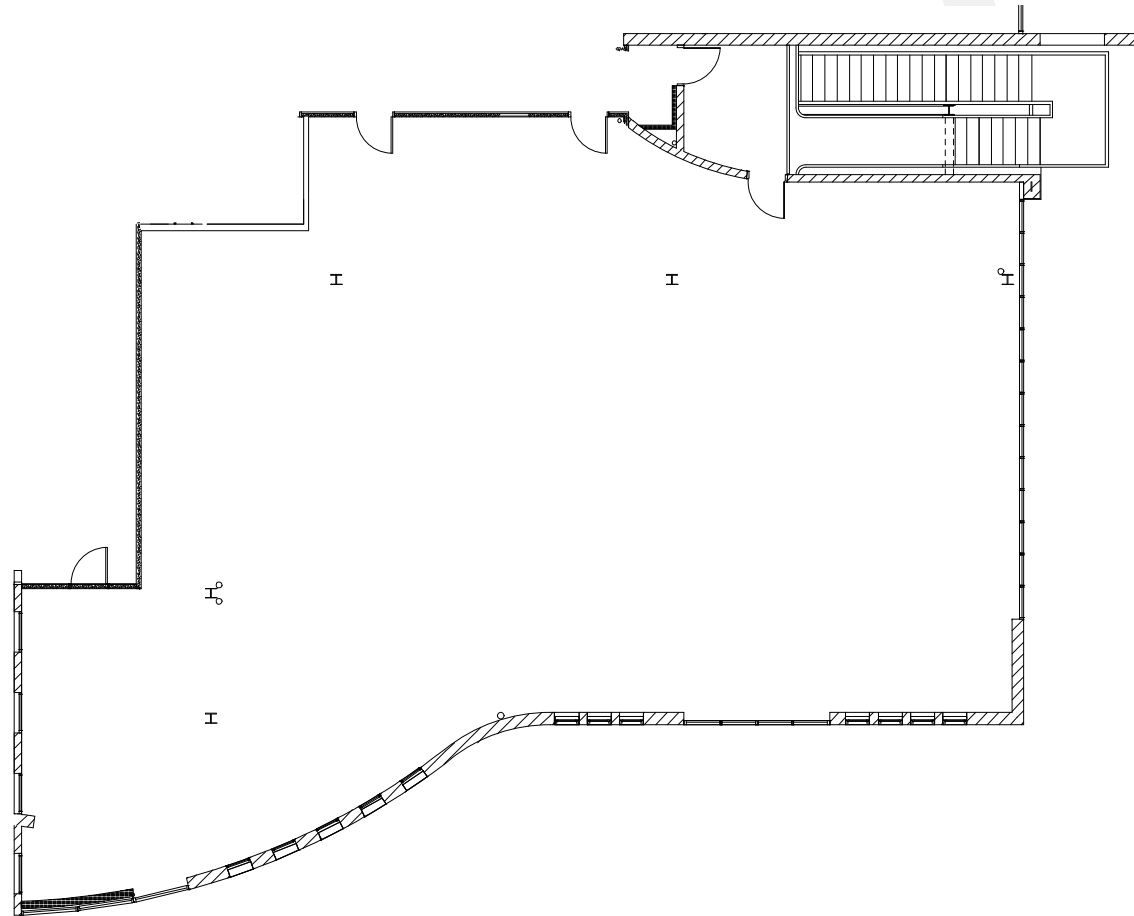

RACHAEL THOMPSON
Senior Vice President
602.513.5122
rachael.thompson@kidder.com

PERRY GABUZZI, CCIM
Senior Vice President
602.513.5116
perry.gabuzzi@kidder.com



View Portfolio

km Kidder
Mathews