


KEY PLAN

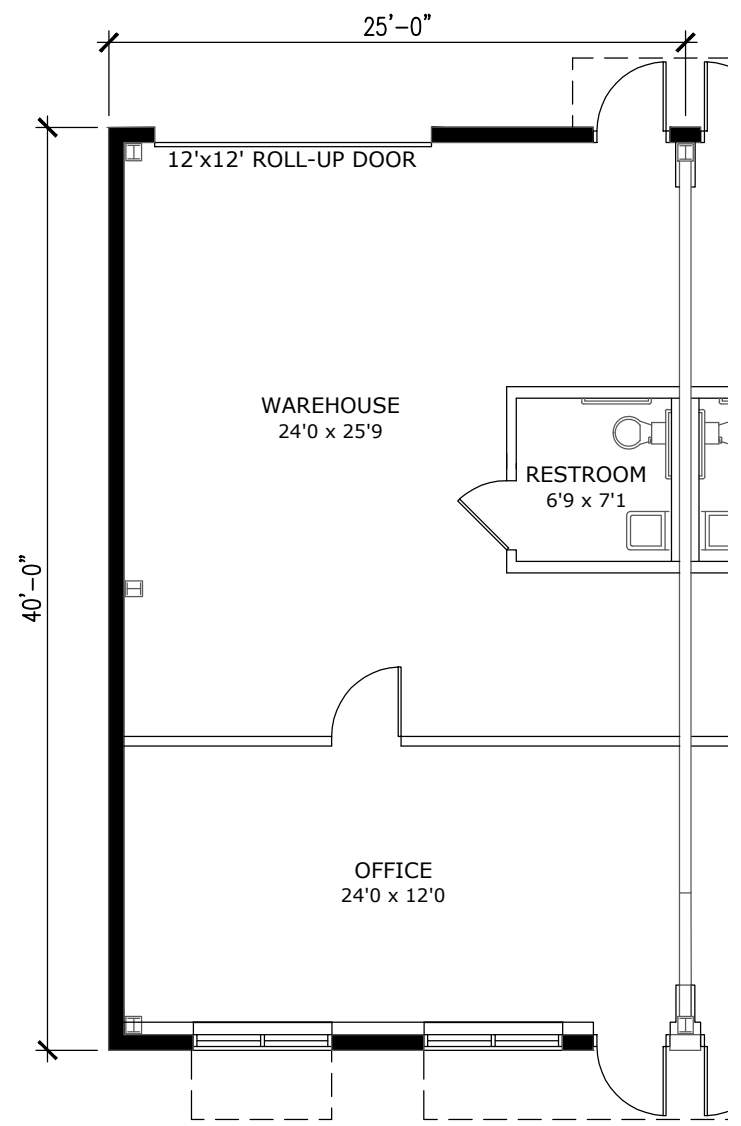

AS BUILT PLAN

512 FENTRESS BLVD, UNIT J
 DAYTONA BEACH, FL 32114
 340 SF OFFICE | 660 SF WAREHOUSE

USABLE INTERIOR SQUARE FOOTAGE SHOWN; PLAN IS NOT TO SCALE.