

```

Address (#1)
Address (#2)
PHONE: (000)000-0000
FAX: (000)000-0000

```

```
Address (#1)
Address (#2)
PHONE: (000)000-0000
FAX: (000)000-0000
```

```
Address (#1)
Address (#2)
NONE: (000)000-0000
XX: (000)000-0000
```

AS-BUILT SET
09.06.2023

MARK	DATE	DESCRIPTION
REVISIONS		

NOT FOR
CONSTRUCTION


THESE DRAWINGS ARE PROVIDED FOR APPROVAL OR REVIEW PURPOSES ONLY AND DO NOT IN ANY WAY CONSTITUTE A CONSTRUCTION DOCUMENT SET; AS SUCH, THESE DRAWINGS MAY NOT BE INCORPORATED TO ANY SET OF DRAWINGS USED FOR CONSTRUCTION.

2010 KRITTENBRINK ARCHITECTURE LLC ALL RIGHTS
RESERVED THESE DOCUMENTS NOT BE USED FOR ANY
PURPOSES WITHOUT PRIOR WRITTEN PERMISSION FROM
KRITTENBRINK ARCHITECTURE LLC

SHEET TITLE:

SHEET NO.:

A201

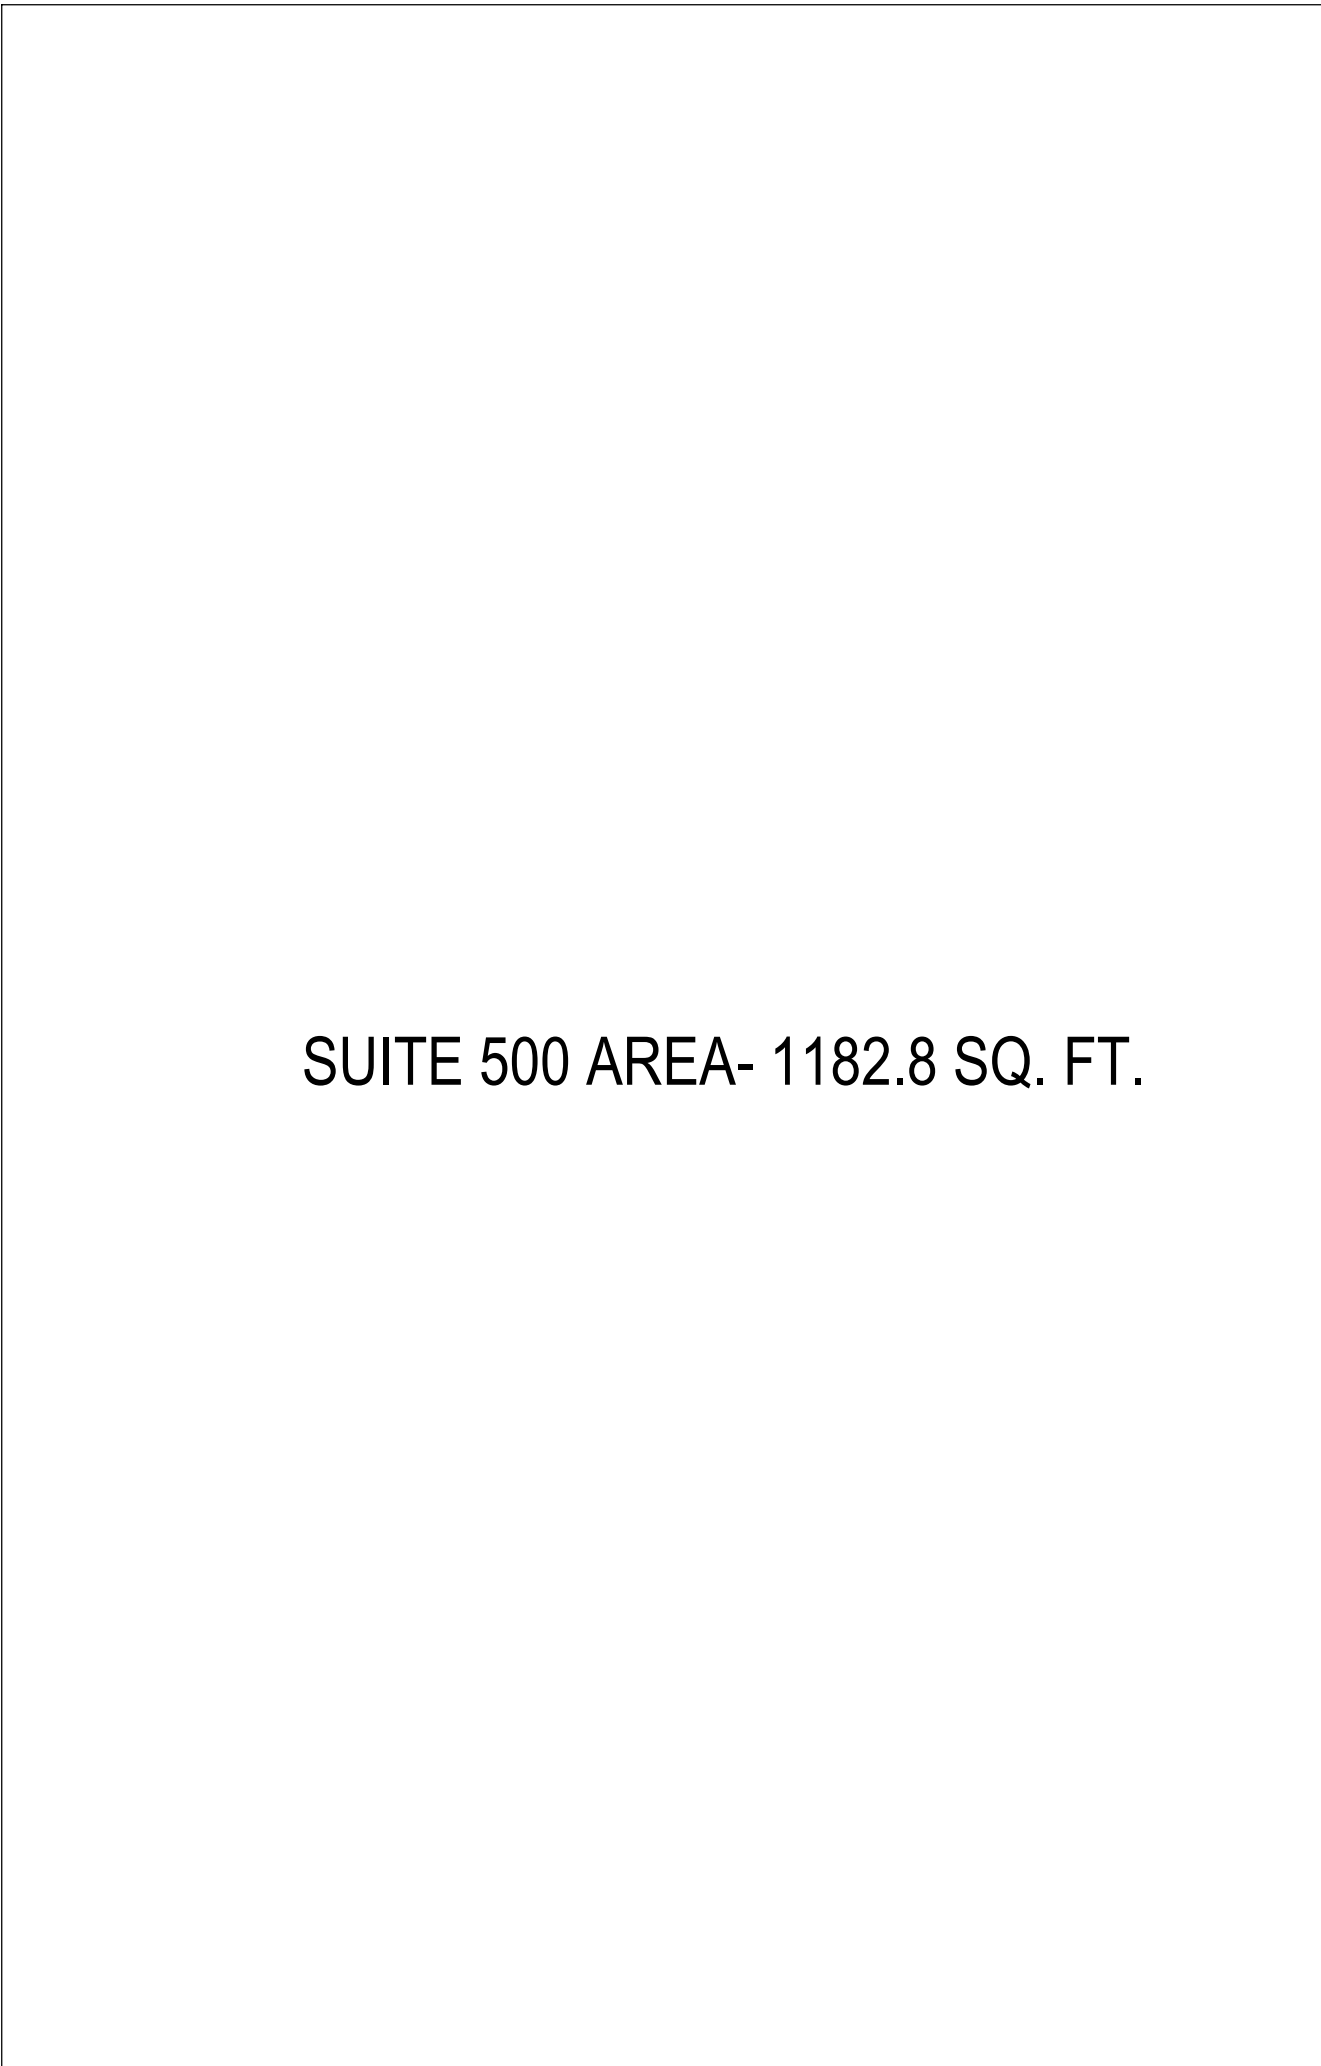

SUITE 500 AREA- 1182.8 SQ. FT.

SUITE 500 AREA	
AREA	SF
NET AREA	1182.8