


## Property Key

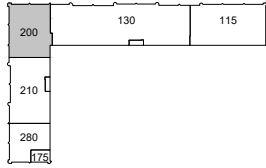

## Brandywine As Built Marketing Package

3801 Corporex Park Drive, Tampa, FL 33619

Building: 115-280

Suite: 200

Sheet: A-4


Scale: Not to Scale  
Sheet Size: 8.5" x 11"  
Not For Construction



Total Area - 6,907 SF

## Building Information

DECK HEIGHT:	N/A
CEILING HEIGHT:	8'-9"
CLEAR HEIGHT:	N/A
SPRINKLERED:	Yes

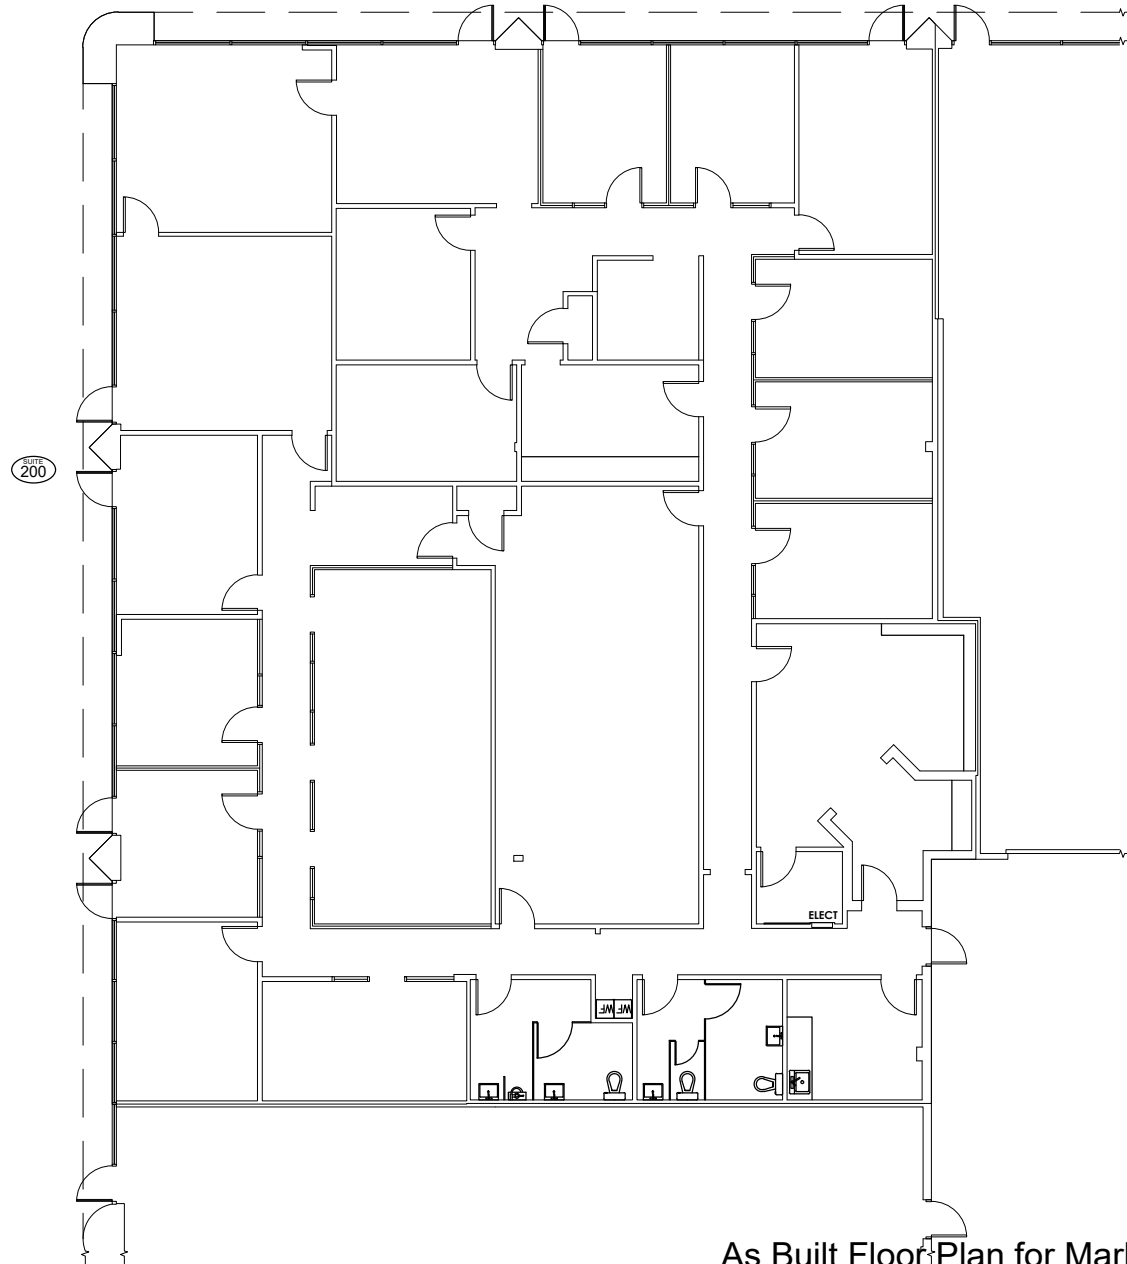

As Built Floor Plan for Marketing

