


# Sorrento Mesa Business Center

5995 Mira Mesa Blvd., Suite A

San Diego, CA 92121

06.27.2014

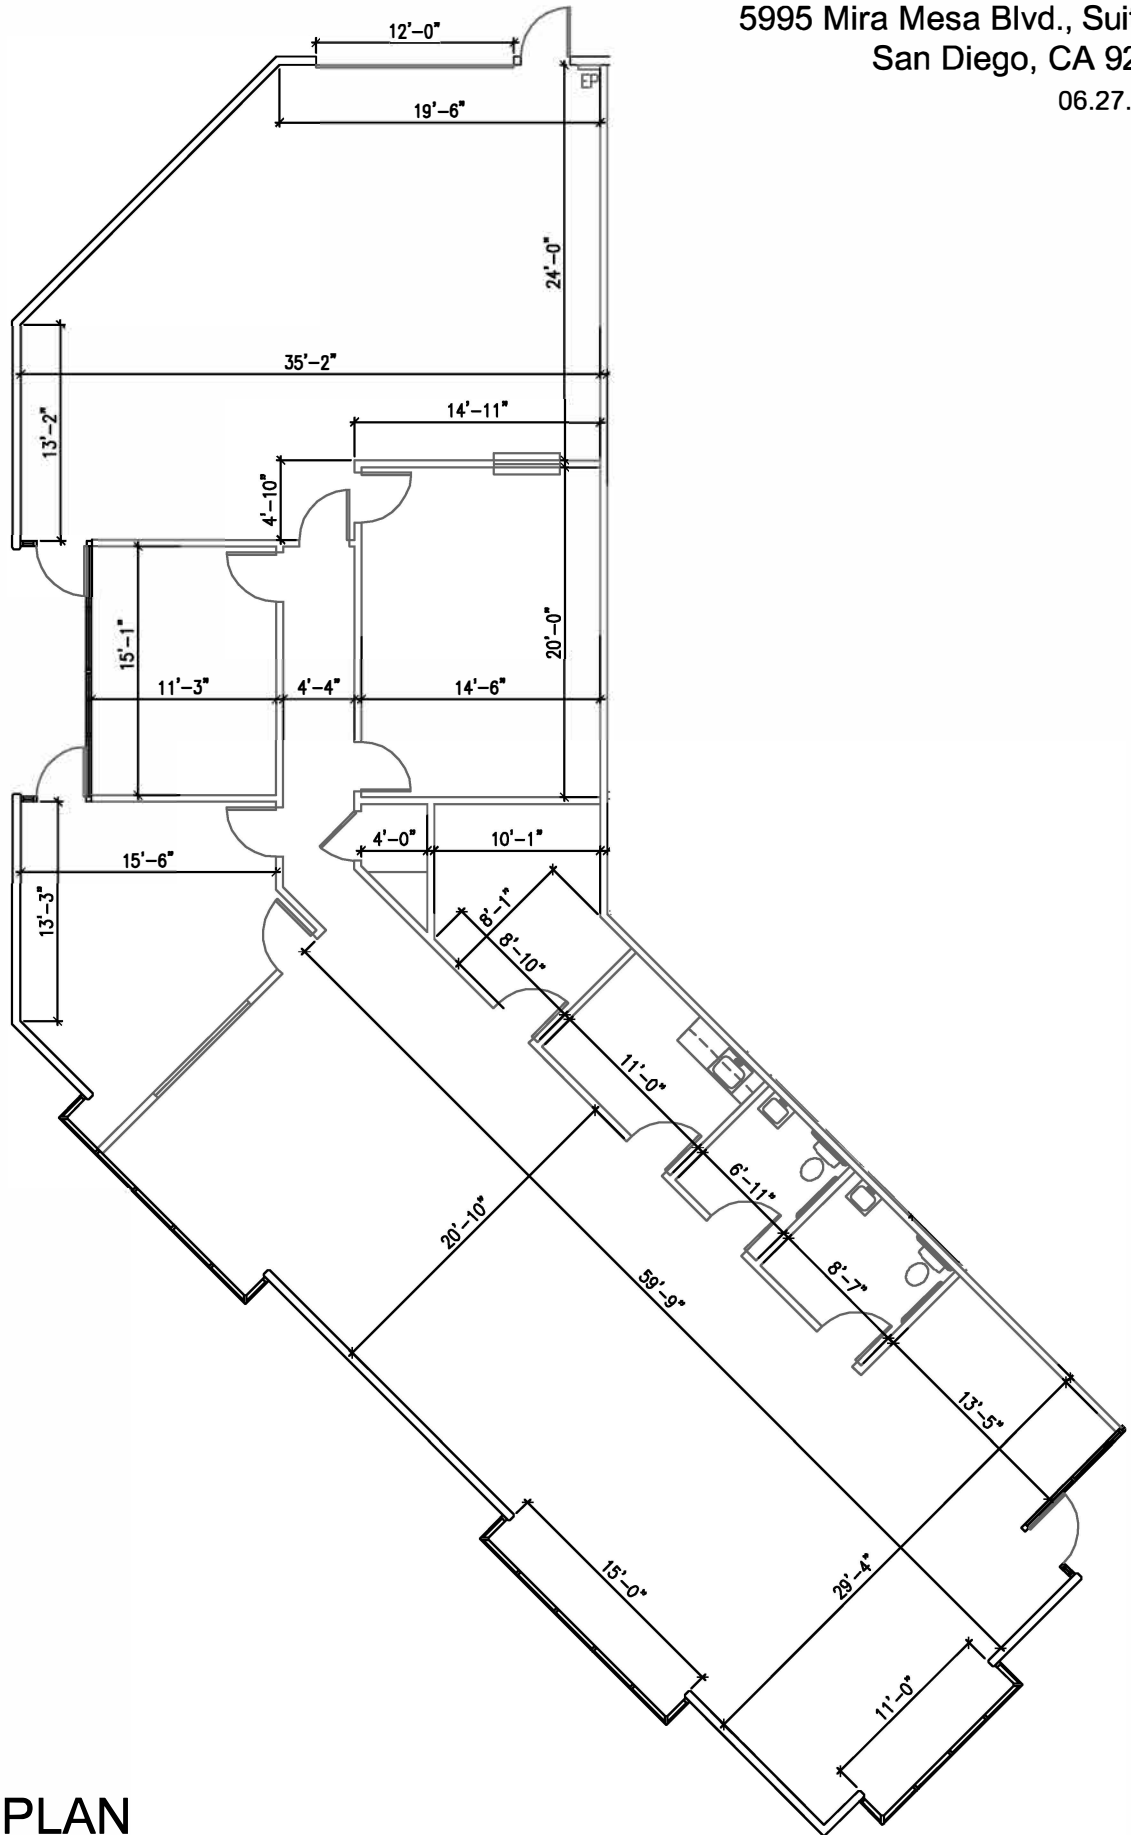

AS BUILT PLAN

SCALED TO FIT