




3030 BLDG.

Available 60 Days

Hypothetical

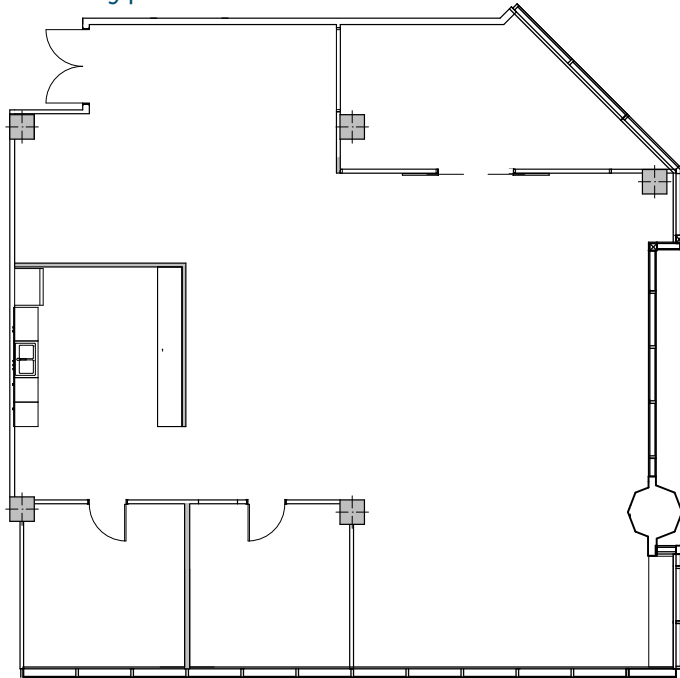

As-Built

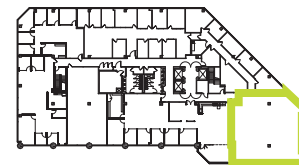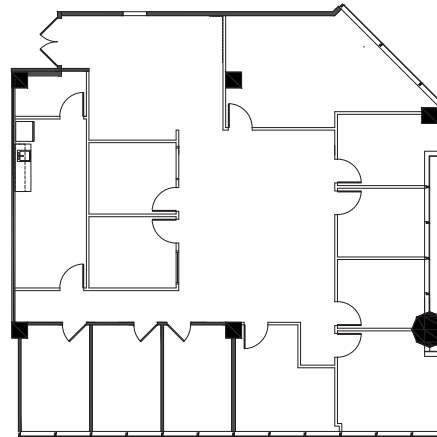

THE RANCH

at Seal Beach

3010, 3020 and 3030
Old Ranch Parkway, Seal Beach, CA

2ND FLOOR

SUITE 220

3,586 RSF

LEASING AGENTS:

GEORGE THOMSON

Executive Managing Director

CA RE Lic. #00947200

t 949-608-2037

george.thomson@nmrk.com

ERIC ADAMS

Senior Managing Director

CA RE Lic. #01349859

t 310-491-2012

eric.adams@nmrk.com

NEWMARK

18401 Von Karman Avenue, Suite 150, Irvine, CA 92612 | Corporate License #01355491

The distributor of this communication is performing acts for which a real estate license is required. The information contained herein has been obtained from sources deemed reliable but has not been verified and no guarantee, warranty or representation, either express or implied, is made with respect to such information. Terms of sale or lease and availability are subject to change or withdrawal without notice.