


Property Key

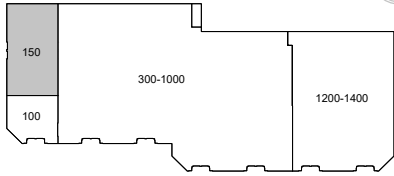


WMGSA Roosevelt As Built Marketing Package

10901-11001 Roosevelt Boulevard and 1000 112th Circle, St. Petersburg, FL 33716

Building: 11001
Suite: 1-150
Sheet: A-2


Scale: Not to Scale
Sheet Size: 8.5" x 11"
Not For Construction

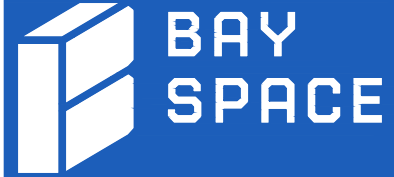

Total Area - 5,665 SF

Building Information

DECK HEIGHT:	17'-9"
CEILING HEIGHT:	8'-8"
CLEAR HEIGHT:	16'-1"
SPRINKLERED:	Yes

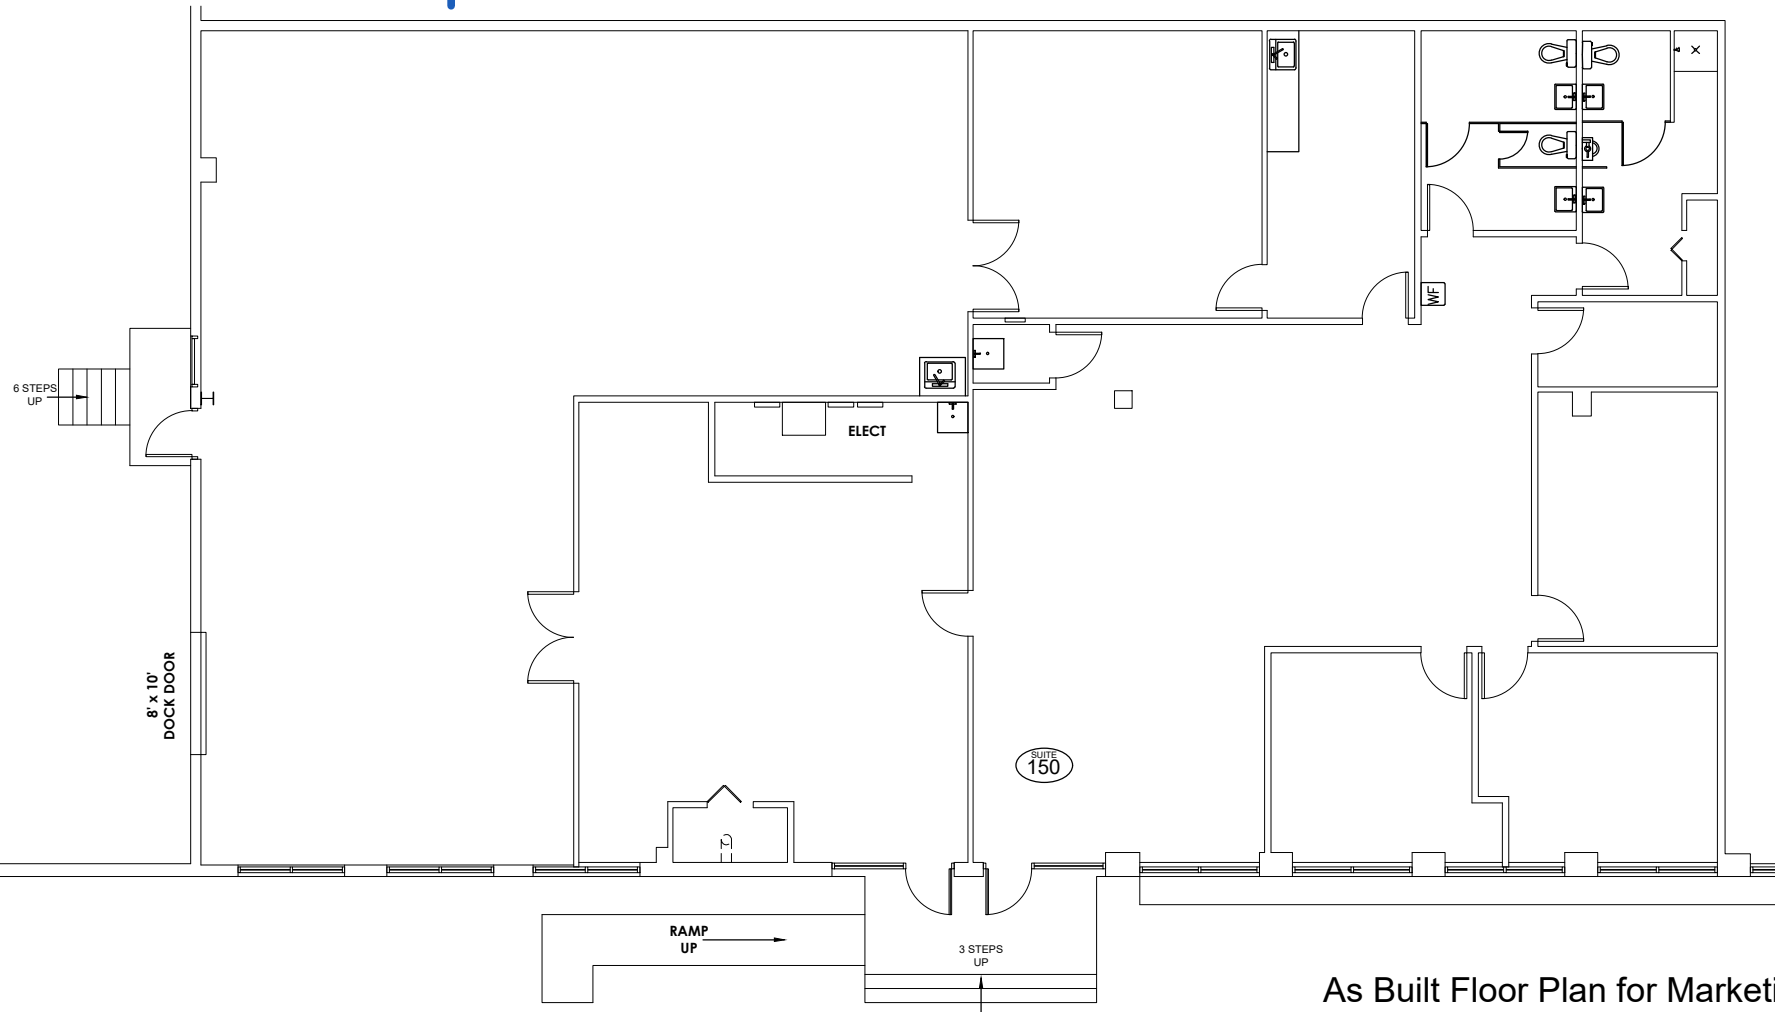

As Built Floor Plan for Marketing

