


N.T.S.

AS-BUILT FLOOR PLAN

SCALE: 1/4"=1'-0"

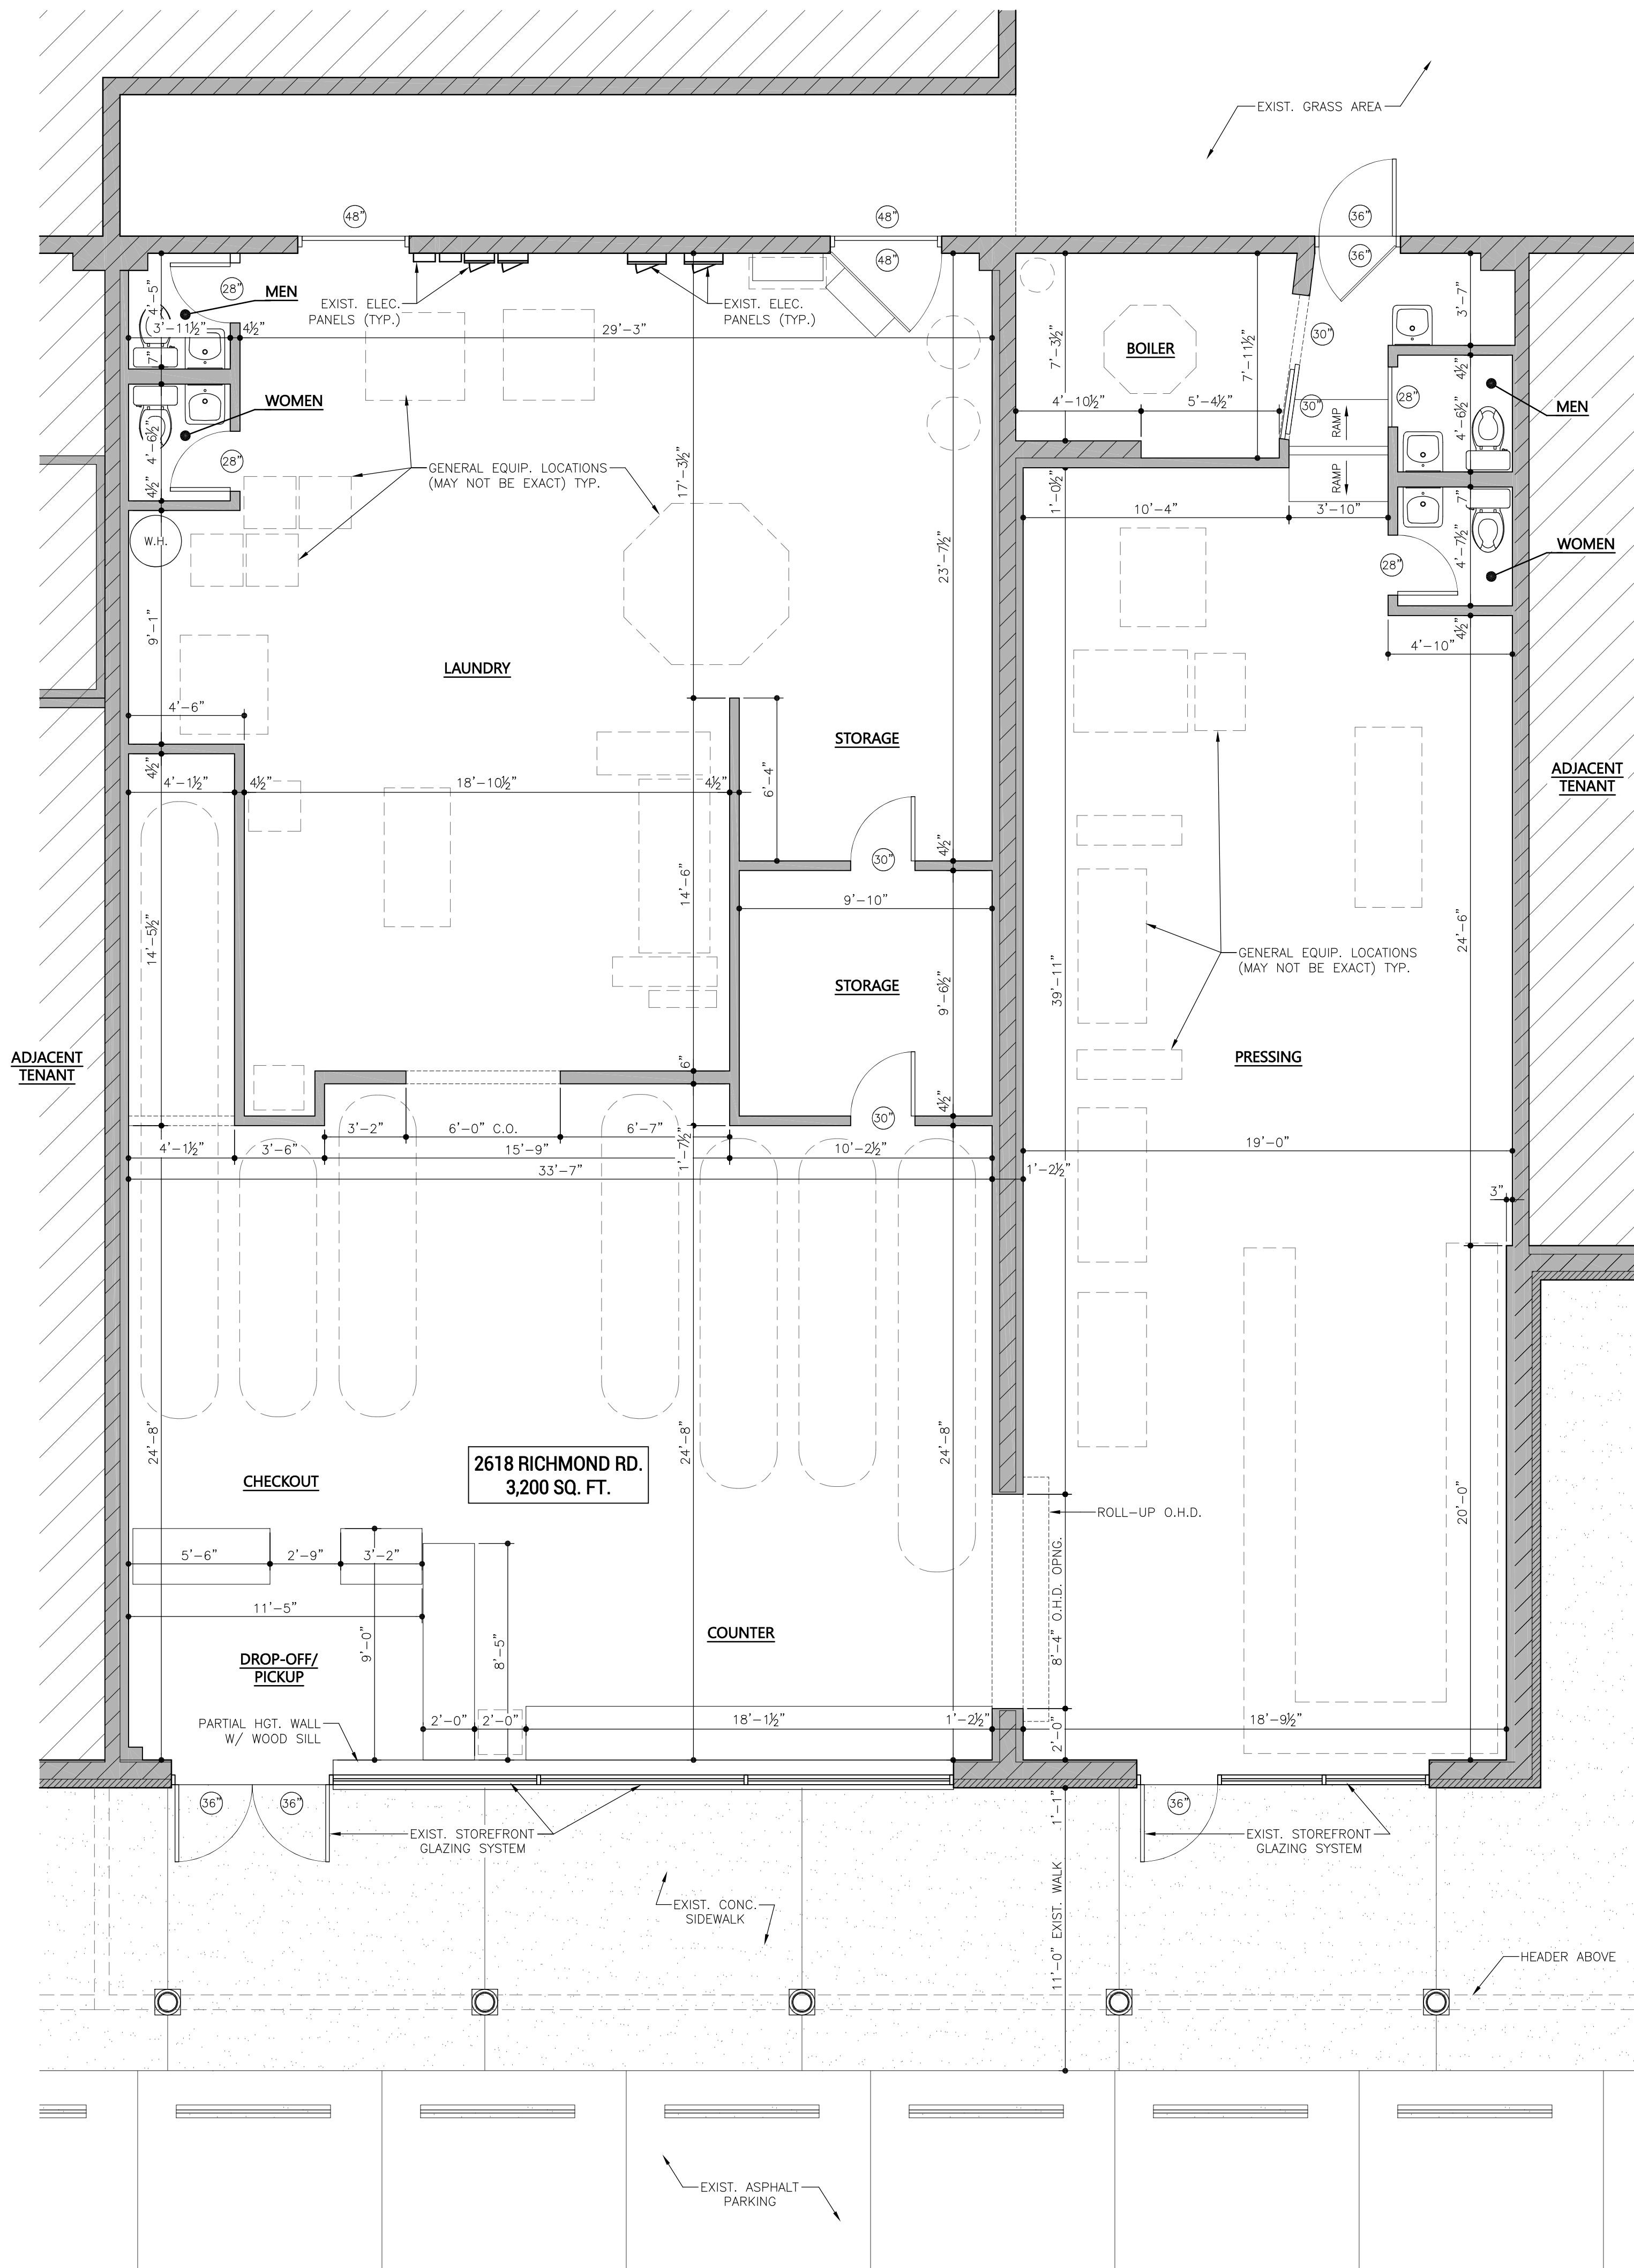

THESE ARE AS-BUILT DRAWINGS DRAWN AT THE REQUEST OF THE PROPERTY OWNER. THESE DRAWINGS ARE NOT TO BE USED FOR ANY OTHER PURPOSES. MEASUREMENTS, PHOTOS, ETC. THE BEST OF MY KNOWLEDGE THESE PLANS ARE DRAWN TO COMPLY WITH OWNER'S REQUEST AND ARE DRAWN VERY ACCURATELY. THERE ARE CERTAIN ELEMENTS WHEN DRAWING AS-BUILTS THAT AREN'T FULLY VERIFIABLE, SO AT TIMES CERTAIN ASSUMPTIONS ARE MADE. THE PROPERTY OWNER HAS BEEN ADVISED OF THIS. ANY CHANGES TO THESE PLANS WILL BE MADE IN WRITING. NO INFORMATION ON THE ENCLOSED DRAWINGS(CD) GROUP IS NOT LIABLE FOR ANY ERRORS OR OMISSIONS. WHILE EVERY EFFORT HAS BEEN MADE IN THE PREPARATION OF THESE PLANS TO AVOID MISTAKES, THE DESIGNER CANNOT BE RESPONSIBLE FOR ANY MISTAKES OR OMISSIONS. PLEASE NOTIFY AND GROUND ANY ITEM IS REQUIRED ON THE DRAWINGS.

REVISIONS/RELEASES:

INFO:	
DRAWN BY:	CES
CHKD. BY:	—
DATE:	22 AUG 2025
SCALE:	AS NOTED

CG PROJECT: 25609

CG PROJECT: 25609


**PAM'S DRY CLEANERS
2618 RICHMOND ROAD
RICHMOND ROAD PLAZA
LEXINGTON, KY 40509**



Equity
Management
Group, Inc.

840 EAST HIGH STREET, LEXINGTON, KY 40502 . 859.266.1414

DRAWN BY:

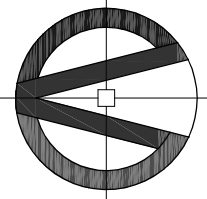

CAD Group
208 Percheron Drive
Richmond, KY 40475
cell: 859.582.2029
email: info@cadgroup.biz