



# Arapaho Business Park

1300 E. Arapaho, Richardson, TX

Suite: 308


Scale: Not to Scale  
Sheet Size: 42" x 30"  
Not For Construction



# BAY SPACE

## Rentable Square Foot Analysis

|                |       |      |
|----------------|-------|------|
| Office Area    | 3,437 | 42 % |
| Warehouse Area | 4,103 | 58%  |
| Total Area     | 7,540 |      |

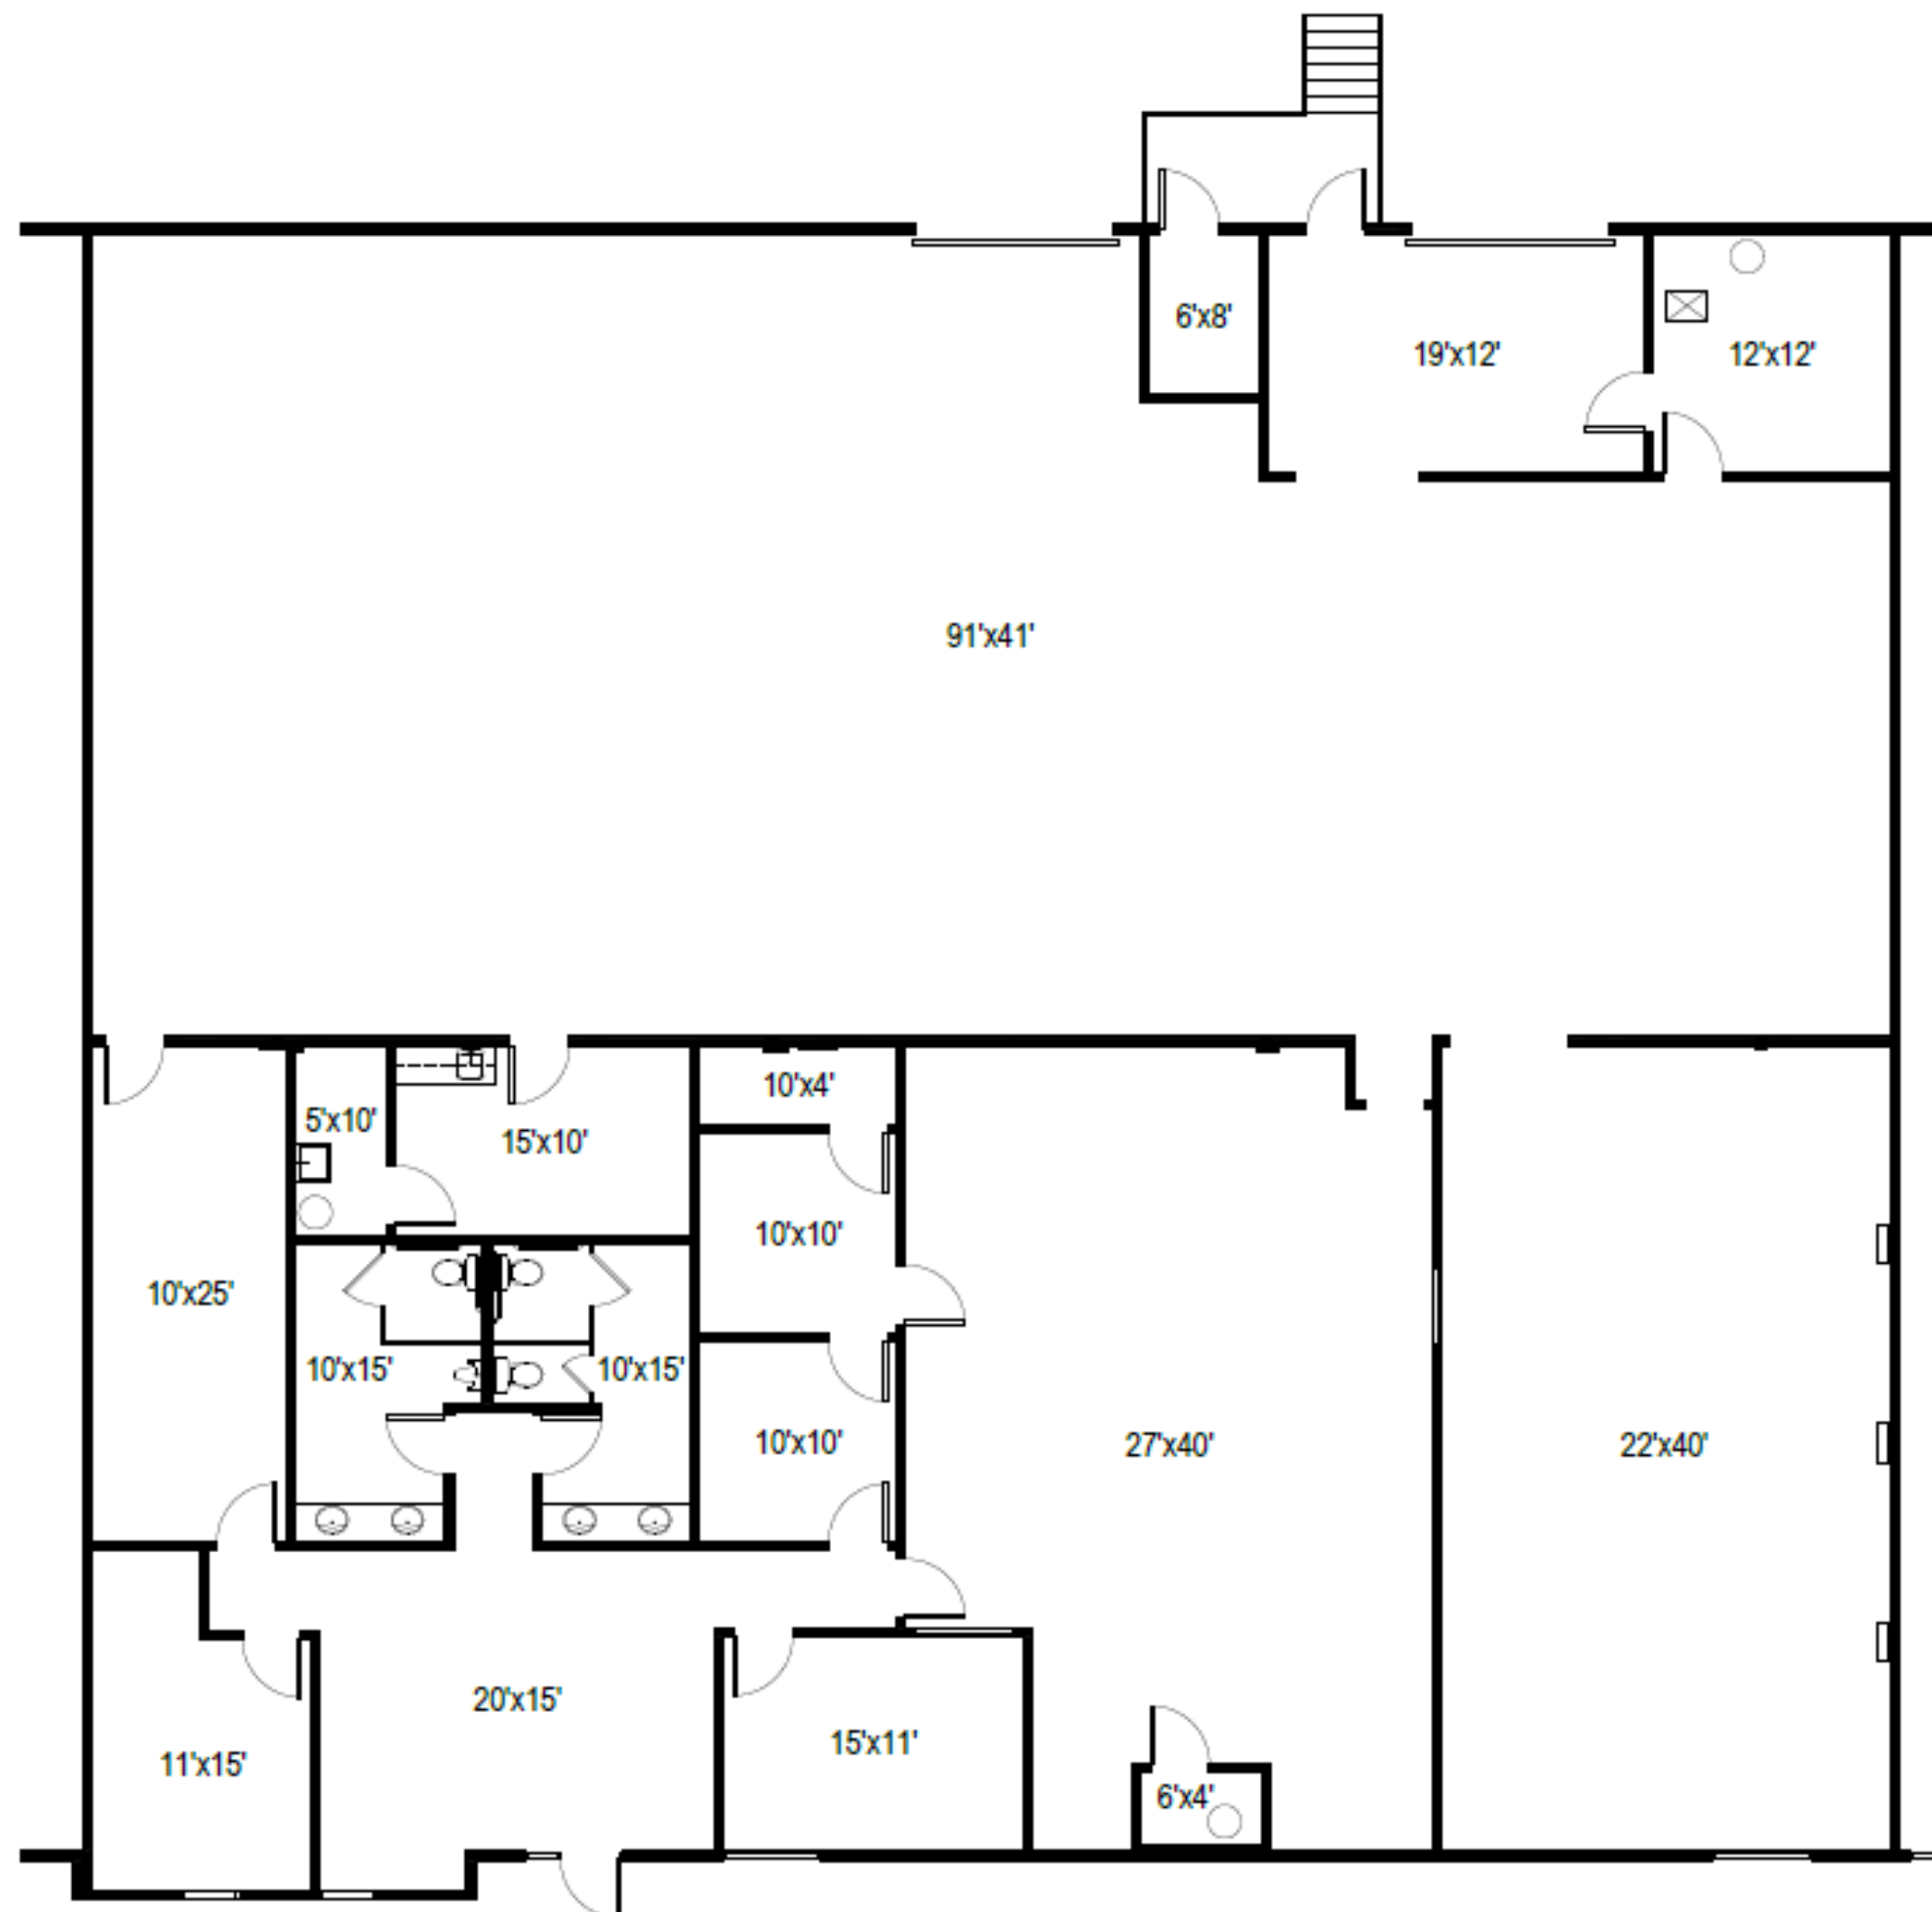

As Built Floor Plan for Marketing

