



1ST FLOOR
AS BUILT PLAN
SCALE: 3/16" = 1'-0"

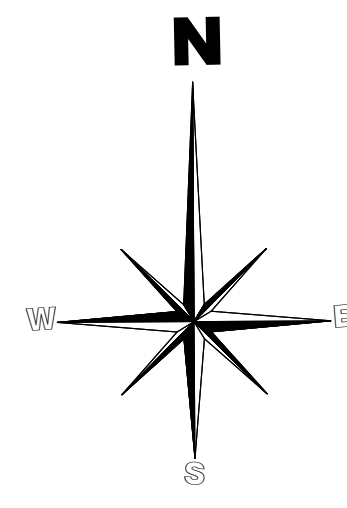

MEZZANINE FLOOR
AS BUILT PLAN
SCALE: 3/16" = 1'-0"

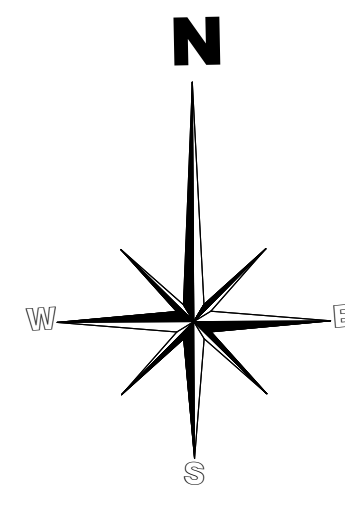


DATE:	09/22/2022
JOB No.:	
DRAWING BY:	TJ
CHK BY:	
DWG No.:	A-001.00

No.	REVISION COMMENT	DATE

PROJECT ADDRESS
**1611 E NEW YORK AVE
 BROOKLYN, NY, 11212
 BLOCK: 1455, LOT: 50**

SHEET TITLE
**1ST FLOOR AND
 MEZZANINE AS
 BUILT PLANS**

ENGINEER

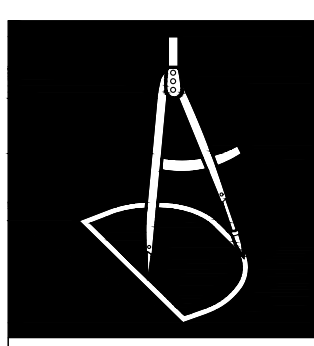

**AVALON
DESIGNS**

DESIGN AND
CONSULTING SERVICES

2023 80TH STREET 1F
 BROOKLYN, NY 11234
 PH: 718.236.8000
 FAX: 718.236.8002
 EMAIL: INFO@AVALONDESIGNINC.COM

