


SCHEDULE A

PREMISES

CMC
Suite 204

↑ DENOTES TO DECK ABOVE
W/ 2 1/2" SOUND BATT'S

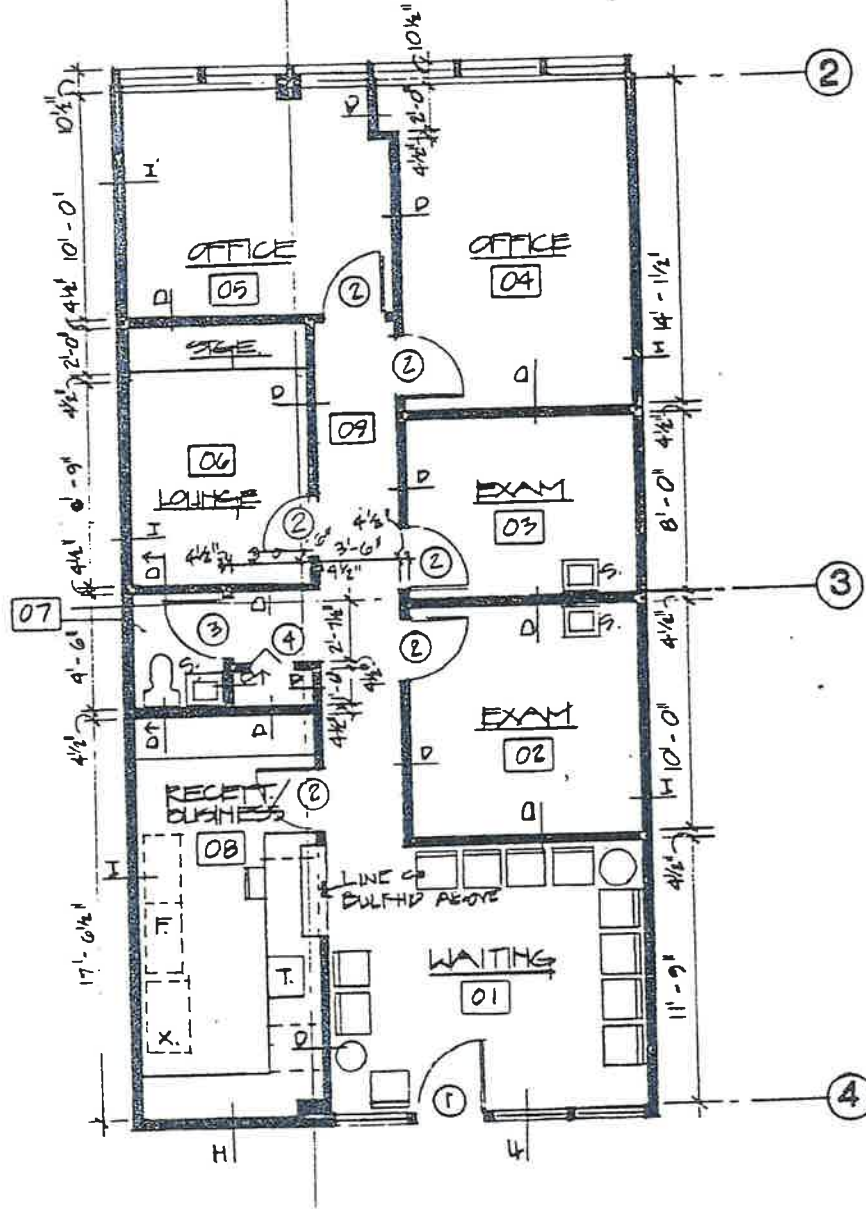

ARCHITECTURAL PLAN

SCALE: 1/8" = 1'-0"

