


2nd Floor As-Built

SUITE	SF	AVAILABLE	NOTES
205	4,745 RSF	Sept 1, 2026	Spec Suite Planned

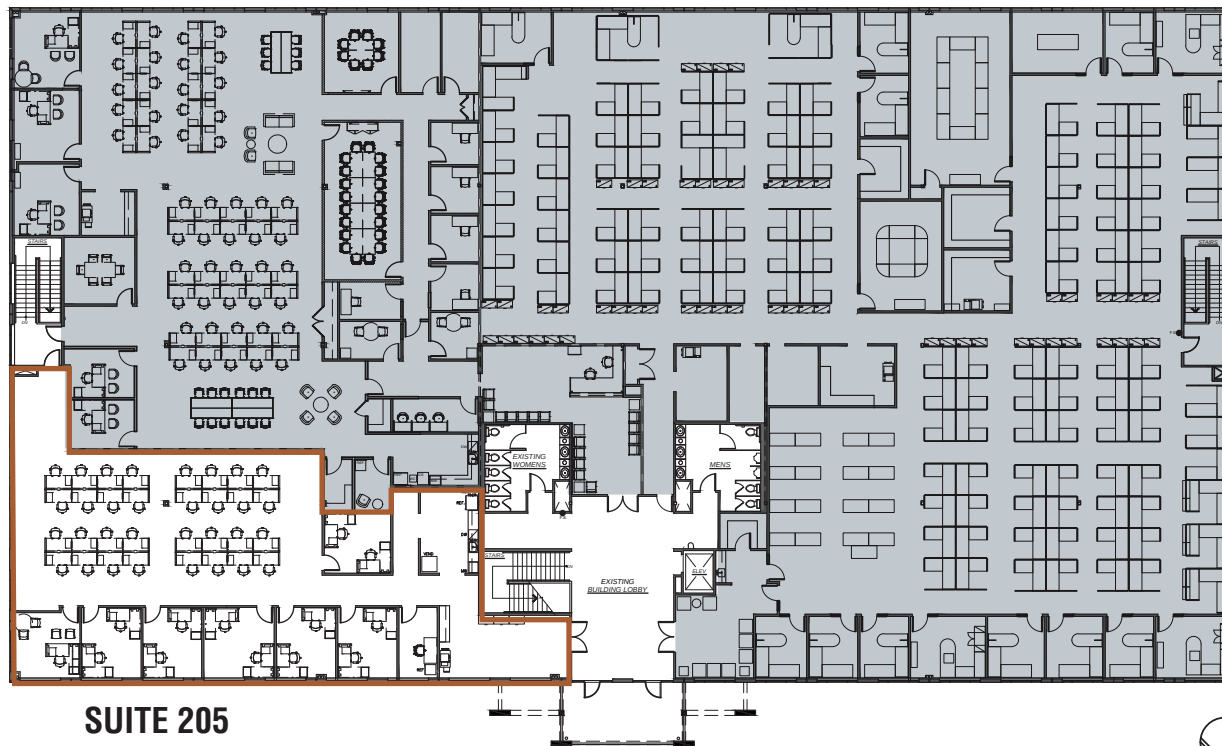

SUITE 205

