


1100 Arizona State Route 260

Cottonwood - Arizona
Suite D12 - 3,968 SF

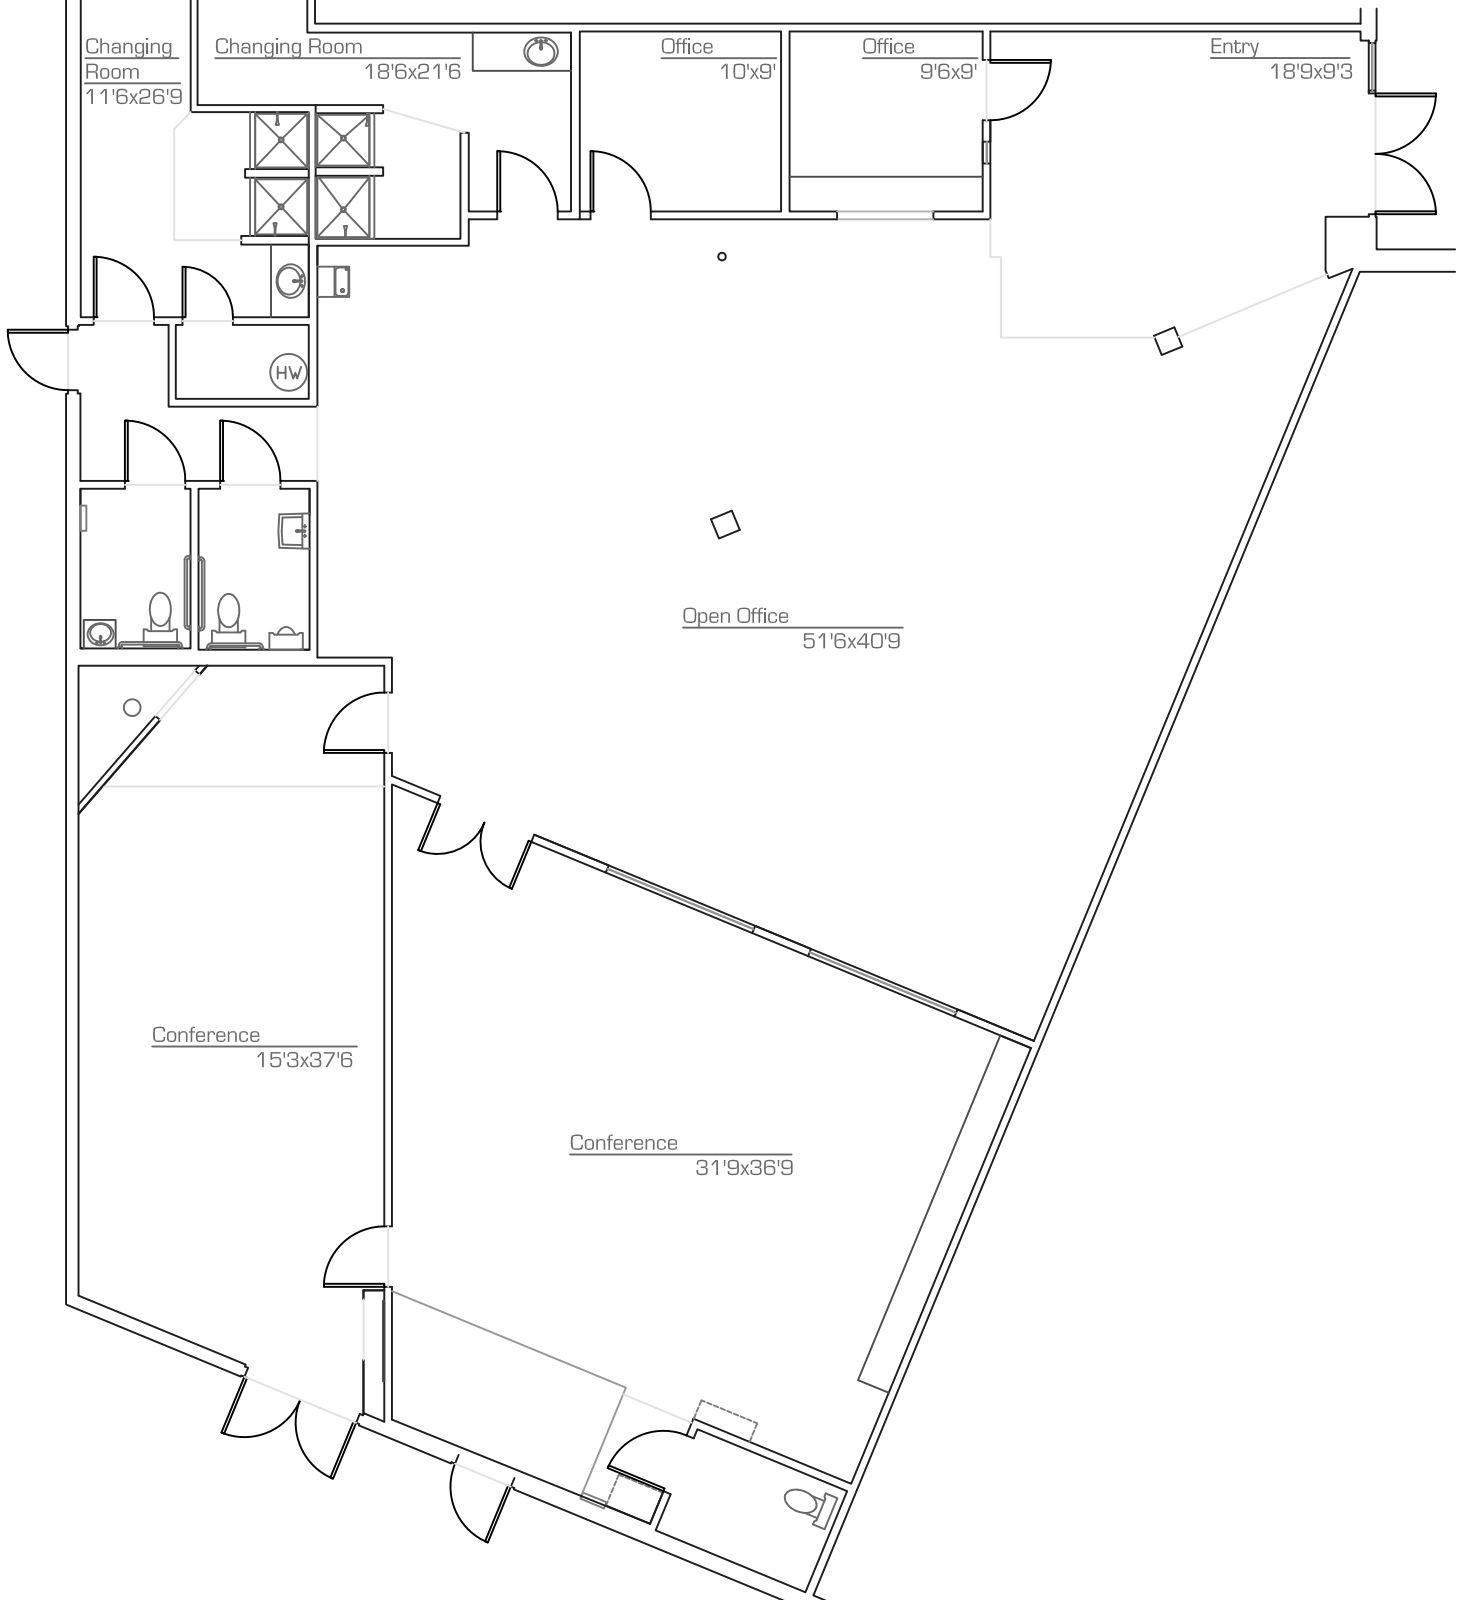


as-built

scale: nts
November . 2010

*All dimensions are approximate
*All information is of general nature

precision**DIMENSIONS**

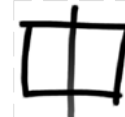

as built . space plans
architectural design

602.790.6412